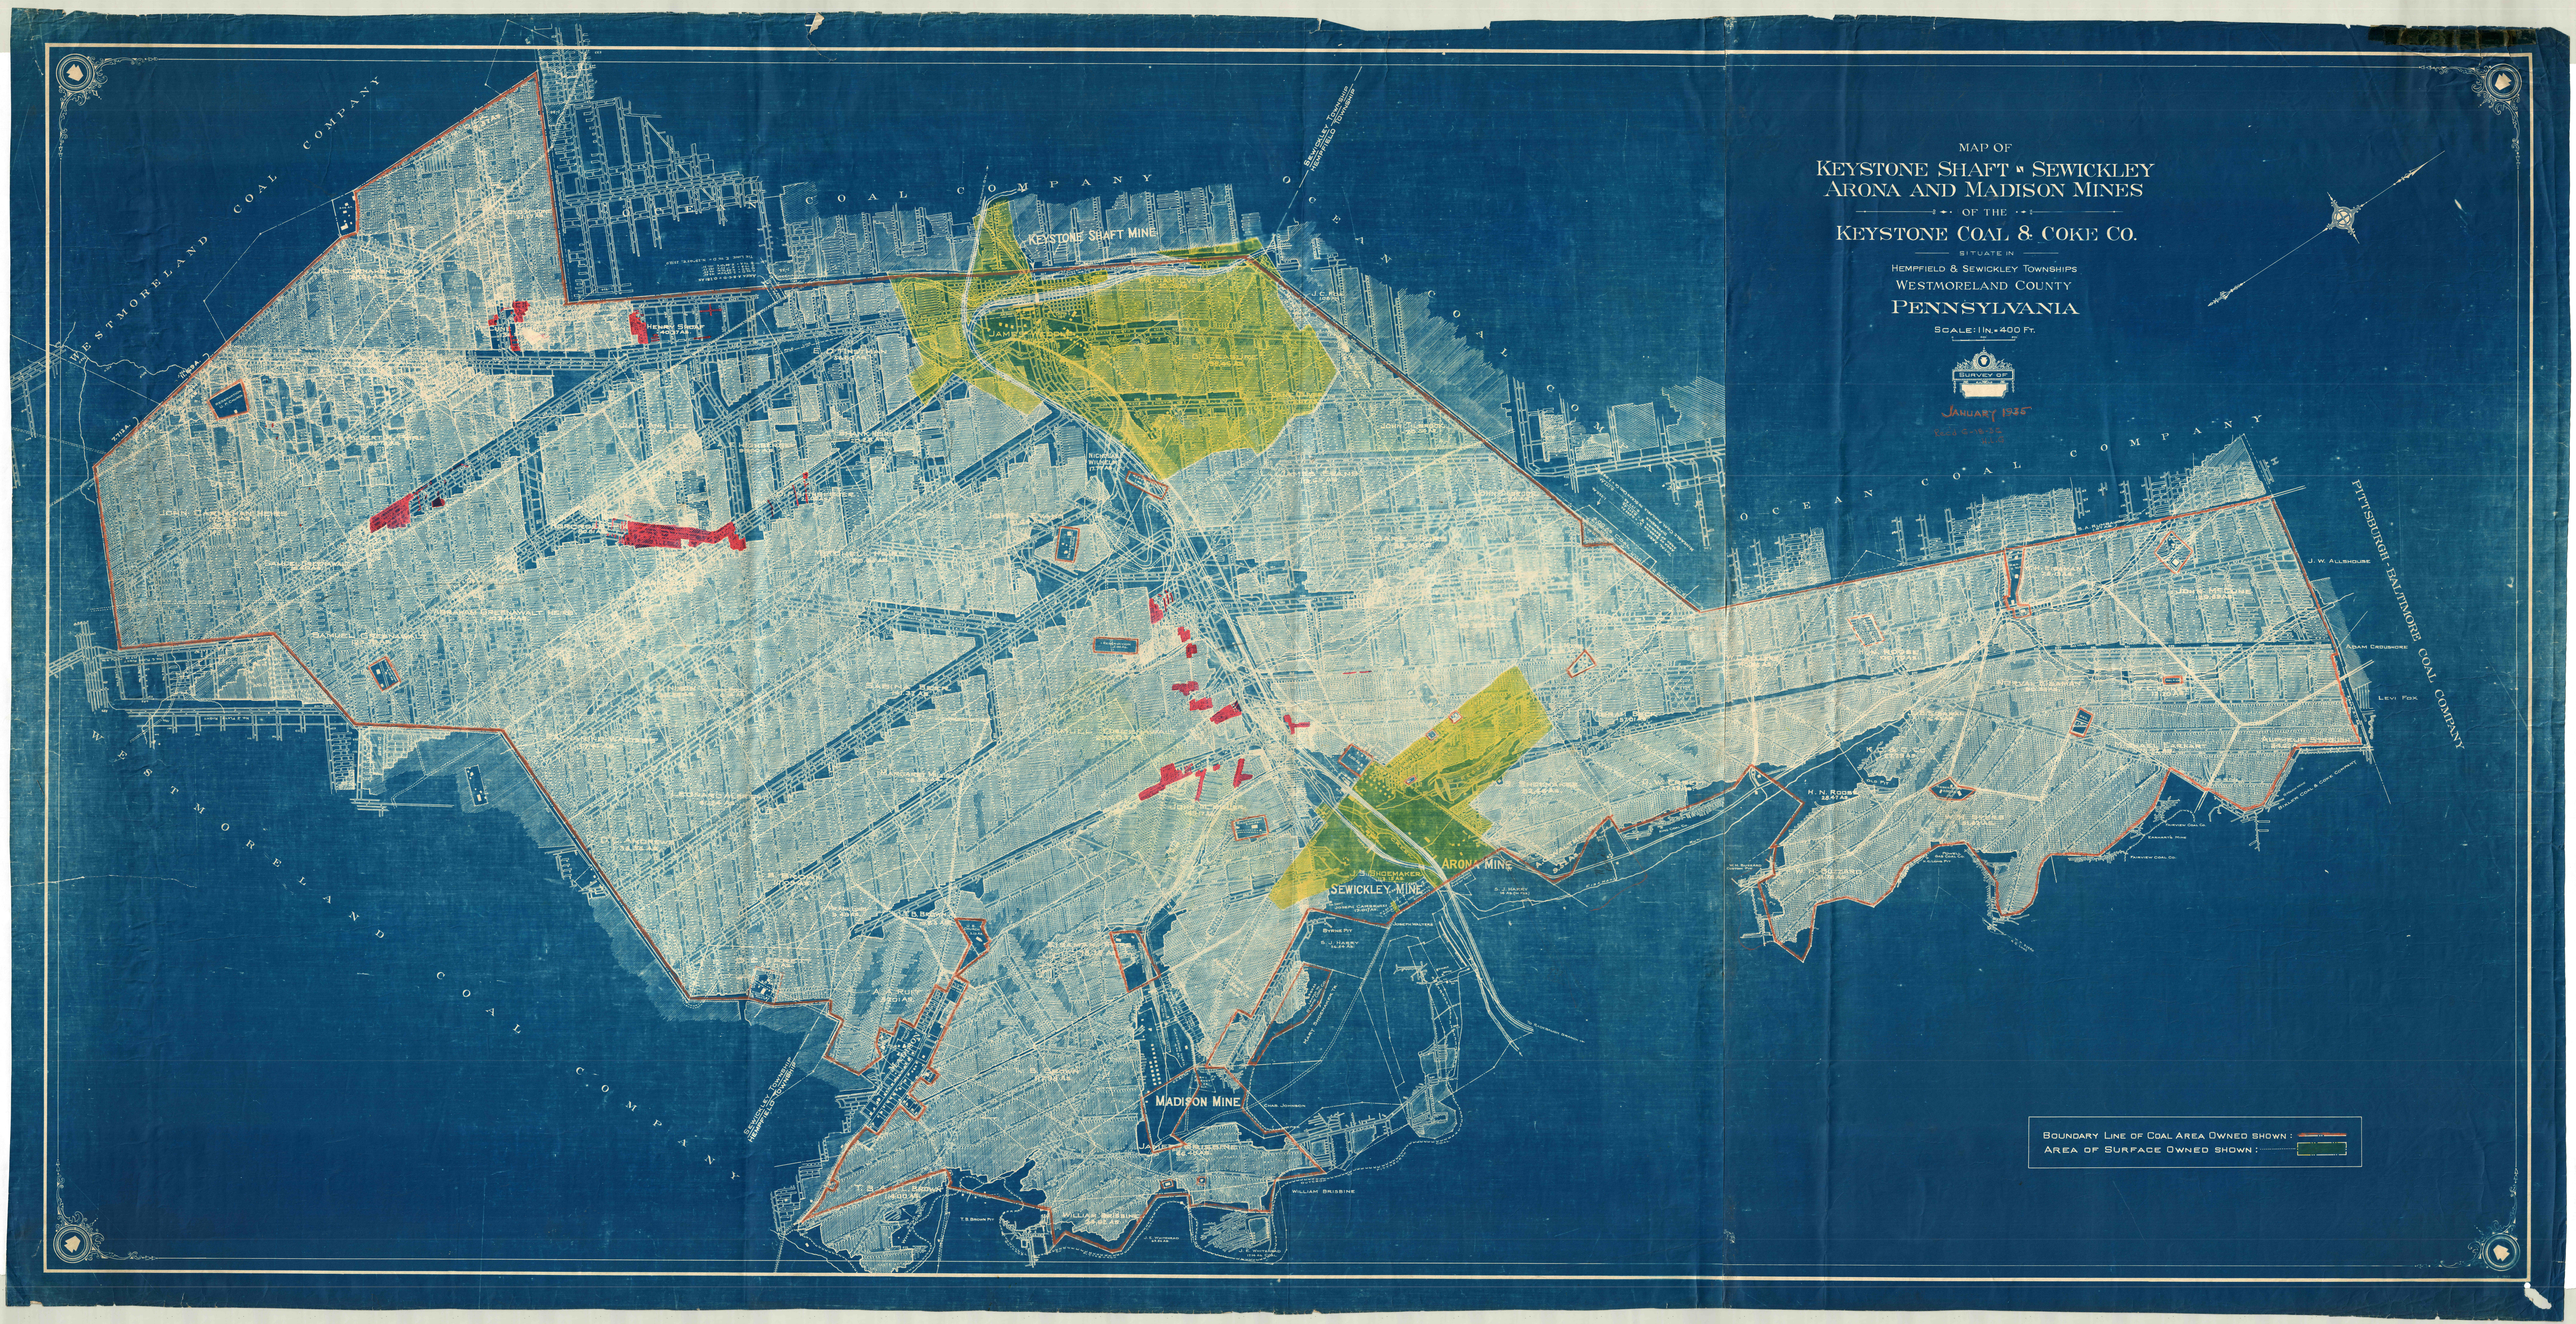
MAP OF
KEYSTONE SHAFT & SEWICKLEY
ARONA AND MADISON MINES
OF THE
KEYSTONE COAL & COKE CO.
SITUATE IN
HEMPFIELD & SEWICKLEY TOWNSHIPS
WESTMORELAND COUNTY
PENNSYLVANIA
SCALE: 1 IN. = 400 FT.
SURVEY OF
JANUARY 1906
KEYSTONE SHAFT MINE
ARONA MINE
SEWICKLEY MINE
MADISON MINE
WESTMORELAND COAL COMPANY
OCEAN COAL COMPANY
PITTSBURGH - BALTIMORE COAL COMPANY
BOUNDARY LINE OF COAL AREA OWNED SHOWN :
AREA OF SURFACE OWNED SHOWN :