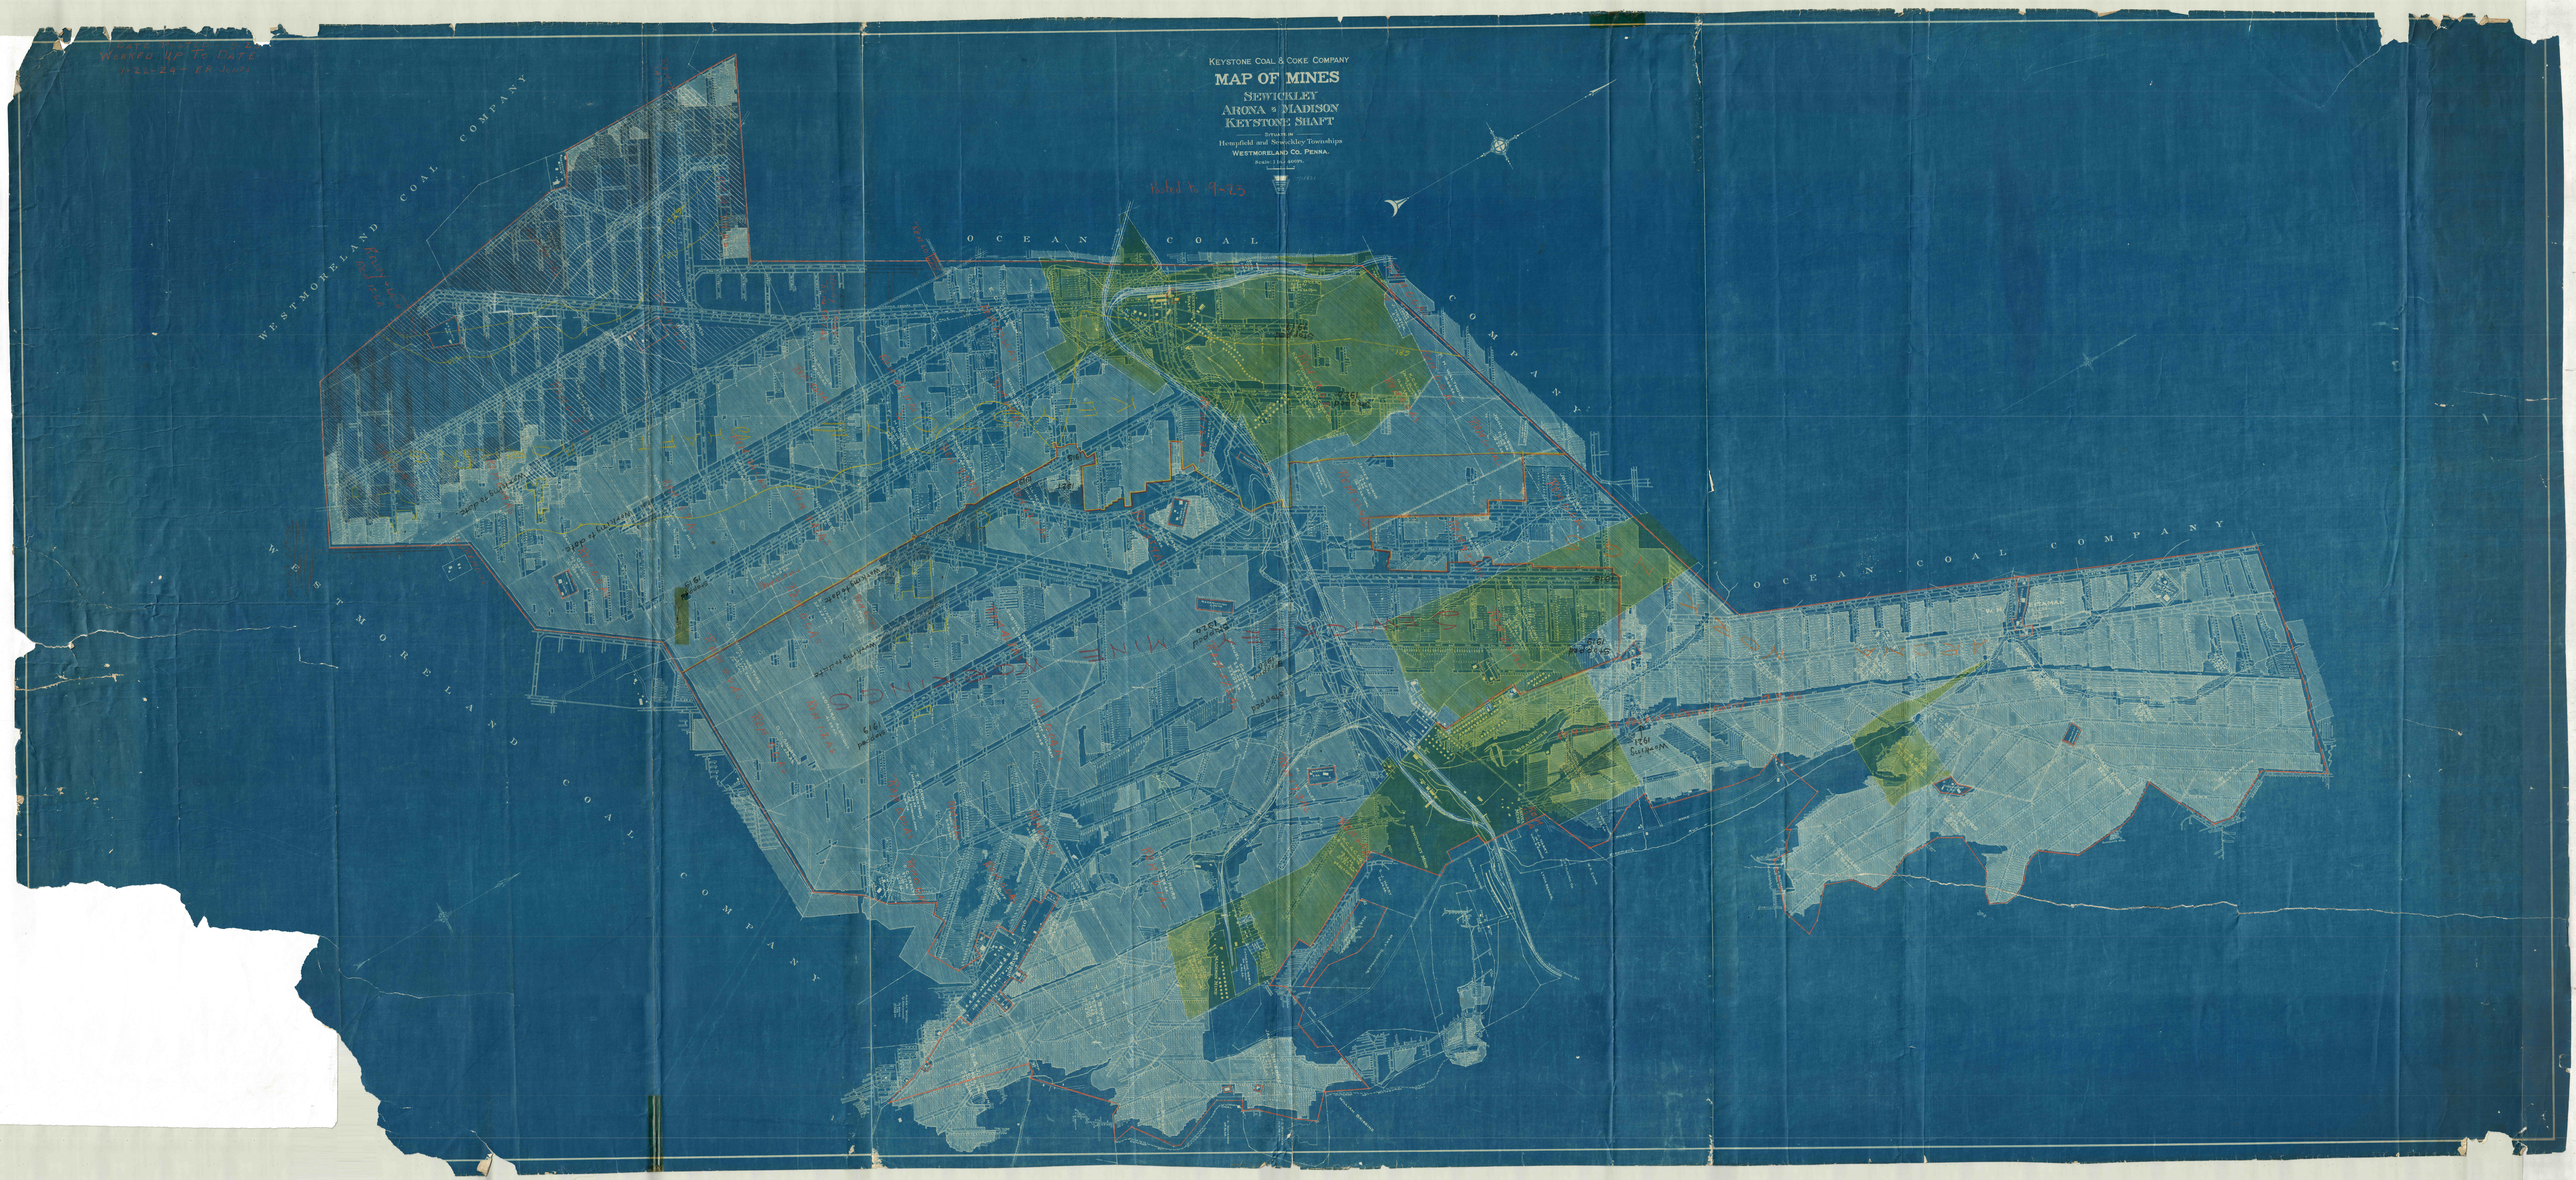
Keystone Coal & Coke Company
MAP OF MINES
Sewickley
Arona & Madison
Keystone Shaft
Situate in
Hempfield and Sewickley Townships
Westmoreland Co. Penna.
Scale 1 in. = 400 ft.
Posted to 9-25
Worked Up To Date
12-21-24 EN Scott
WESTMORELAND COAL COMPANY
OCEAN COAL COMPANY
Slope #1 Connellsville
Slope #2 Connellsville
