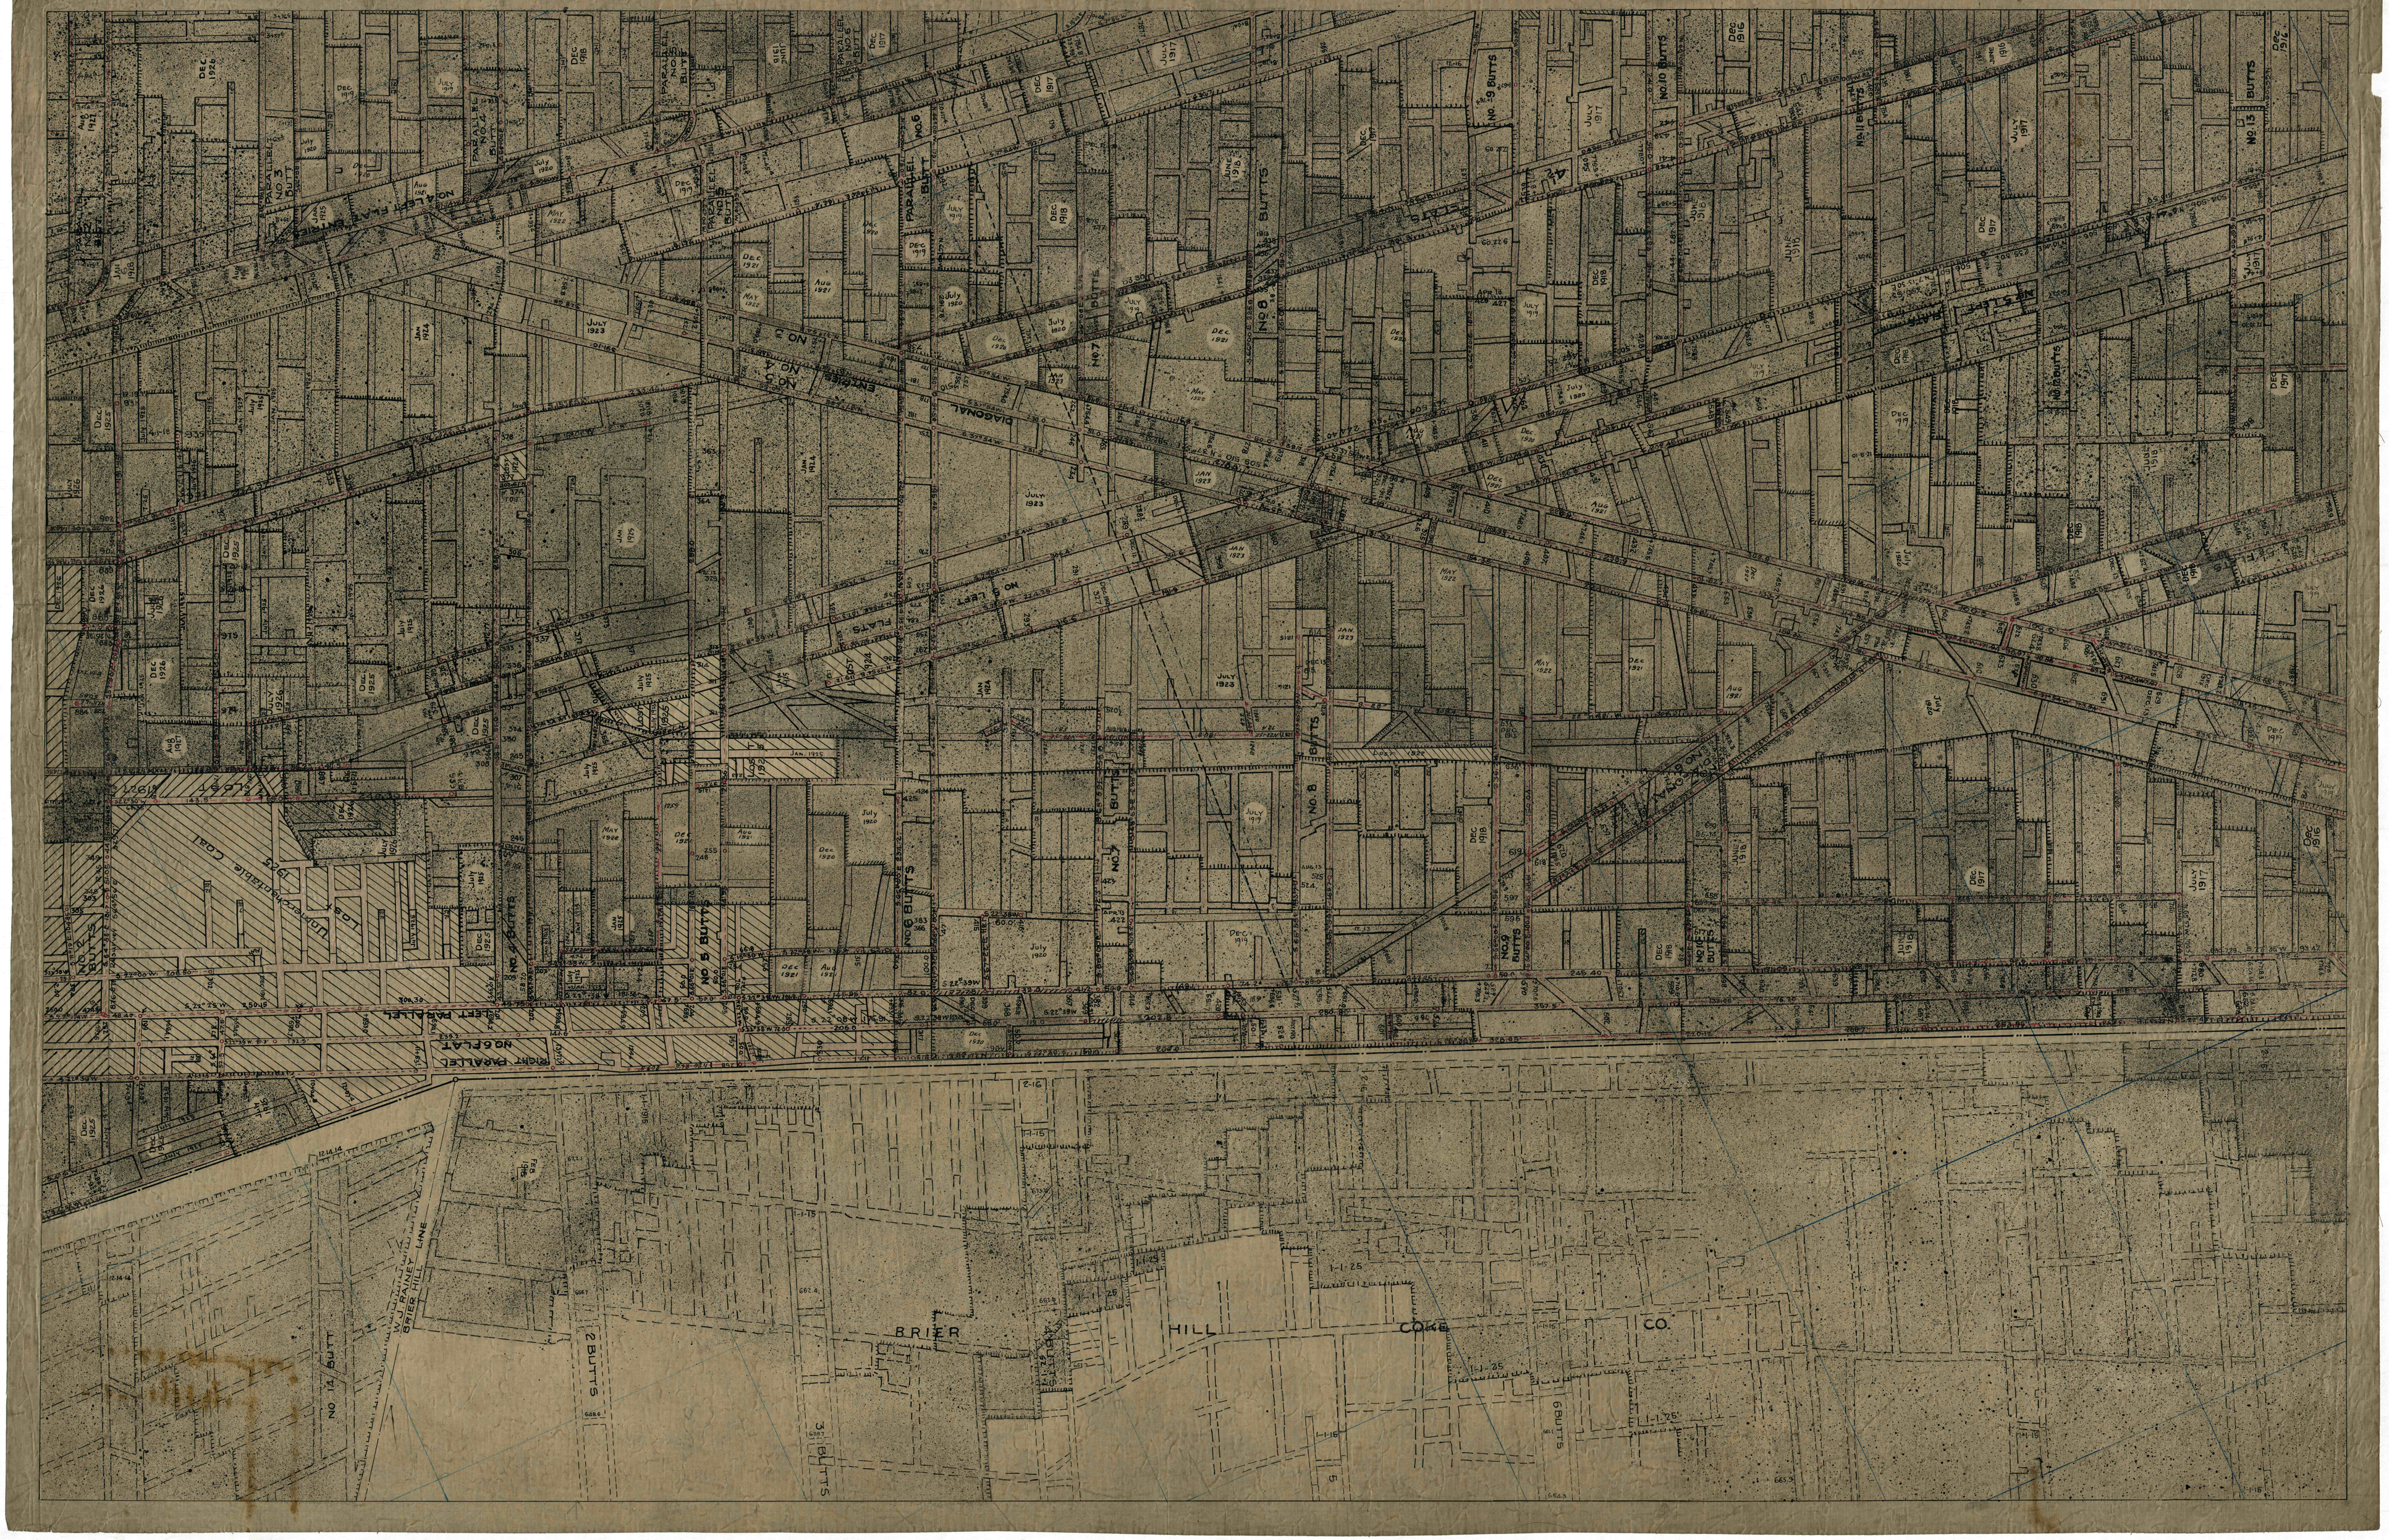
PARALLEL No 3 BUTTS
PARALLEL No 4 BUTTS
PARALLEL No 5 BUTTS
PARALLEL No 6 BUTTS
No 7 BUTTS
No 8 BUTTS
No 9 BUTTS
No 10 BUTTS
No 11 BUTTS
No 13 BUTTS
NORTH FLINT BUTTS
No 3
No 4
No 5
DIAGONAL
No 5 LEFT
FLATTS
No 8 DIAGONAL
No 2 BUTTS
No 3 BUTTS
No 4 BUTTS
No 5 BUTTS
No 6 BUTTS
No 7 BUTTS
No 8 BUTTS
No 9 BUTTS
No 11 BUTTS
No 12 BUTTS
Upper Freeport Coal
RIGHT PARALLEL
NO 6 FLATT
RIGHT PARALLEL
W.J. RAILWAY
BRIER HILL LINE
BRIER
HILL
COAL
CO.