SHEET № 4

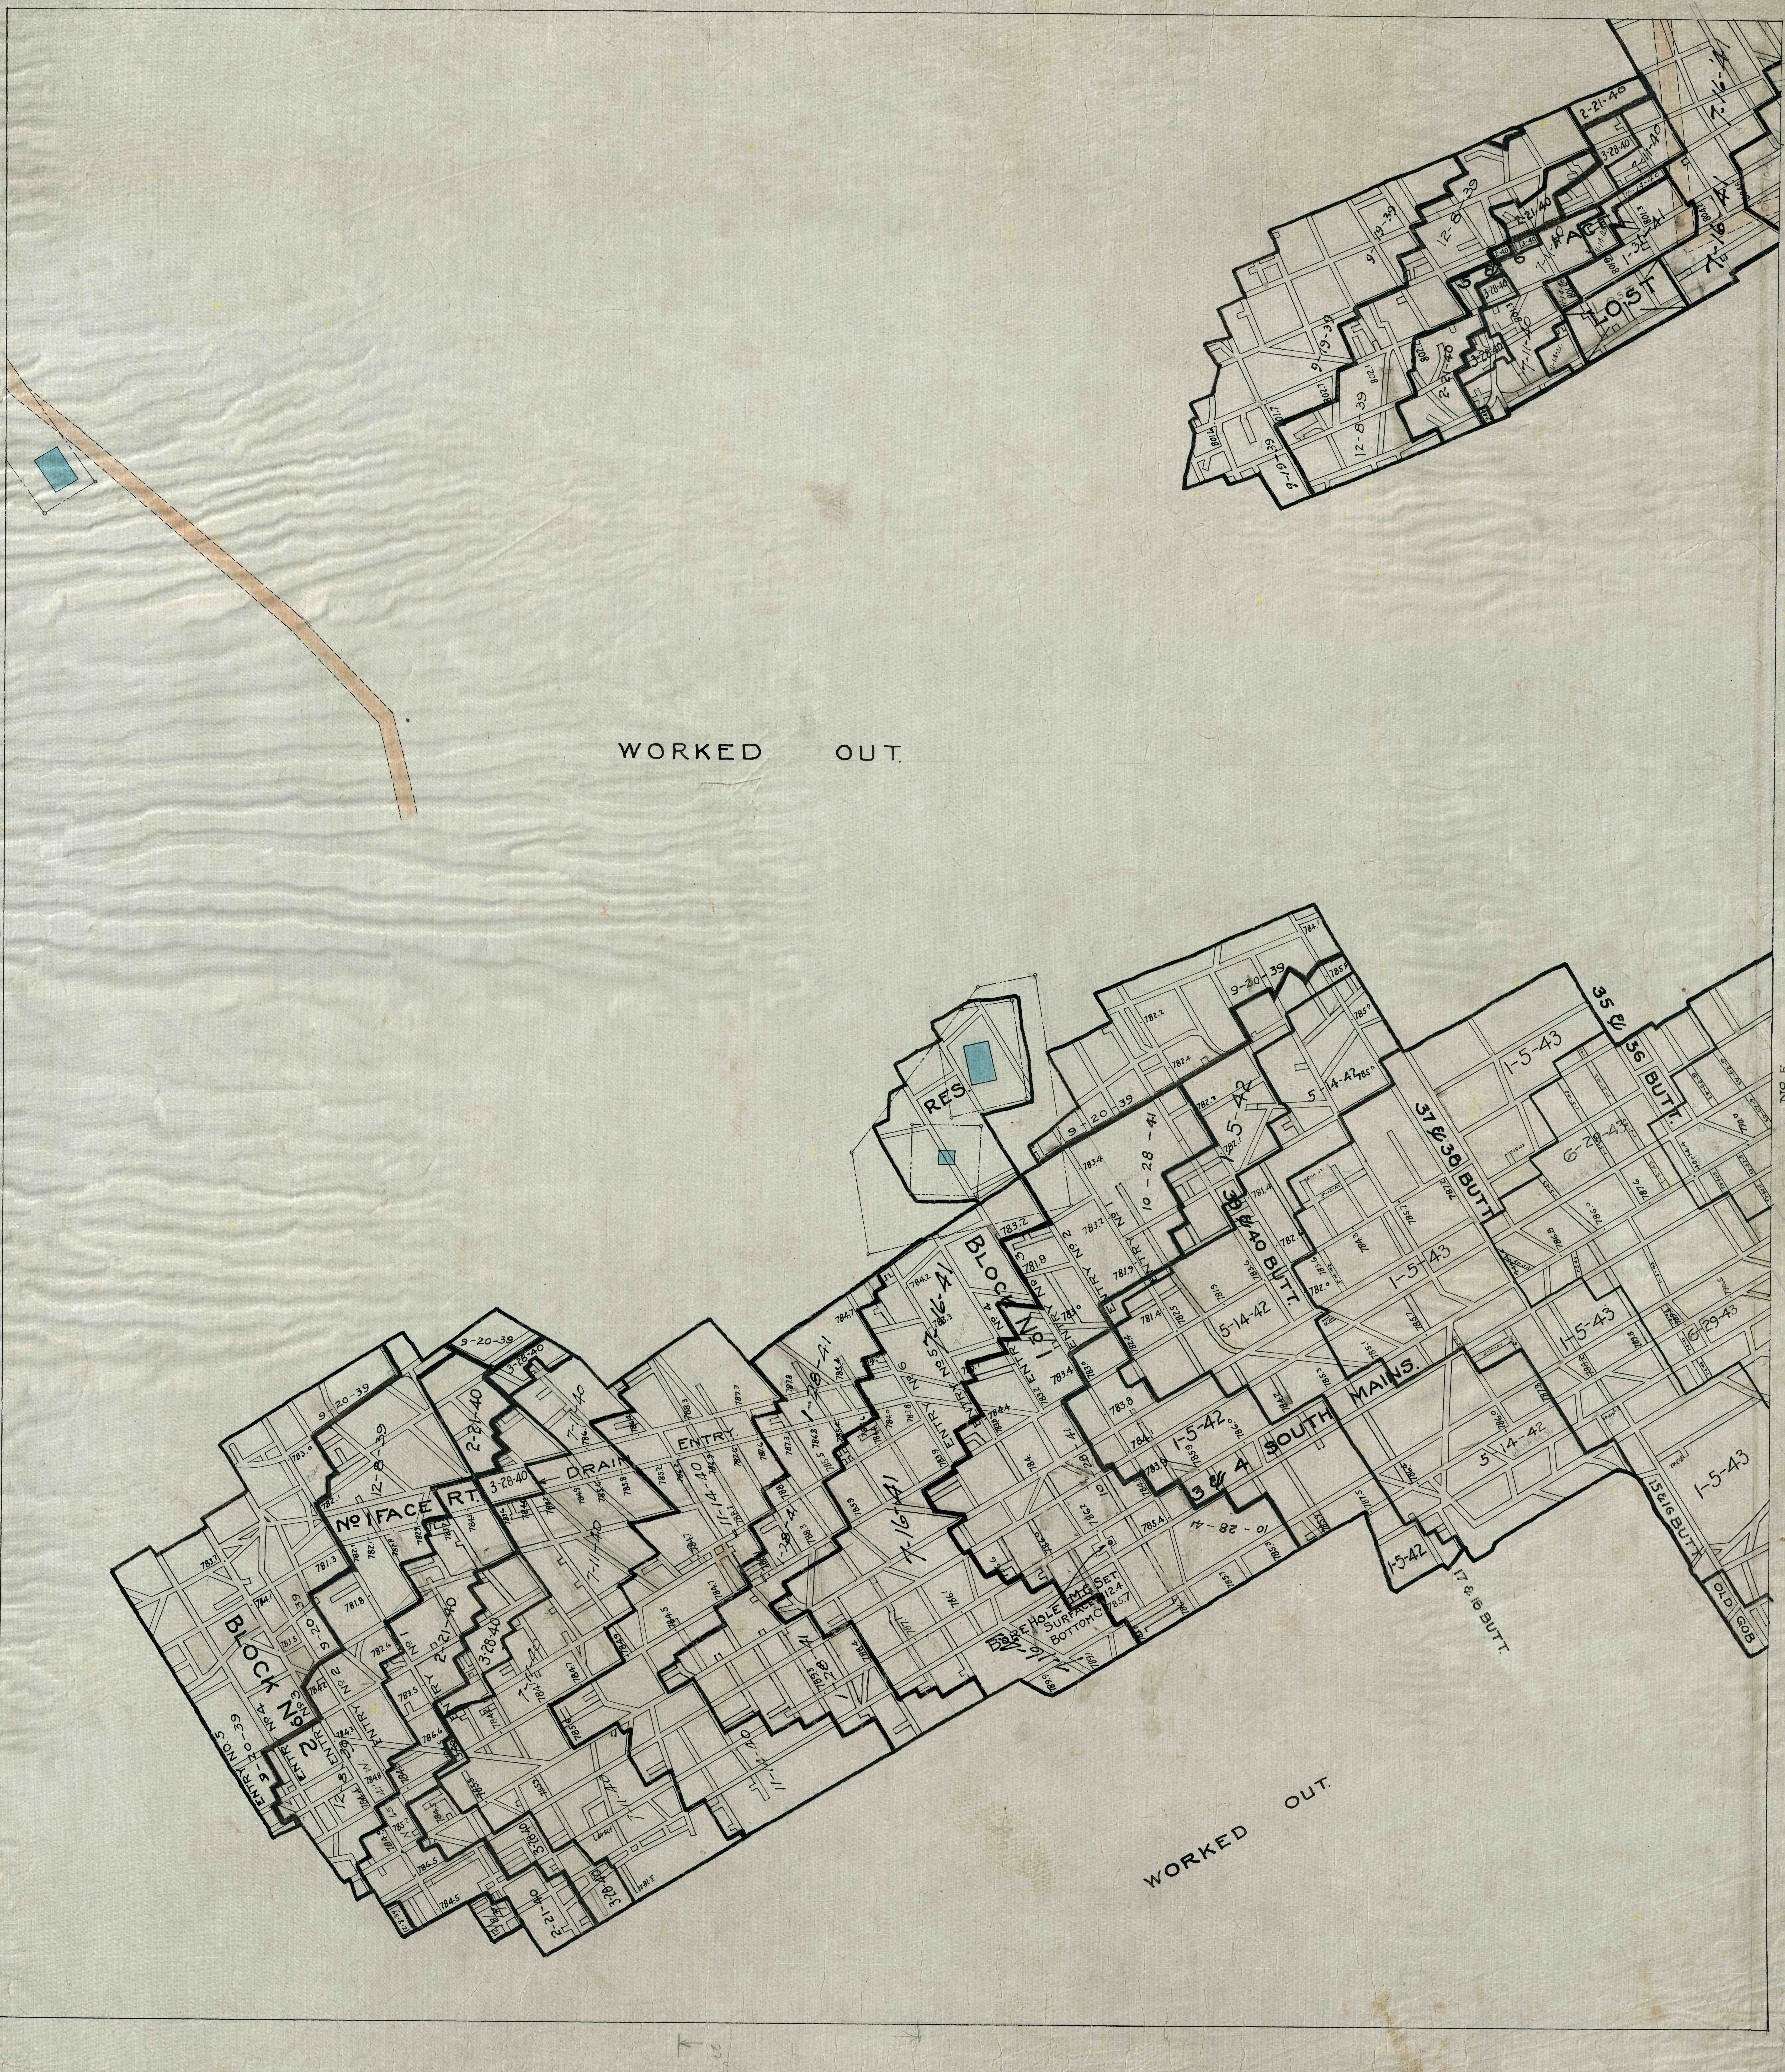
WORKED OUT.
WORKED OUT.
RES.
BLOCK № 1
BLOCK № 2
№ 1 FACE RT.
DRAIN
ENTRY
3 & 4 SOUTH MAINS.
37 & 38 BUTT.
35 & 36 BUTT.
39 & 40 BUTT.
15 & 16 BUTT.
17 & 18 BUTT.
OLD GOB
FACE
LOST
BORE HOLE M.G. SET.
SURFACE 812.4
BOTTOM C. 785.7
ENTRY NO. 5
ENTRY № 4
ENTRY № 3
ENTRY № 2
ENTRY № 1
ENTRY № 6
ENTRY № 5
1-5-43
6-29-43
5-14-42
1-5-42
10-28-41
9-20-39
12-8-39
2-21-40
3-28-40
9-19-39

№ 5