


WORKED OUT.

WORKED OUT.

WORKED OUT.

WORKED OUT.

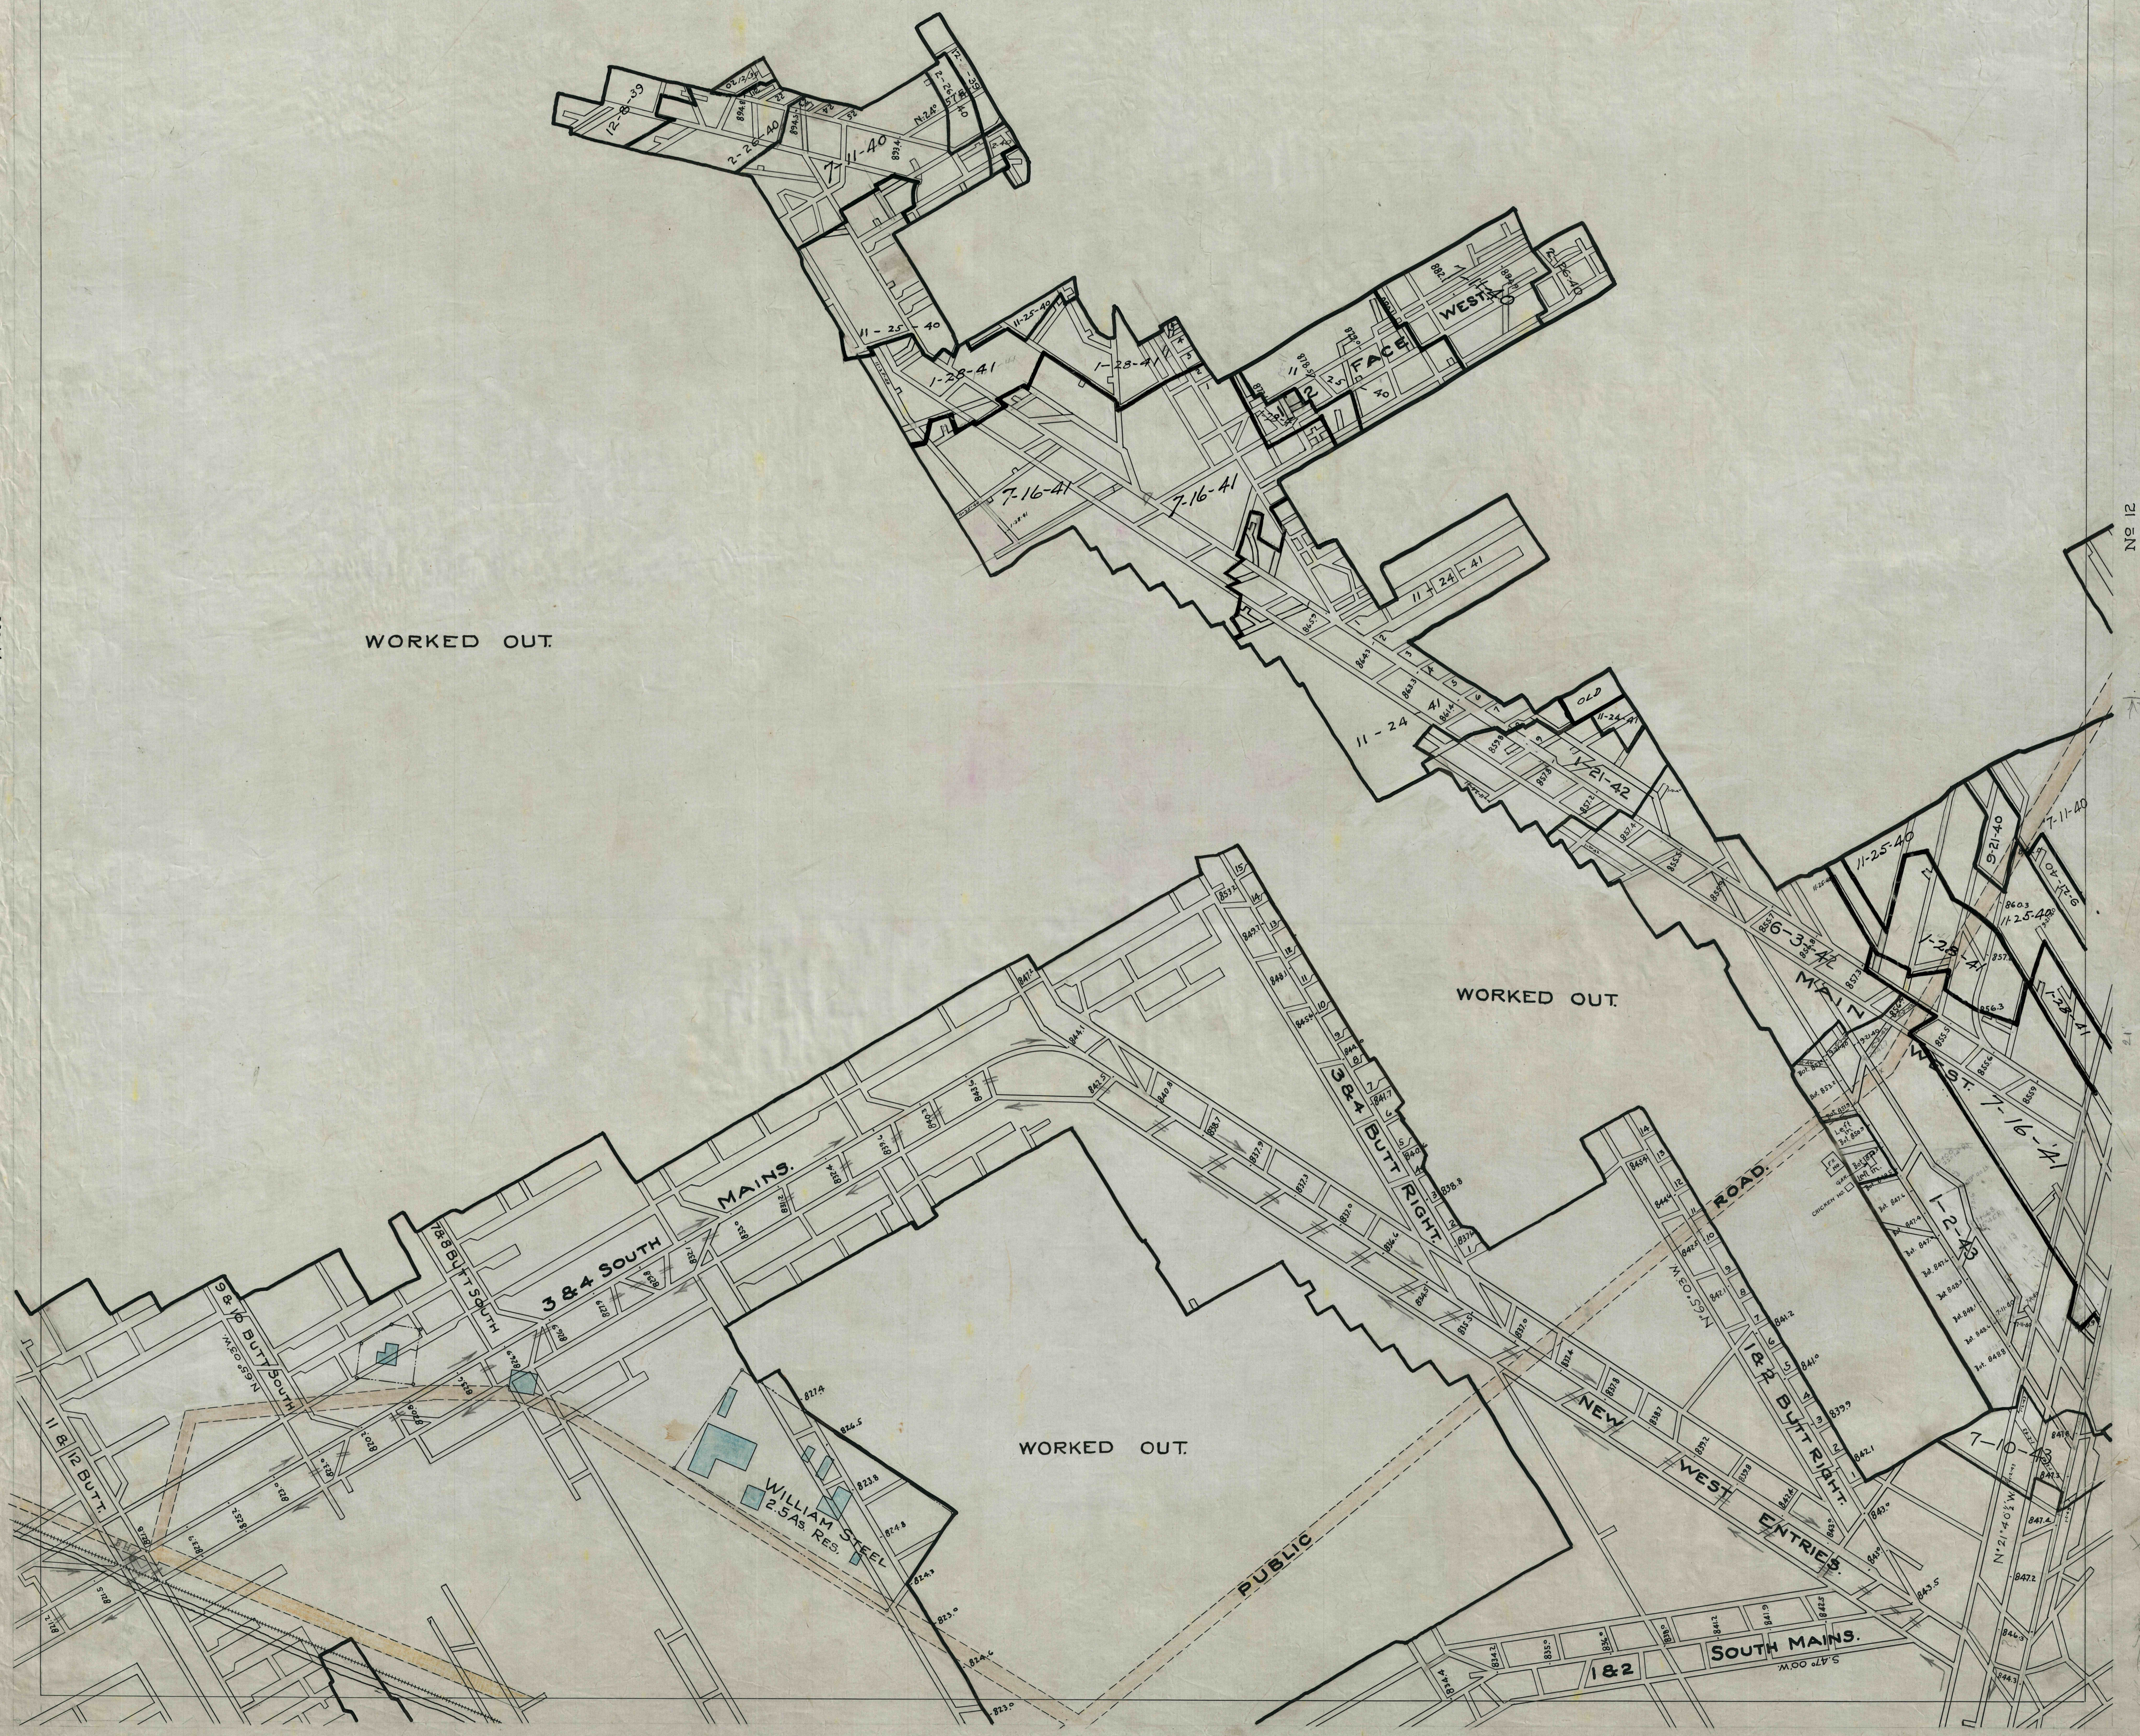

No 14

No 12

#13

No 6

SHEET No 13