


Luxor Projection

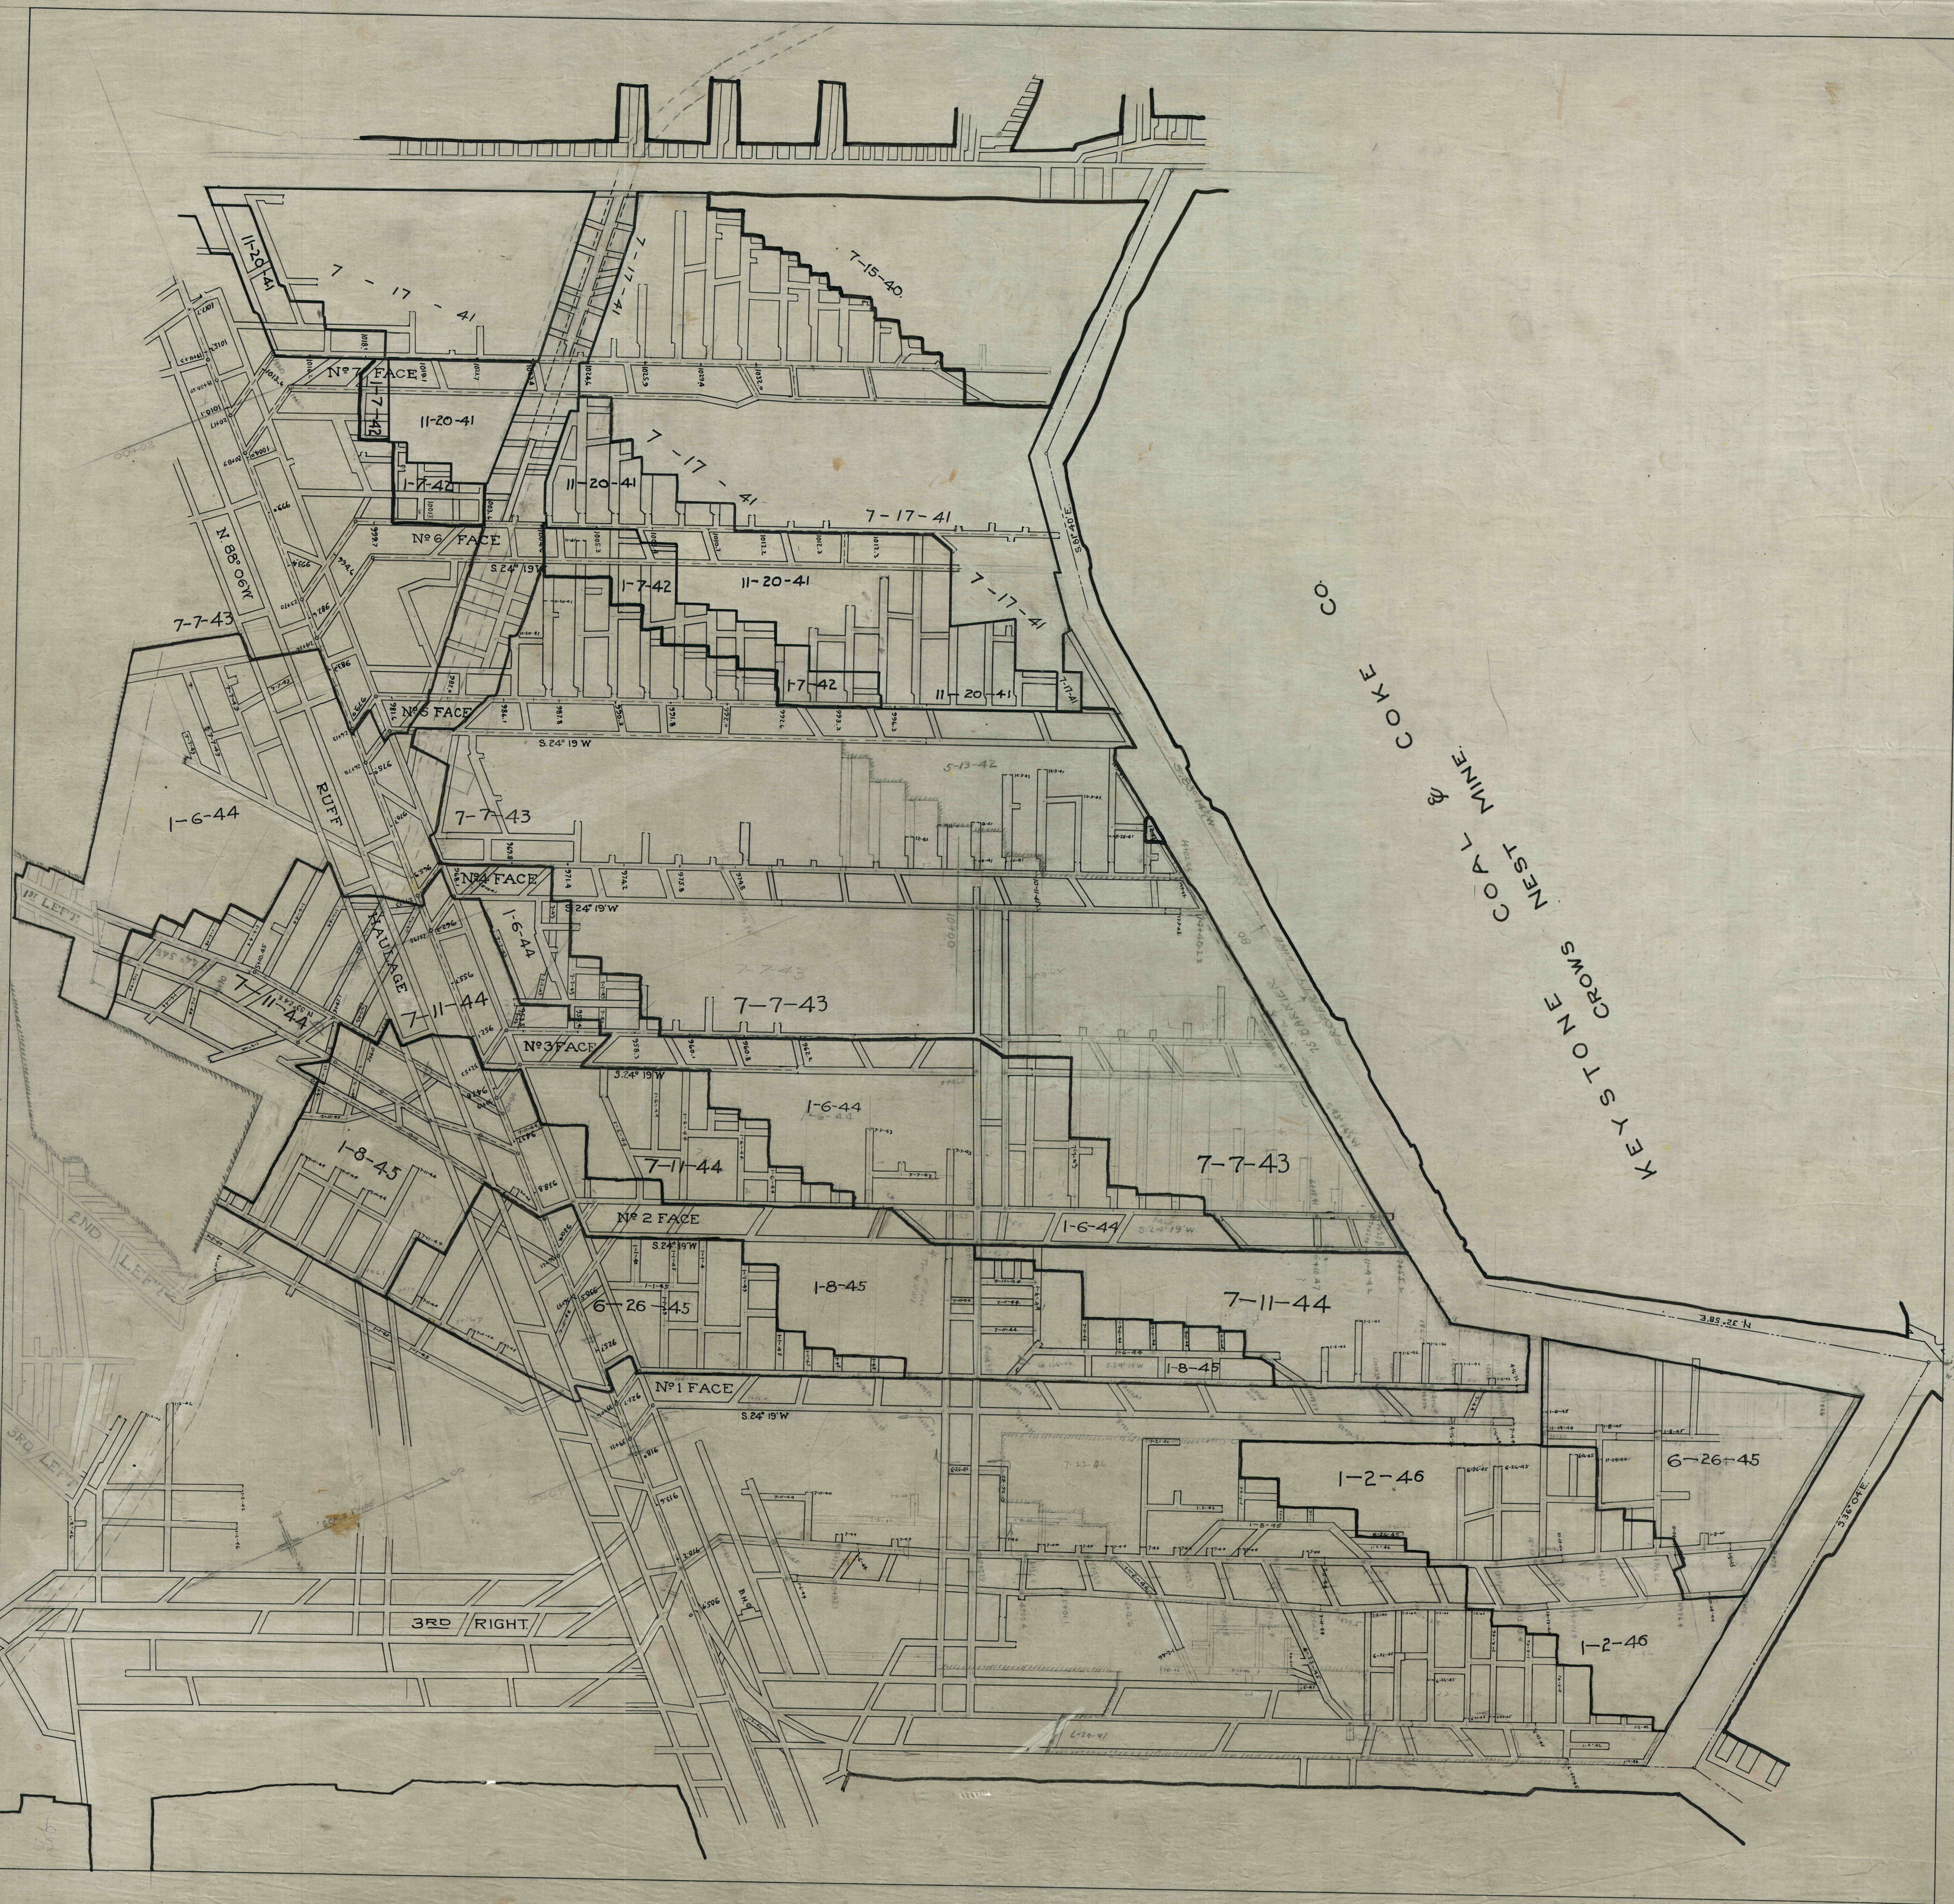

KEYSTONE CROWS NEST MINE & COKE CO

