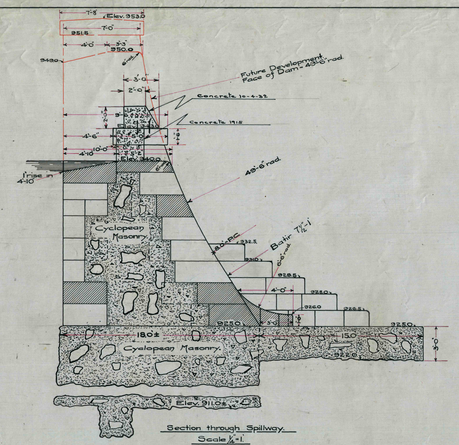

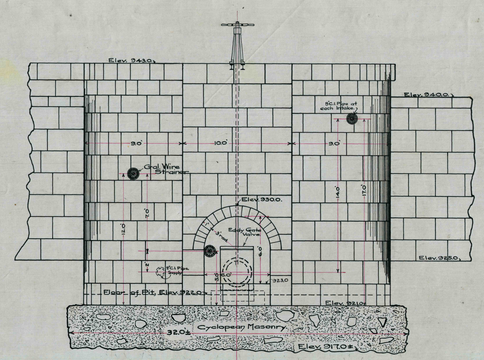

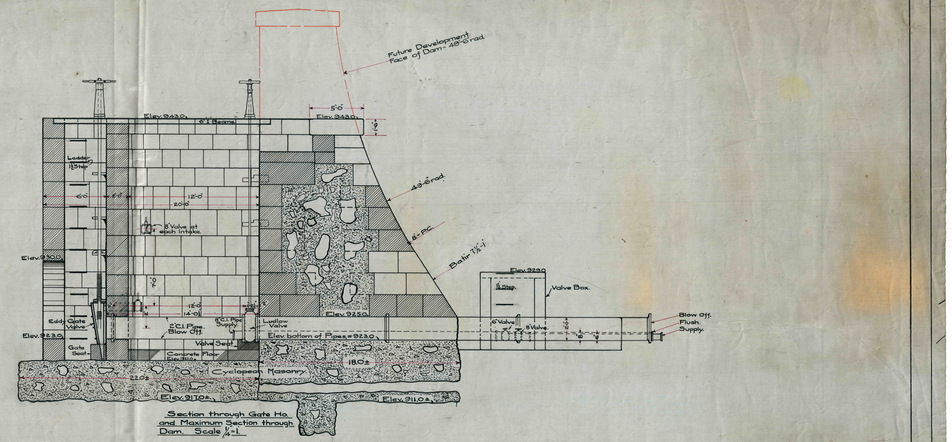

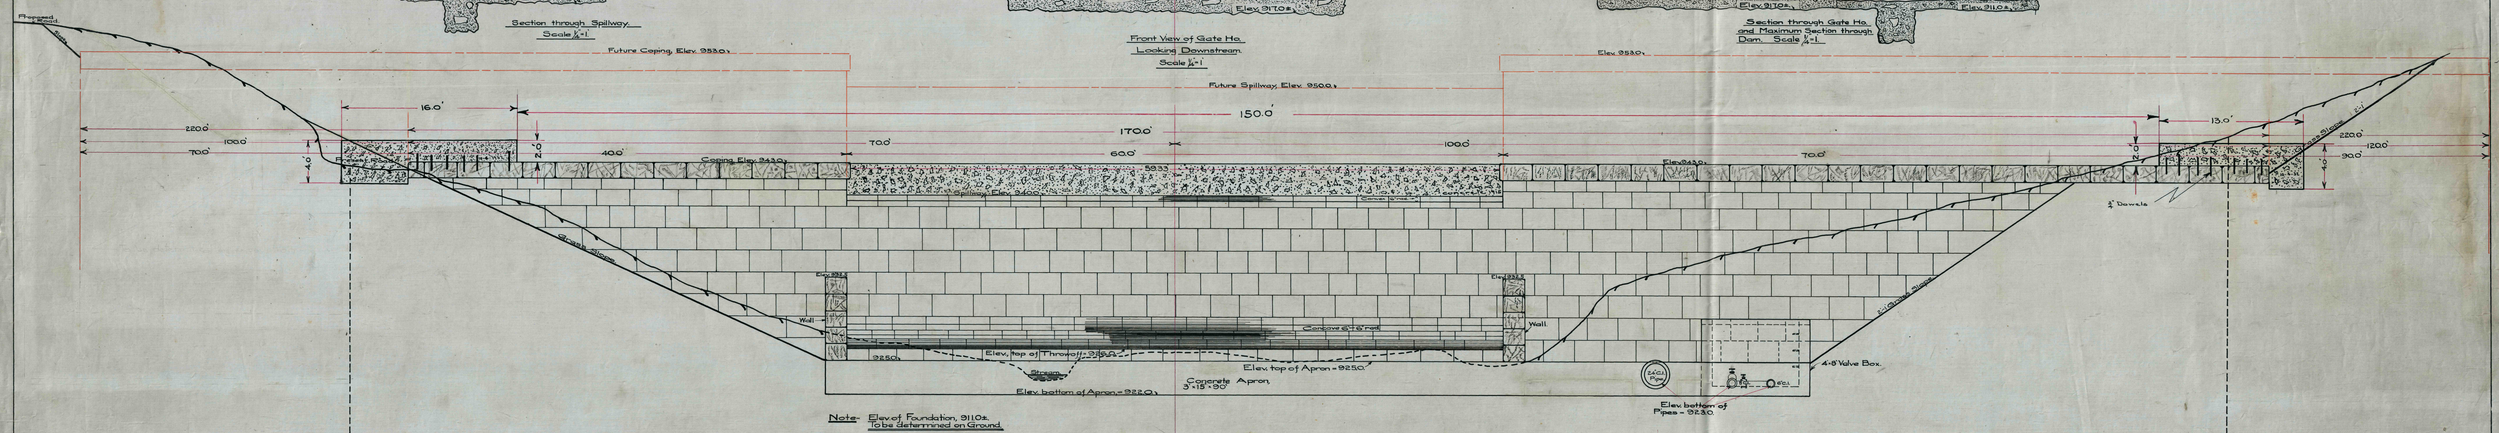

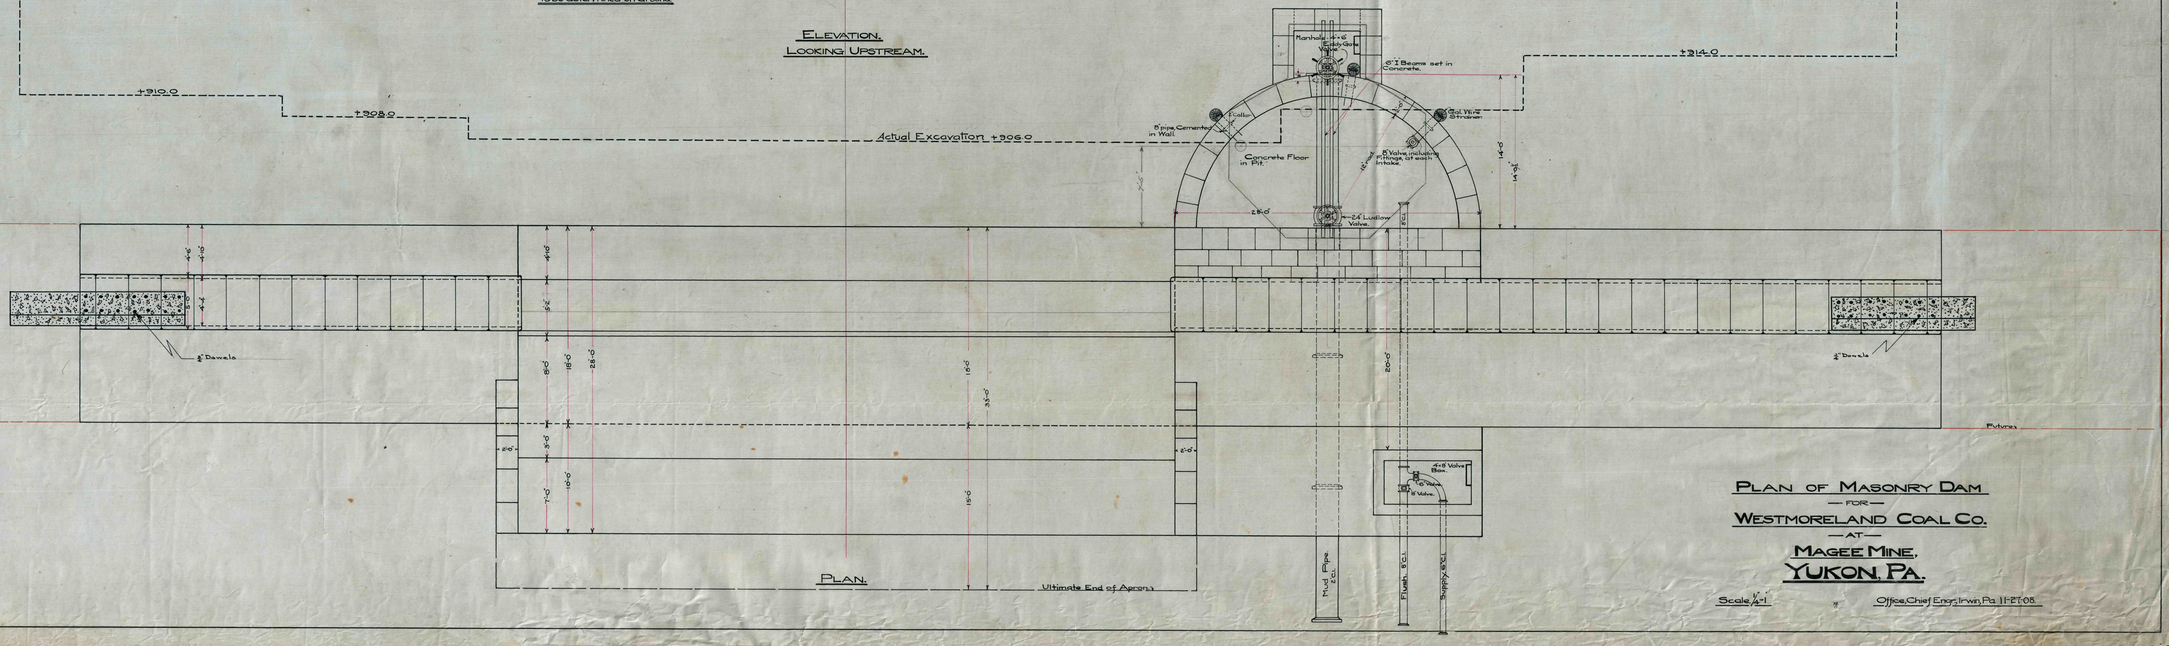

PLAN OF MASONRY DAM
— FOR —
WESTMORELAND COAL CO.
— AT —
MAGEE MINE,
YUKON, PA.

Scale 1/4"=1' Office, Chief Engr. Irwin, Pa. 11-27-08.

34+58