


Section through Spillway.

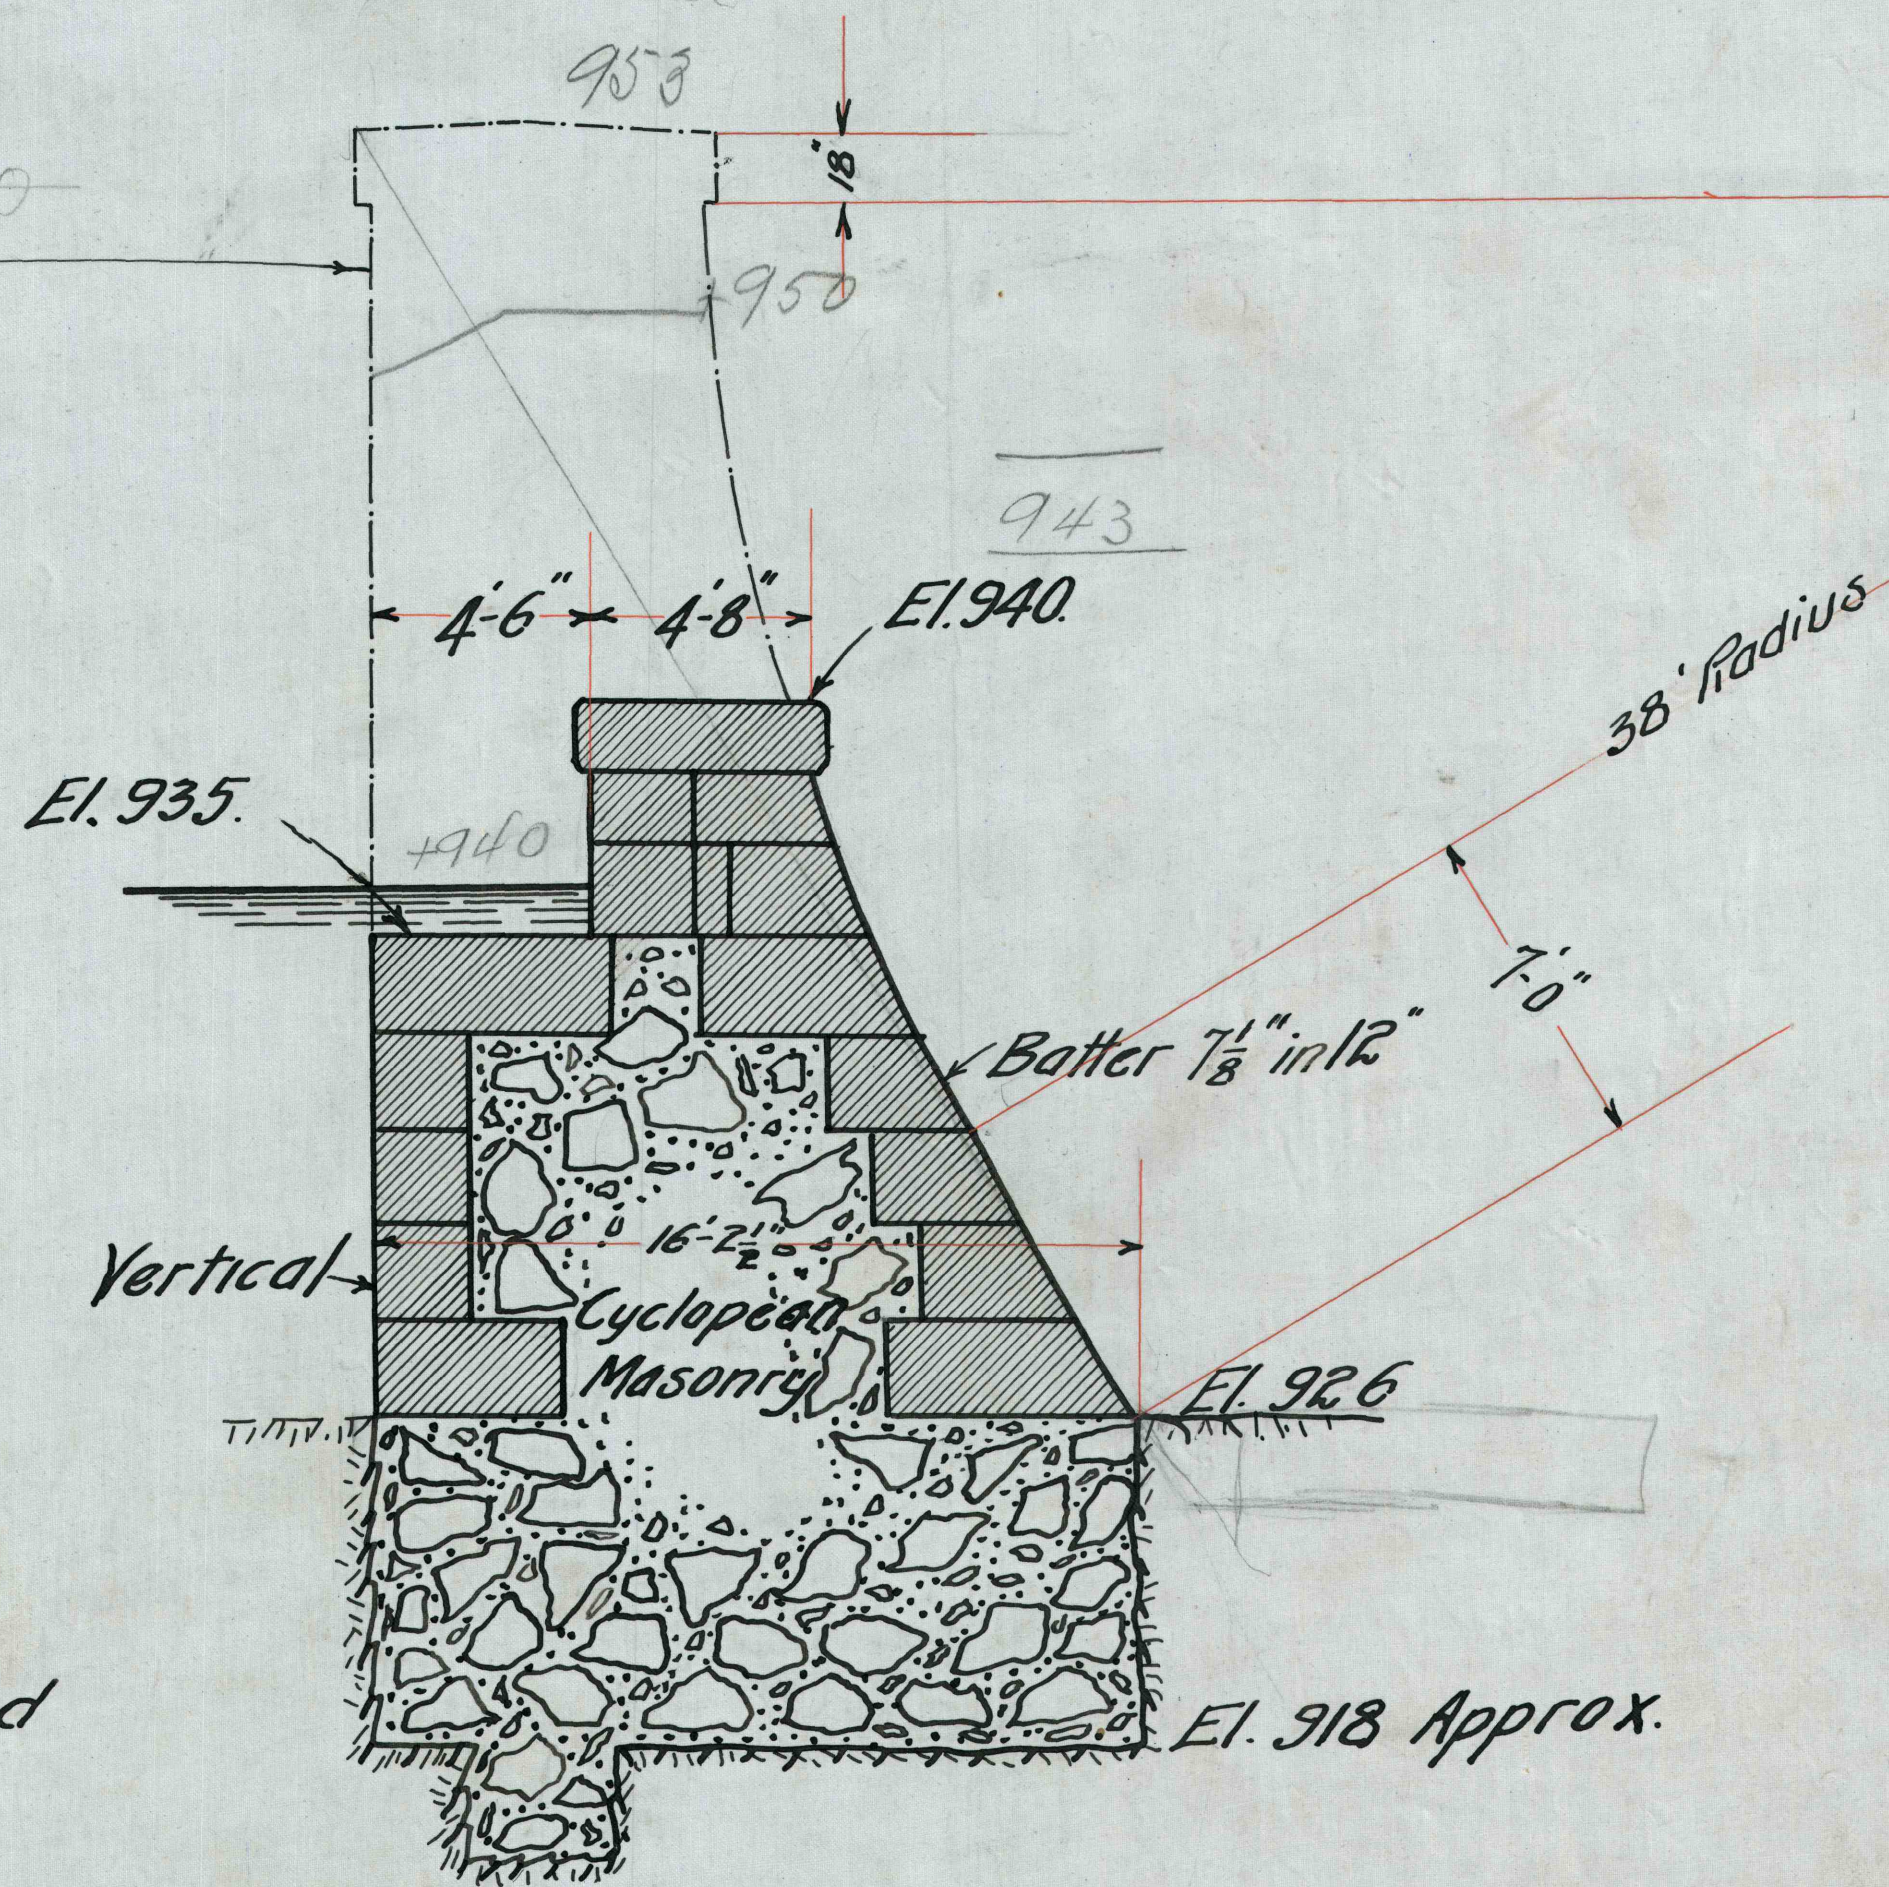

Maximum section through Dam.

—Plan of Dam—  
 —A1—  
 —MAGEE MINE—  
 —OF THE—  
 —Westmoreland Coal Co.—  
 —at YUKON PENNA.—

—Scale 1/4" = 1'—

—ENG. DEPT. WESTMORELAND COAL CO. IRWIN PA. OCT. 24<sup>th</sup> 1908.—