


Downstream Elevation.

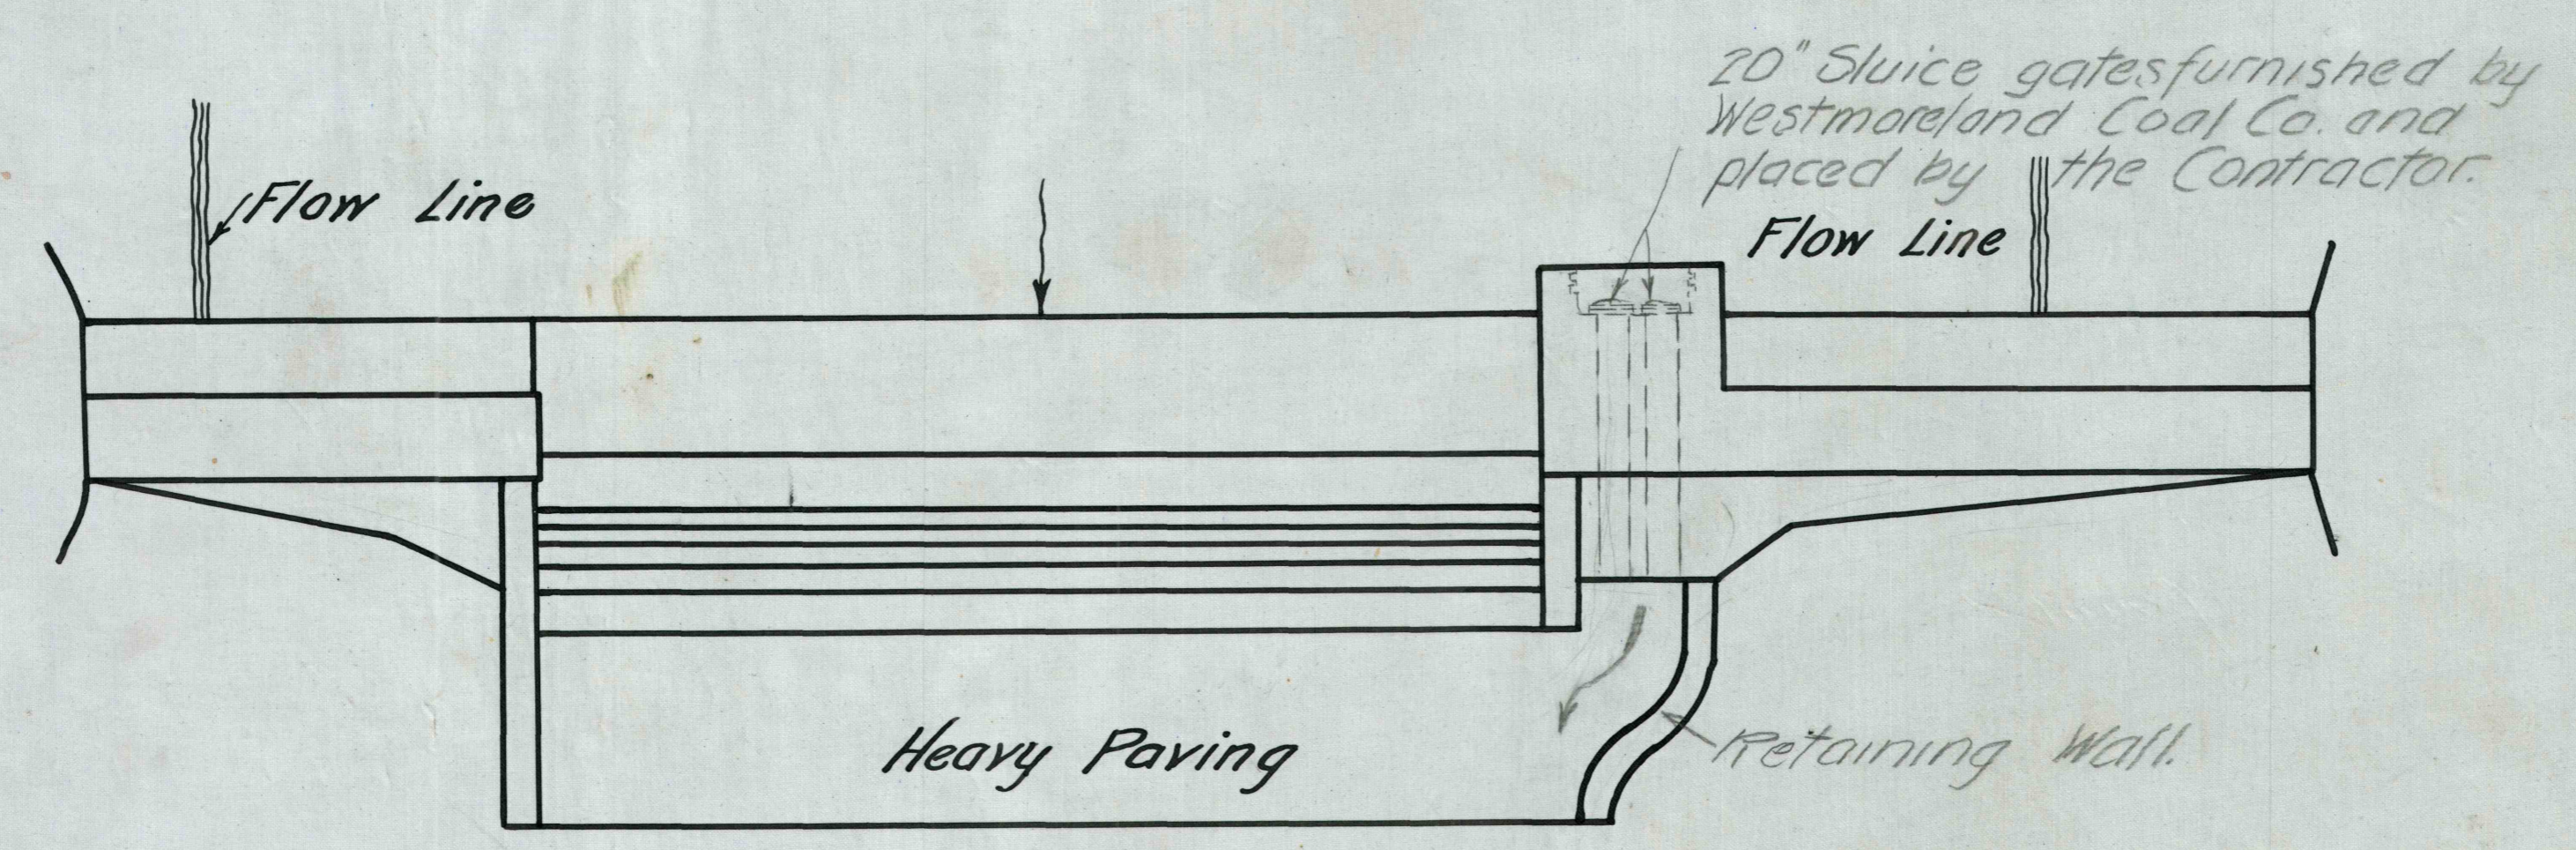

Plan.

— Plan of Dam —
 — AT —
 — MAGEE MINE —
 — OF THE —
 — Westmoreland Coal Co. —
 — at YUKON PENNA. —
 — Scale 1"=10' —