


# PLAN of MARCHAND MINE

Scale 1" = 600' March 1913.

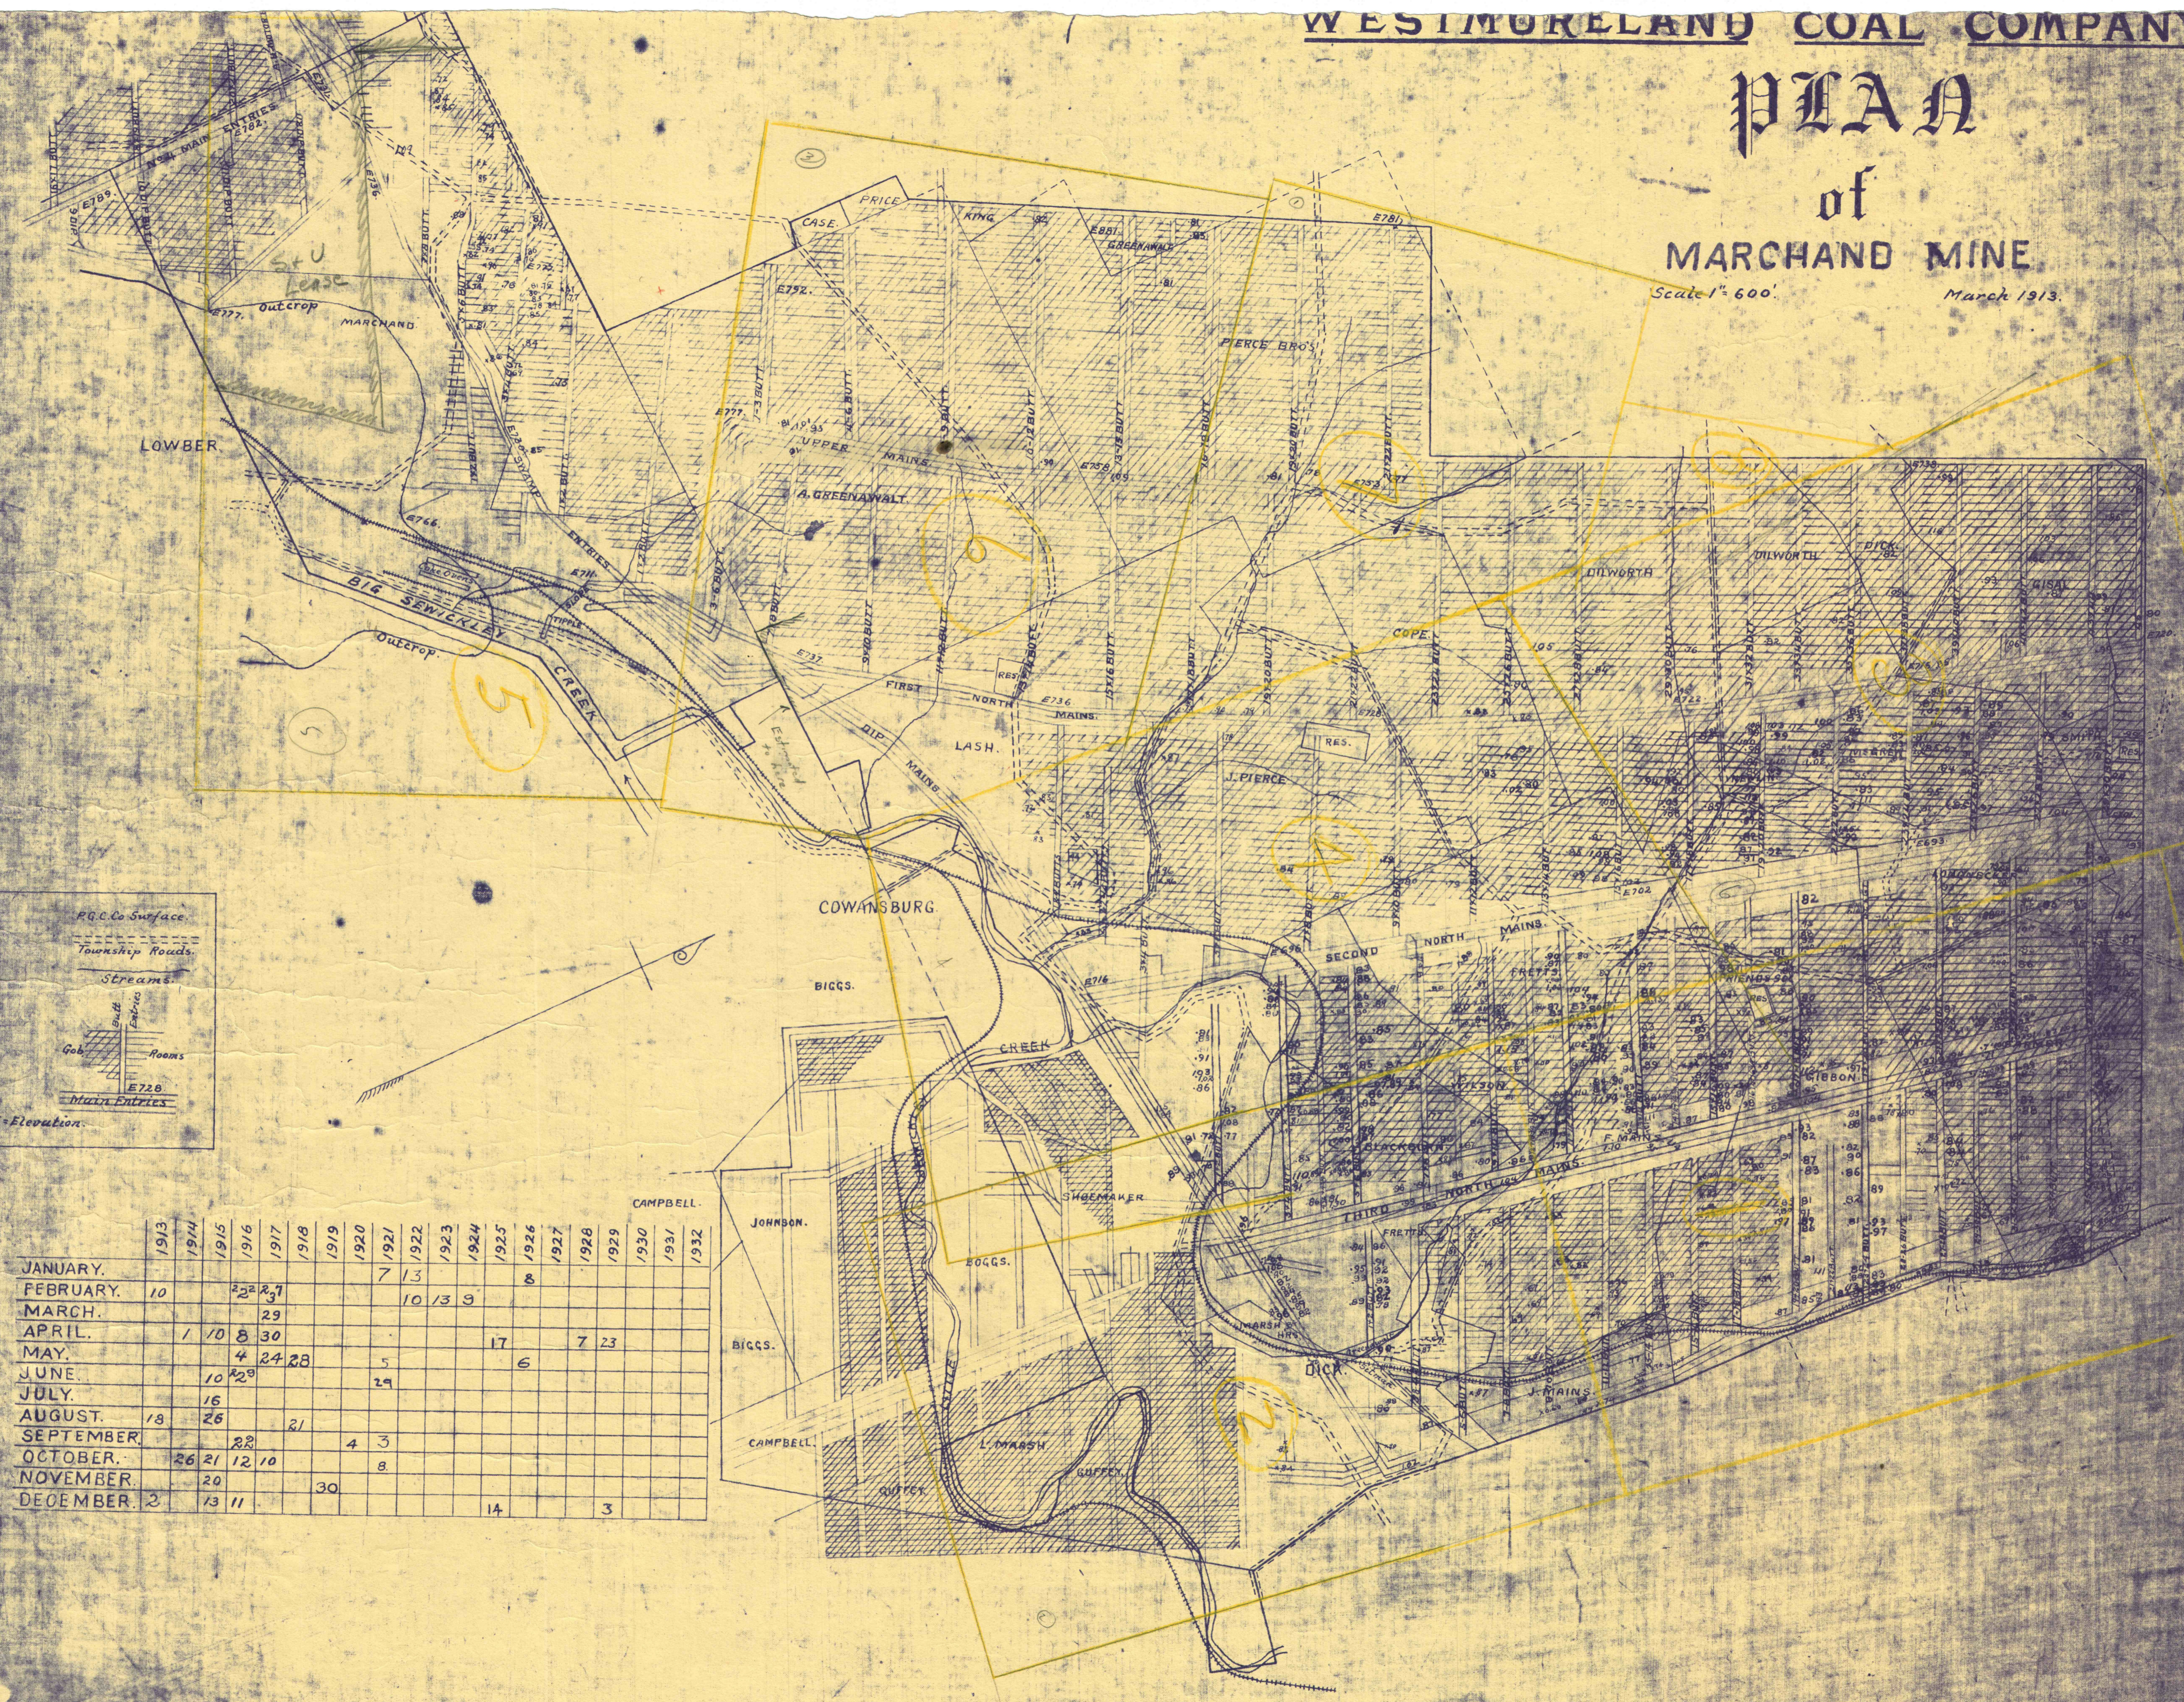

R.C.C. Co Surface  
 Township Roads  
 Streams  
 Gob  
 Rooms  
 Main Entries  
 E = Elevation

	1913	1914	1915	1916	1917	1918	1919	1920	1921	1922	1923	1924	1925	1926	1927	1928	1929	1930	1931	1932
JANUARY.									7	13	9									
FEBRUARY.	10		22	27										8						
MARCH.				29																
APRIL.		1	10	8	30								17		7	23				
MAY.			4	24	28									6						
JUNE.		10	23																	
JULY.		16							29											
AUGUST.	18	26			21															
SEPTEMBER.			22					4	3											
OCTOBER.		26	21	12	10					8										
NOVEMBER.			20																	
DECEMBER.	2	13	11				30								14				3	