


FIT TO 3

FIT TO 4

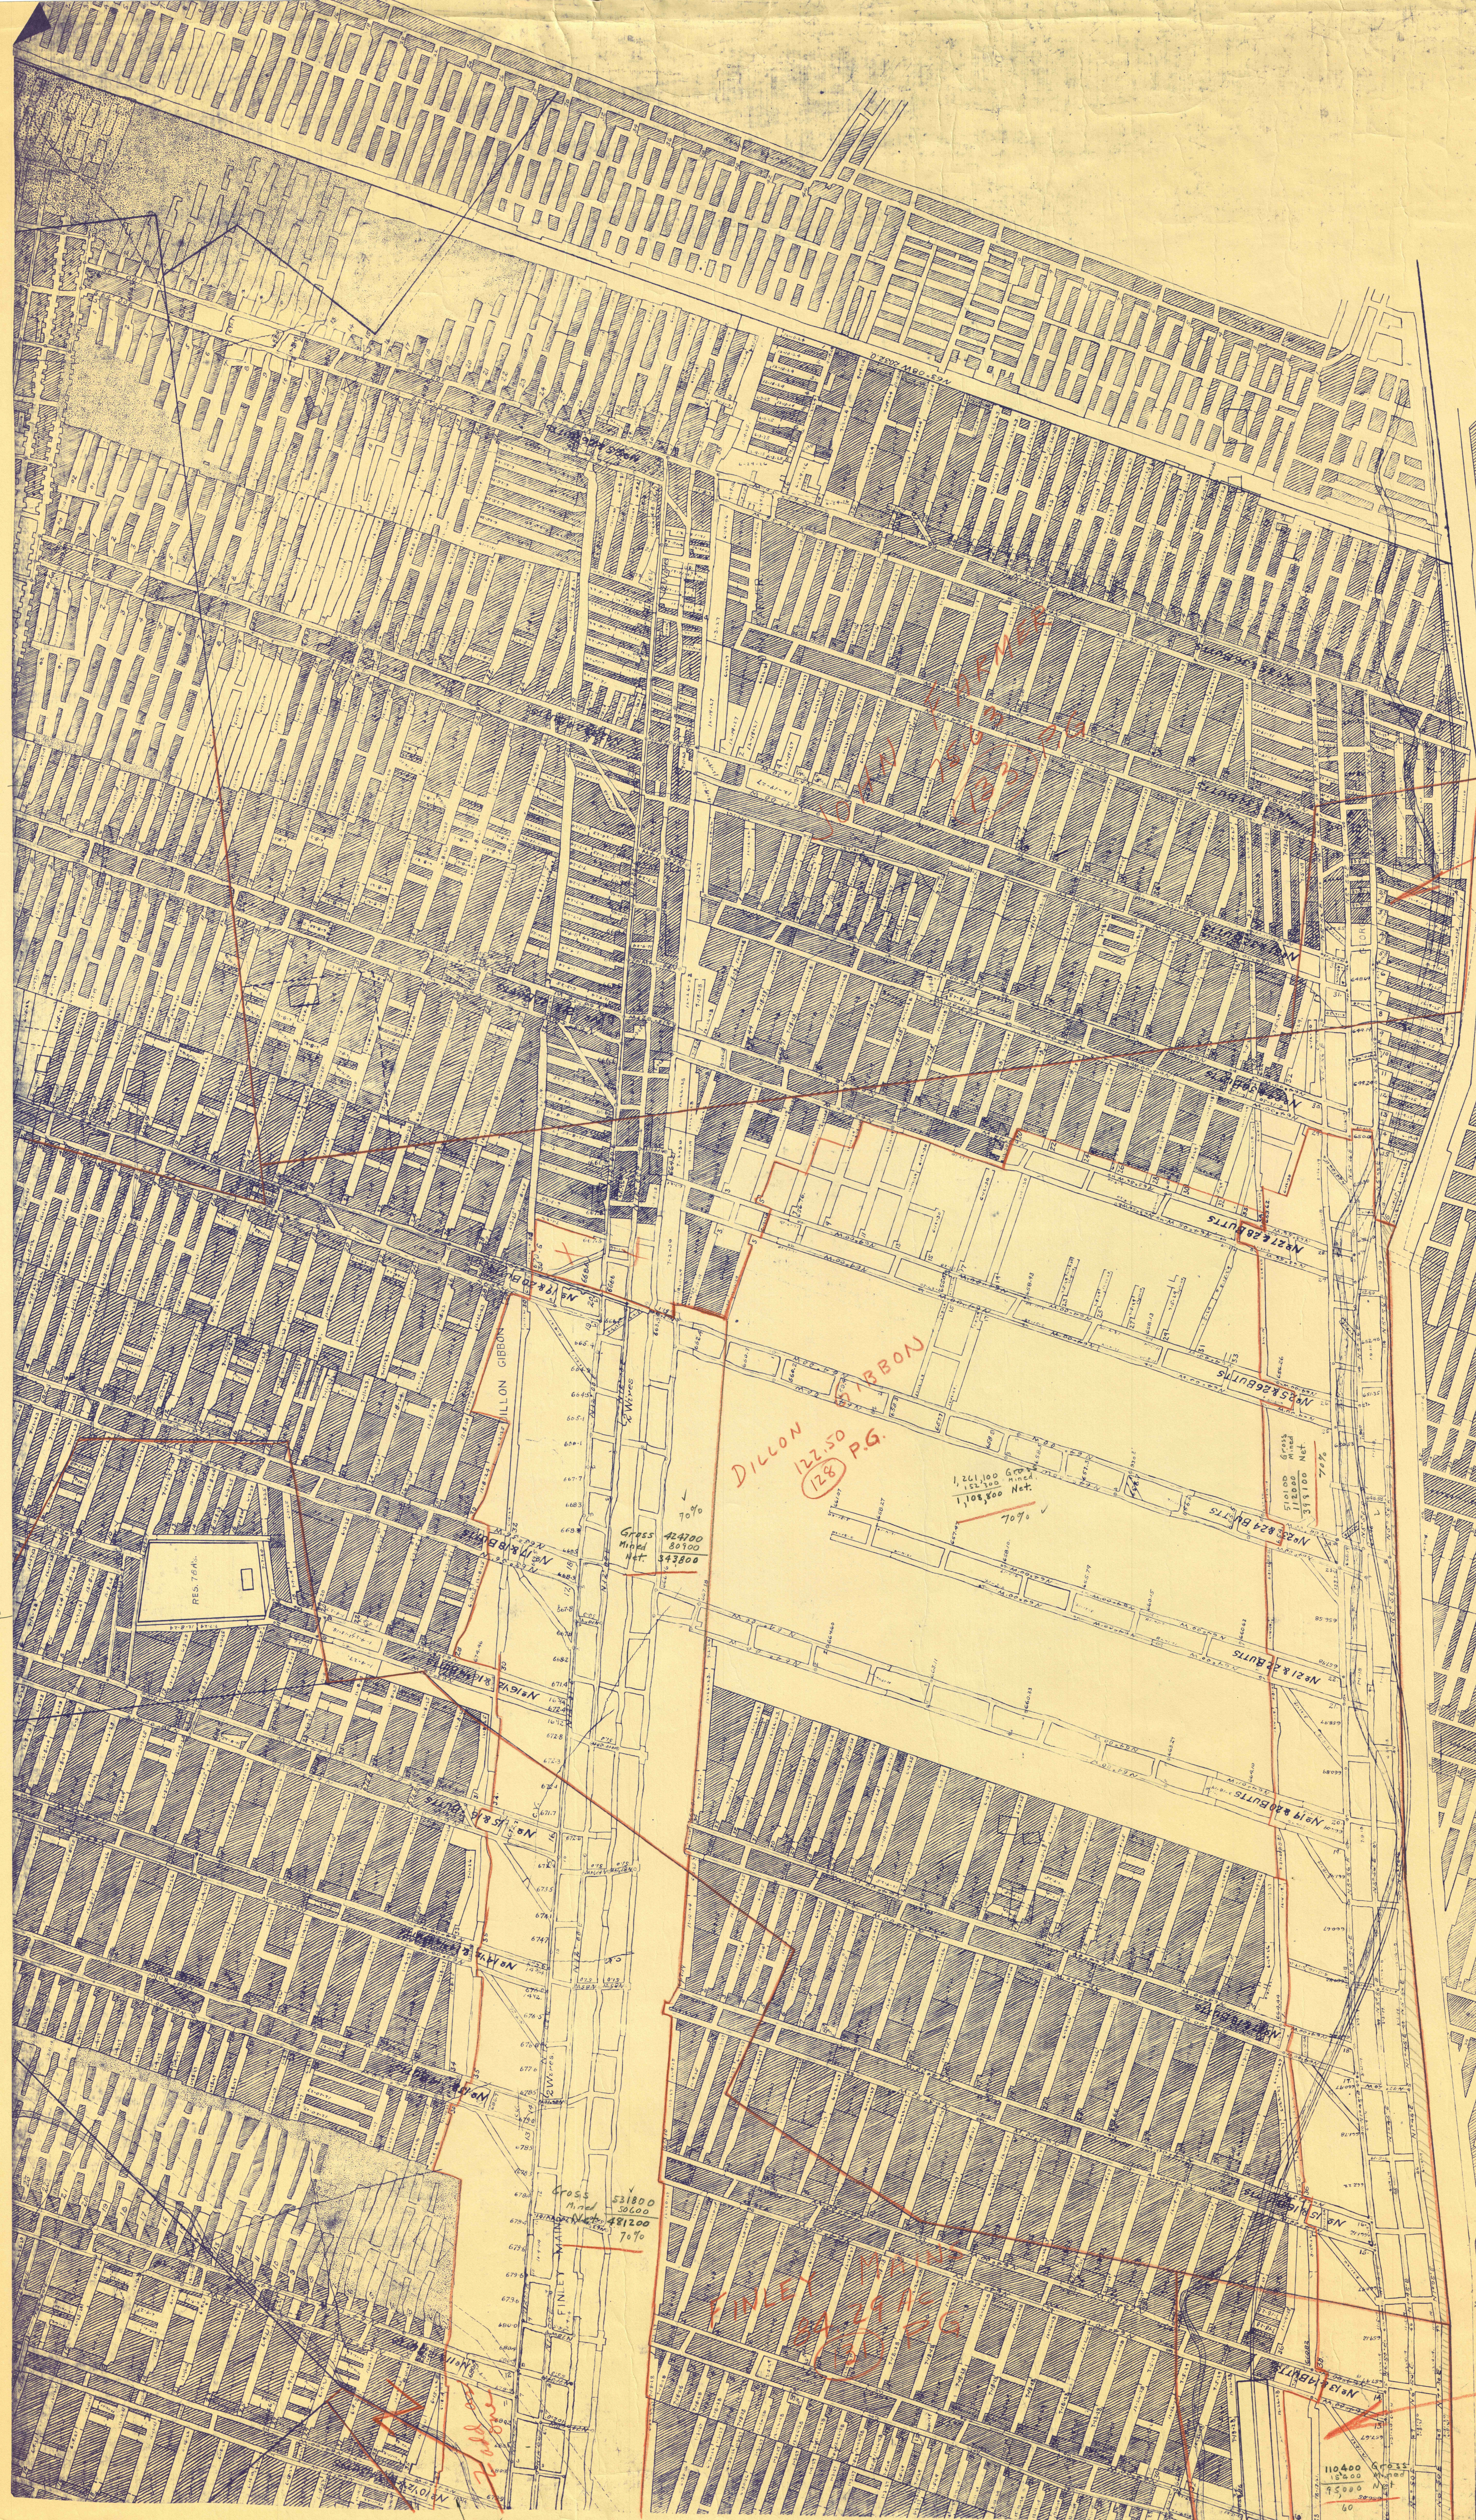

DILLON GIBBON
 122.50
 128 PG.

GEORGE GRAFT
 3.36
 47 PG.

JESSIE MAINS
 17.73
 139 PG.

FIT TO 2