


#7A

#7A

6
FIT TO

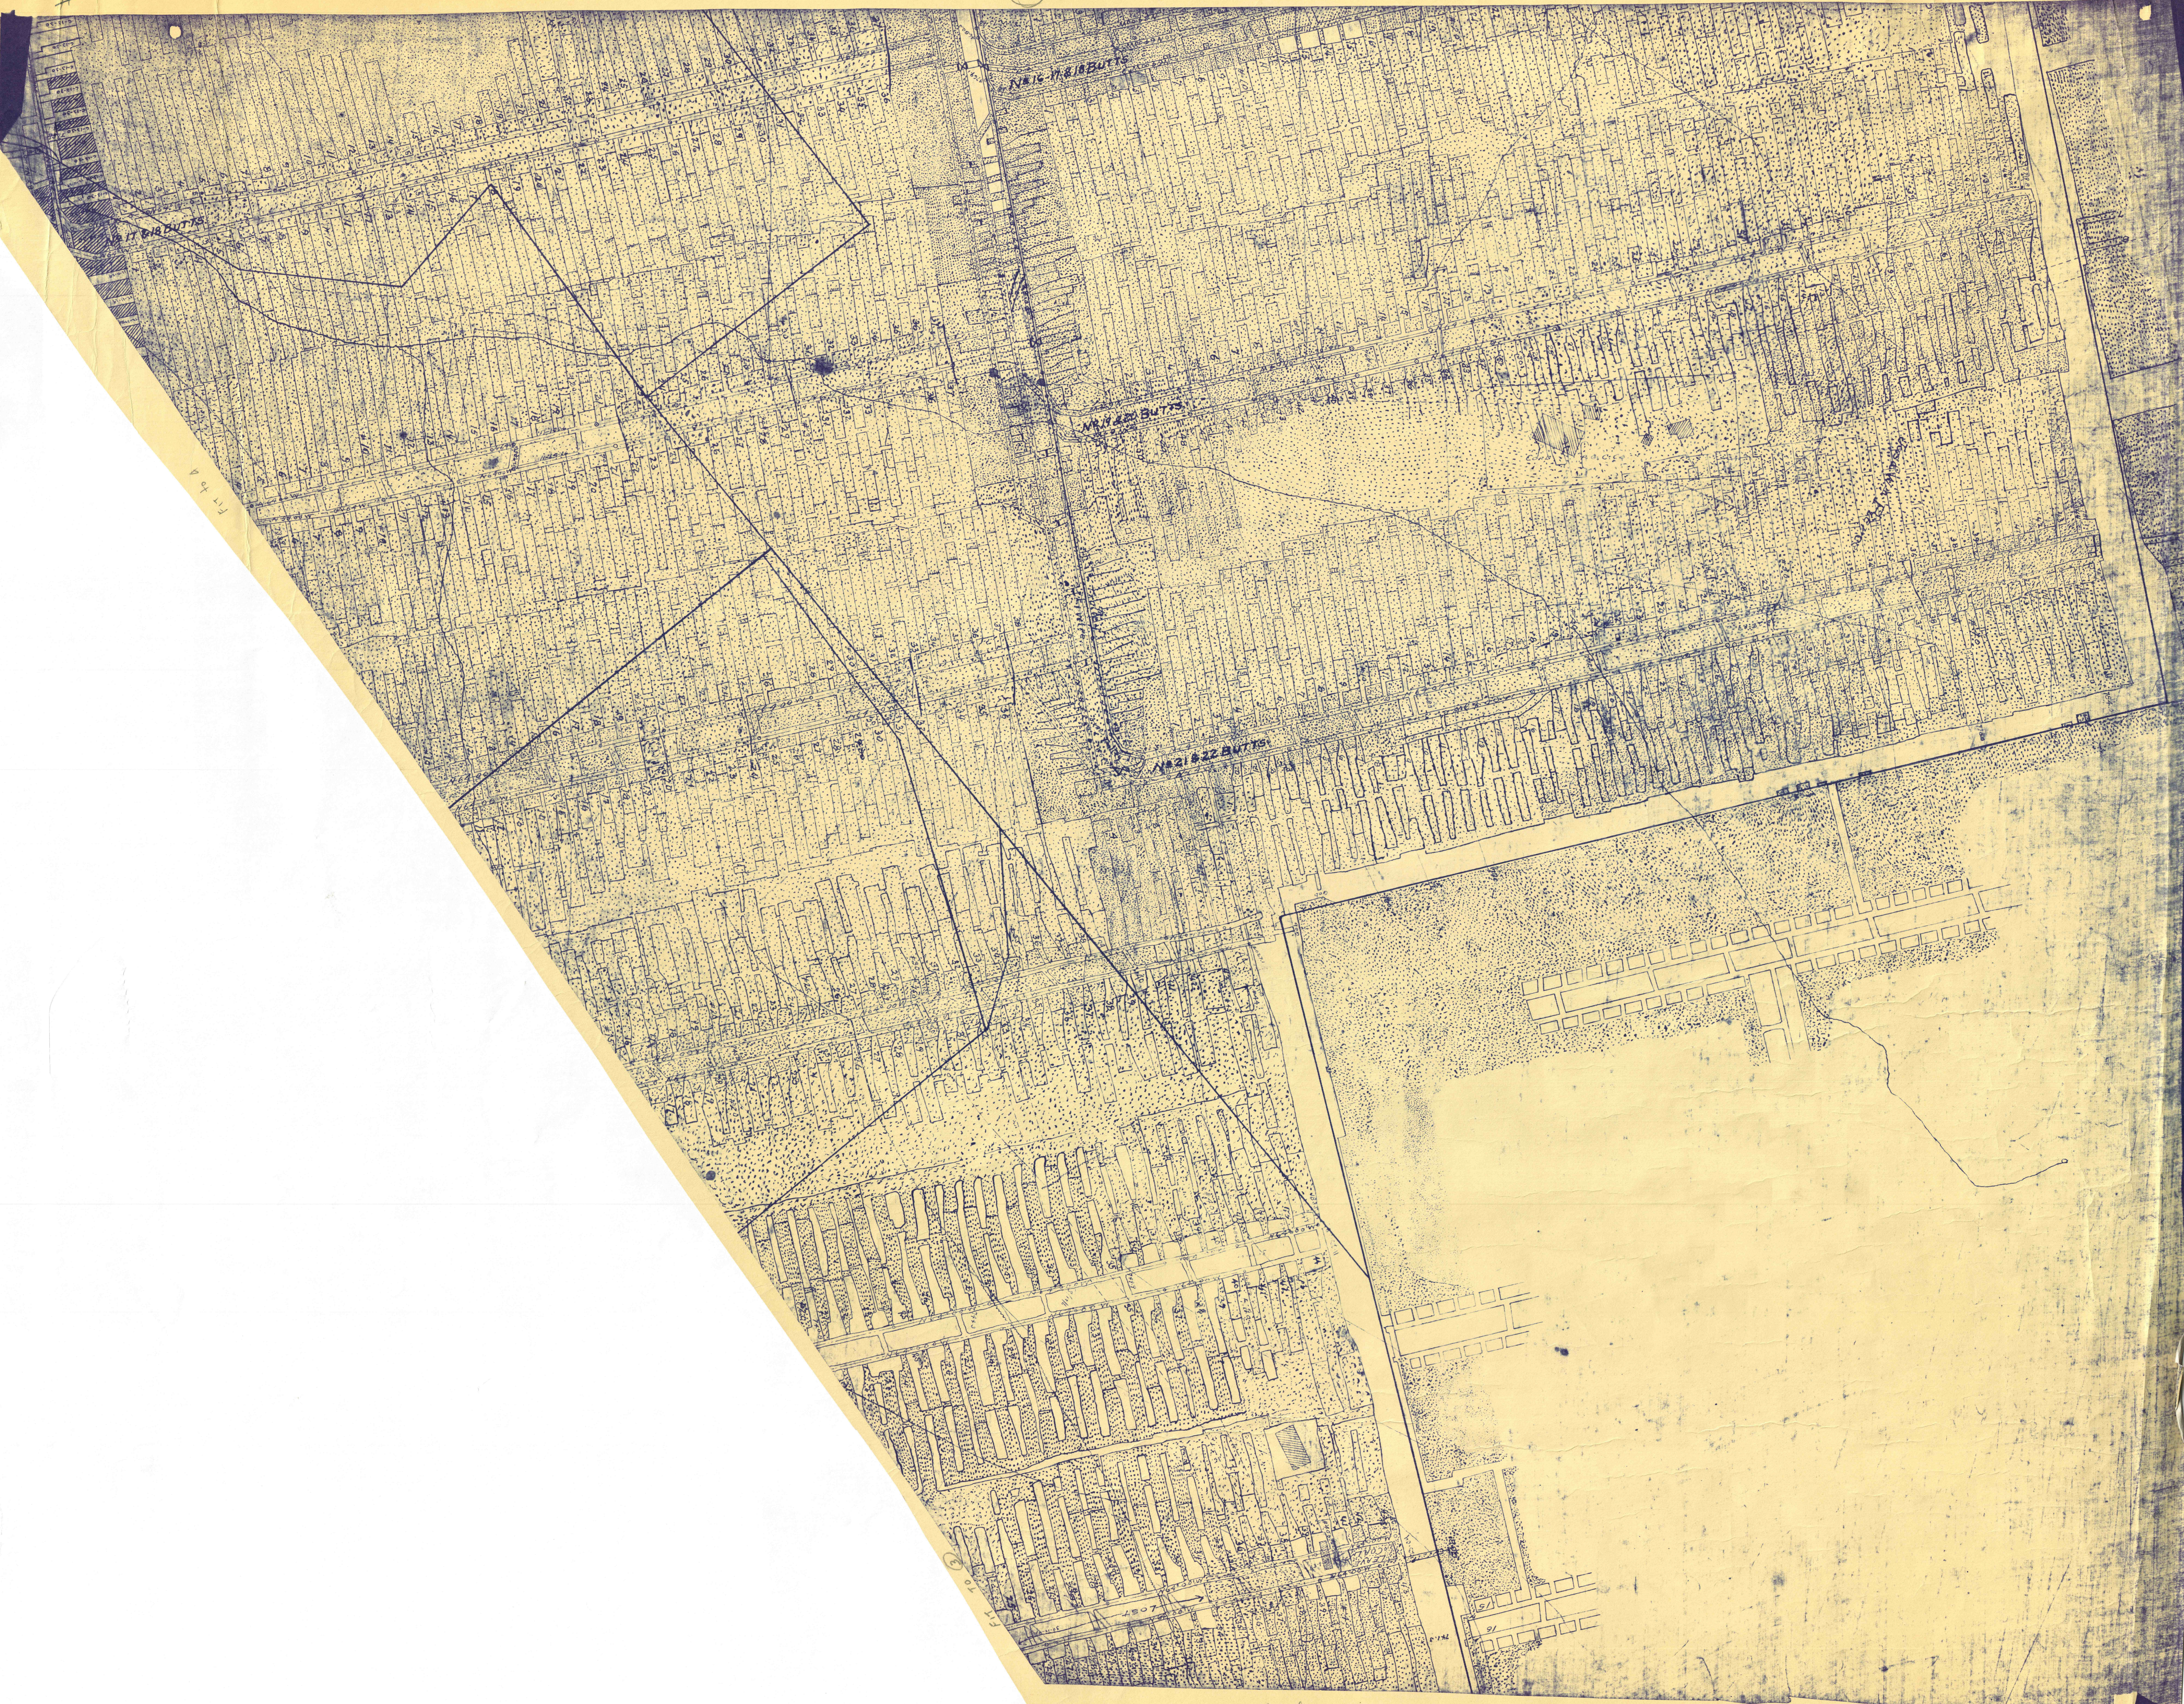

fit to here

