



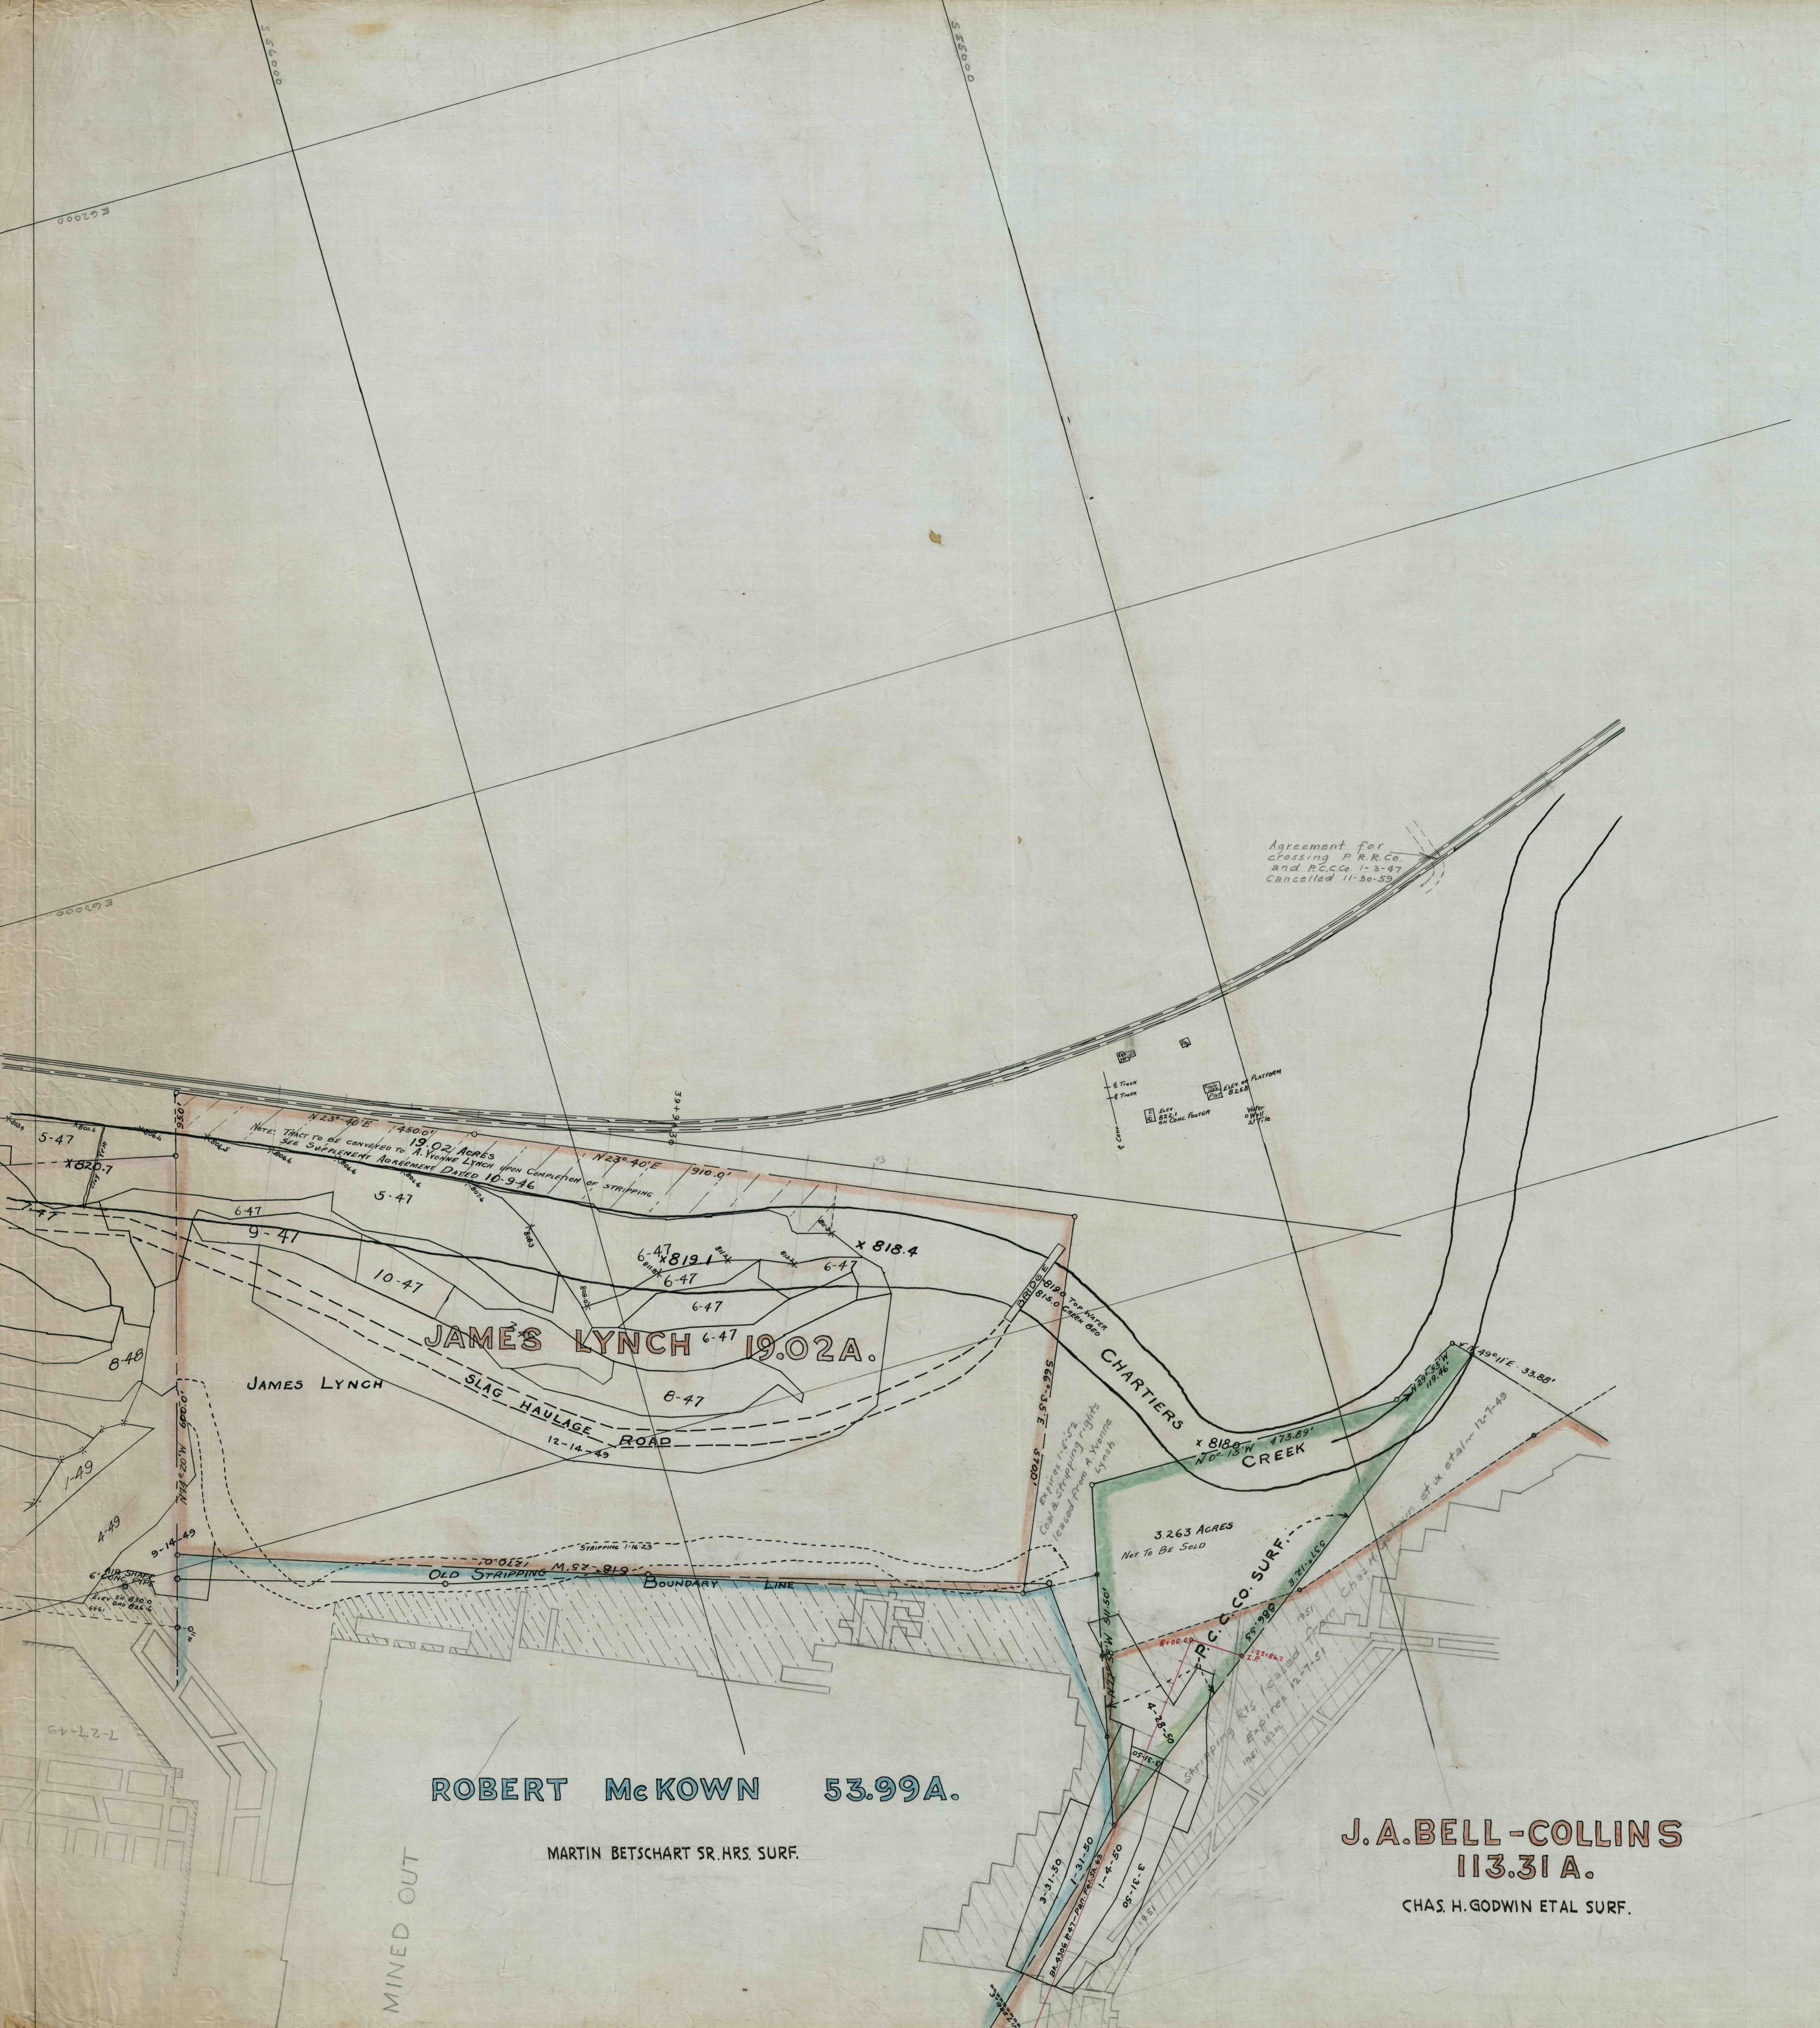

ROBERT Mc KOWN 53.99A.

MARTIN BETSCHART SR. HRS. SURF.

J. A. BELL-COLLINS 113.31A.

CHAS. H. GODWIN ETAL SURF.

MINED OUT