


LYONS RUN MINE

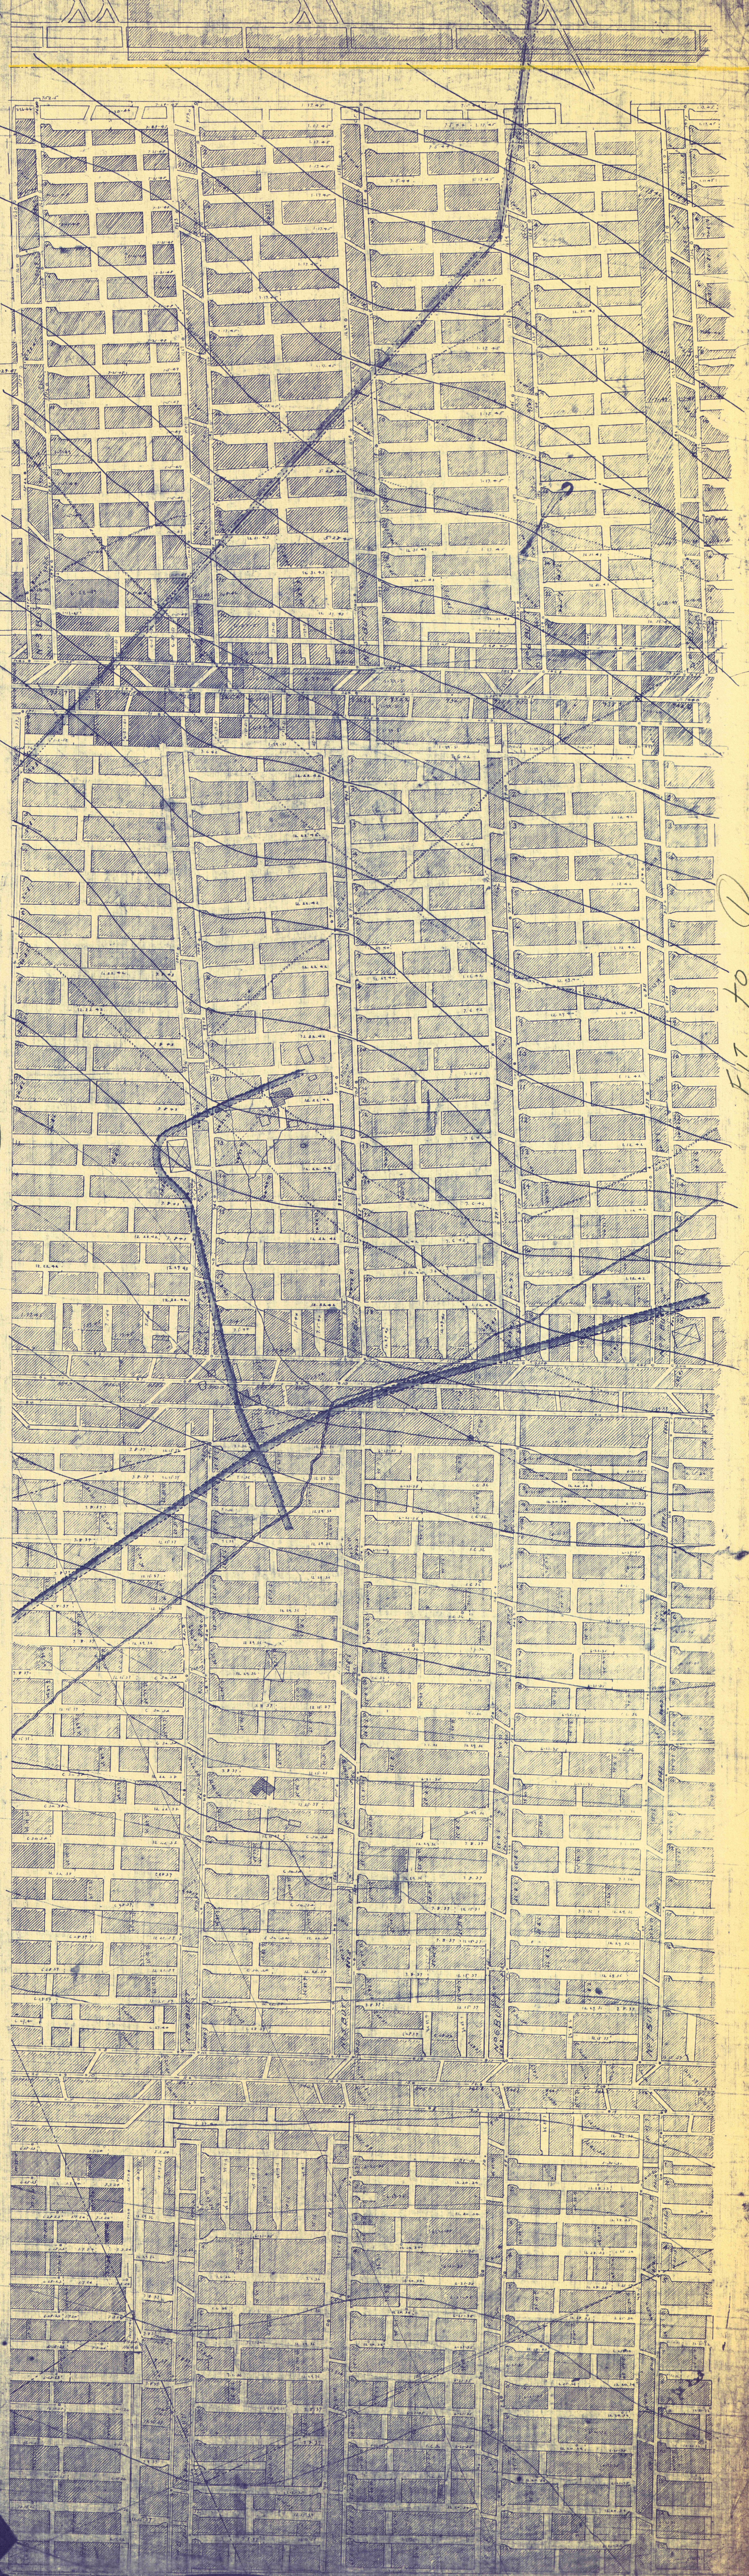

FIT to 3

FIT to 1

FIT to 7

2