


ENG. DEPT.
Pittsburgh Coal Co.
Plan of side
elevation of
new Apple
Morgan Mine
6833
D-20

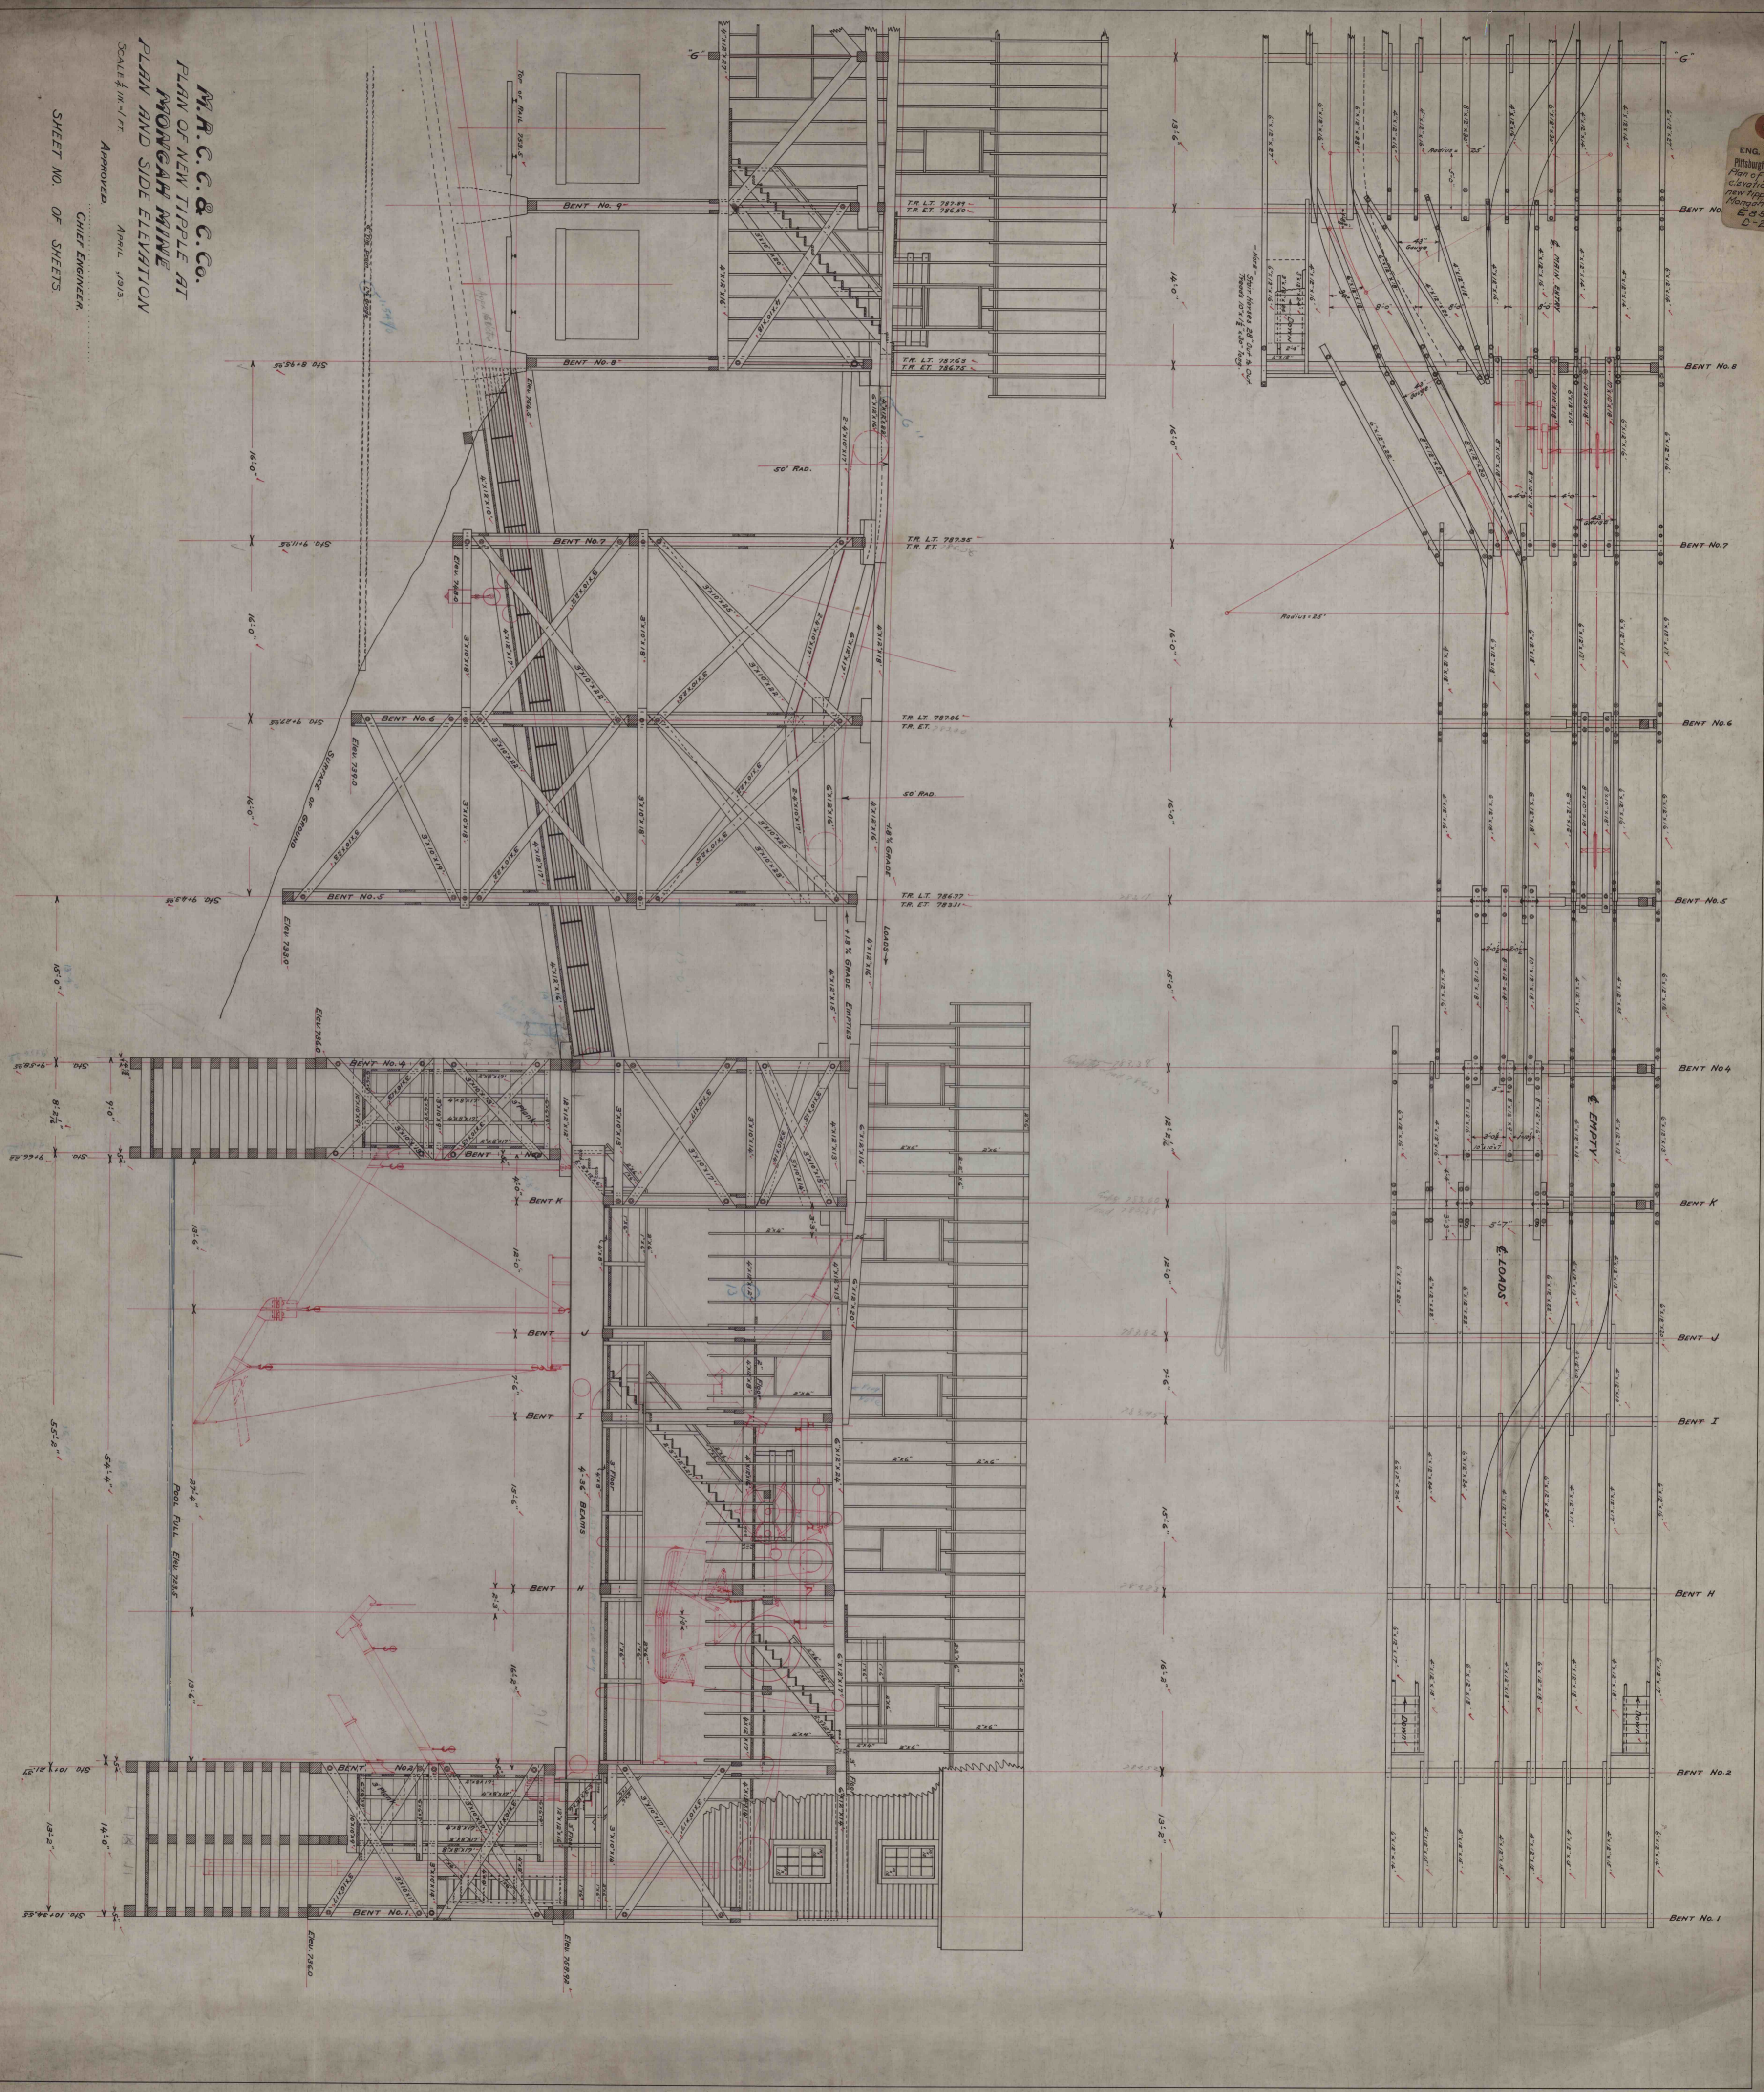

M. R. C. C. & C. Co.
PLAN OF NEW TRIPLE AT
MORGAN MINE
PLAN AND SIDE ELEVATION
SCALE 1/4" = 1'-0"
APRIL 1913
APPROVED
CHIEF ENGINEER
SHEET NO. OF SHEETS

ES99 D-20