


MONGAH

Fit to #19 (Mongah & Barcola)
FIT TO 19


Fit to #15 (MONGAH)
FIT TO 15

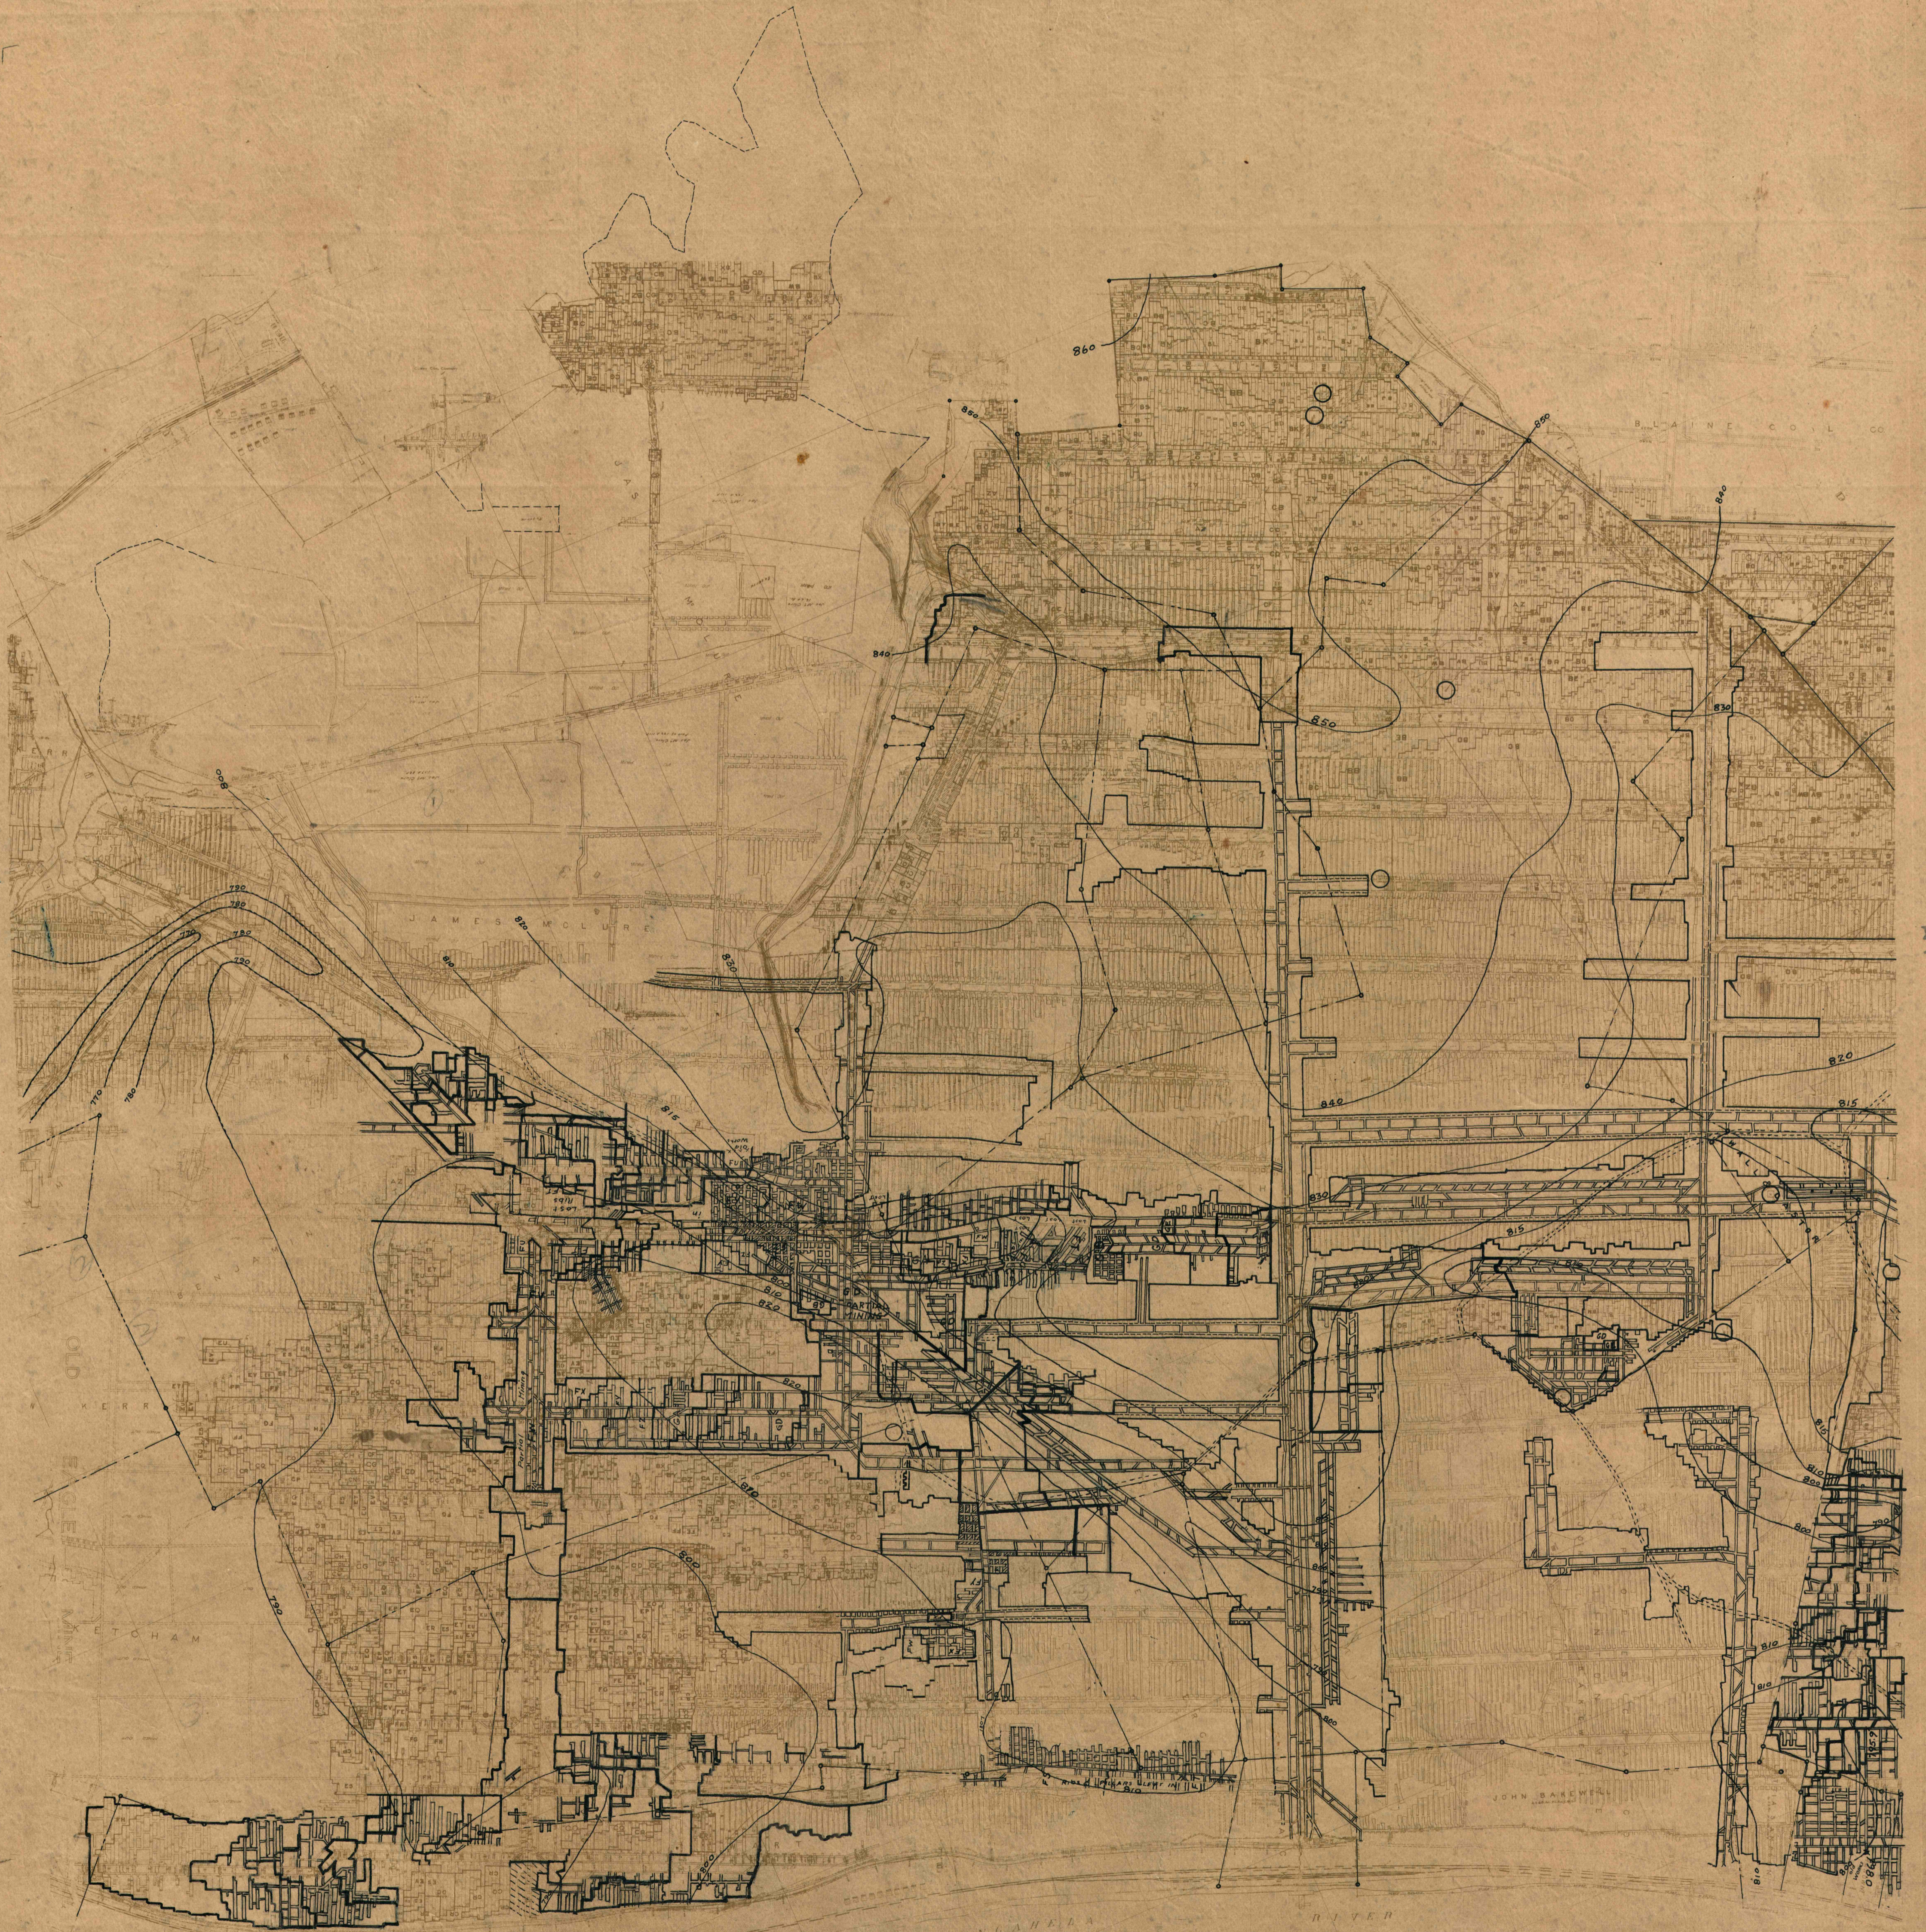

MONGAH MINE

SURVEY DATE 7-16-56

SCALE 1" = 500'

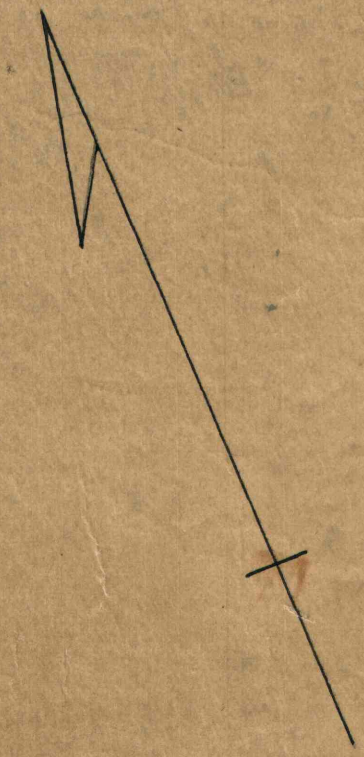

MONGAH