


MONGAH AND BUNOLA

MINES

THE M R C C & C CO

Scale 1"=100

1907

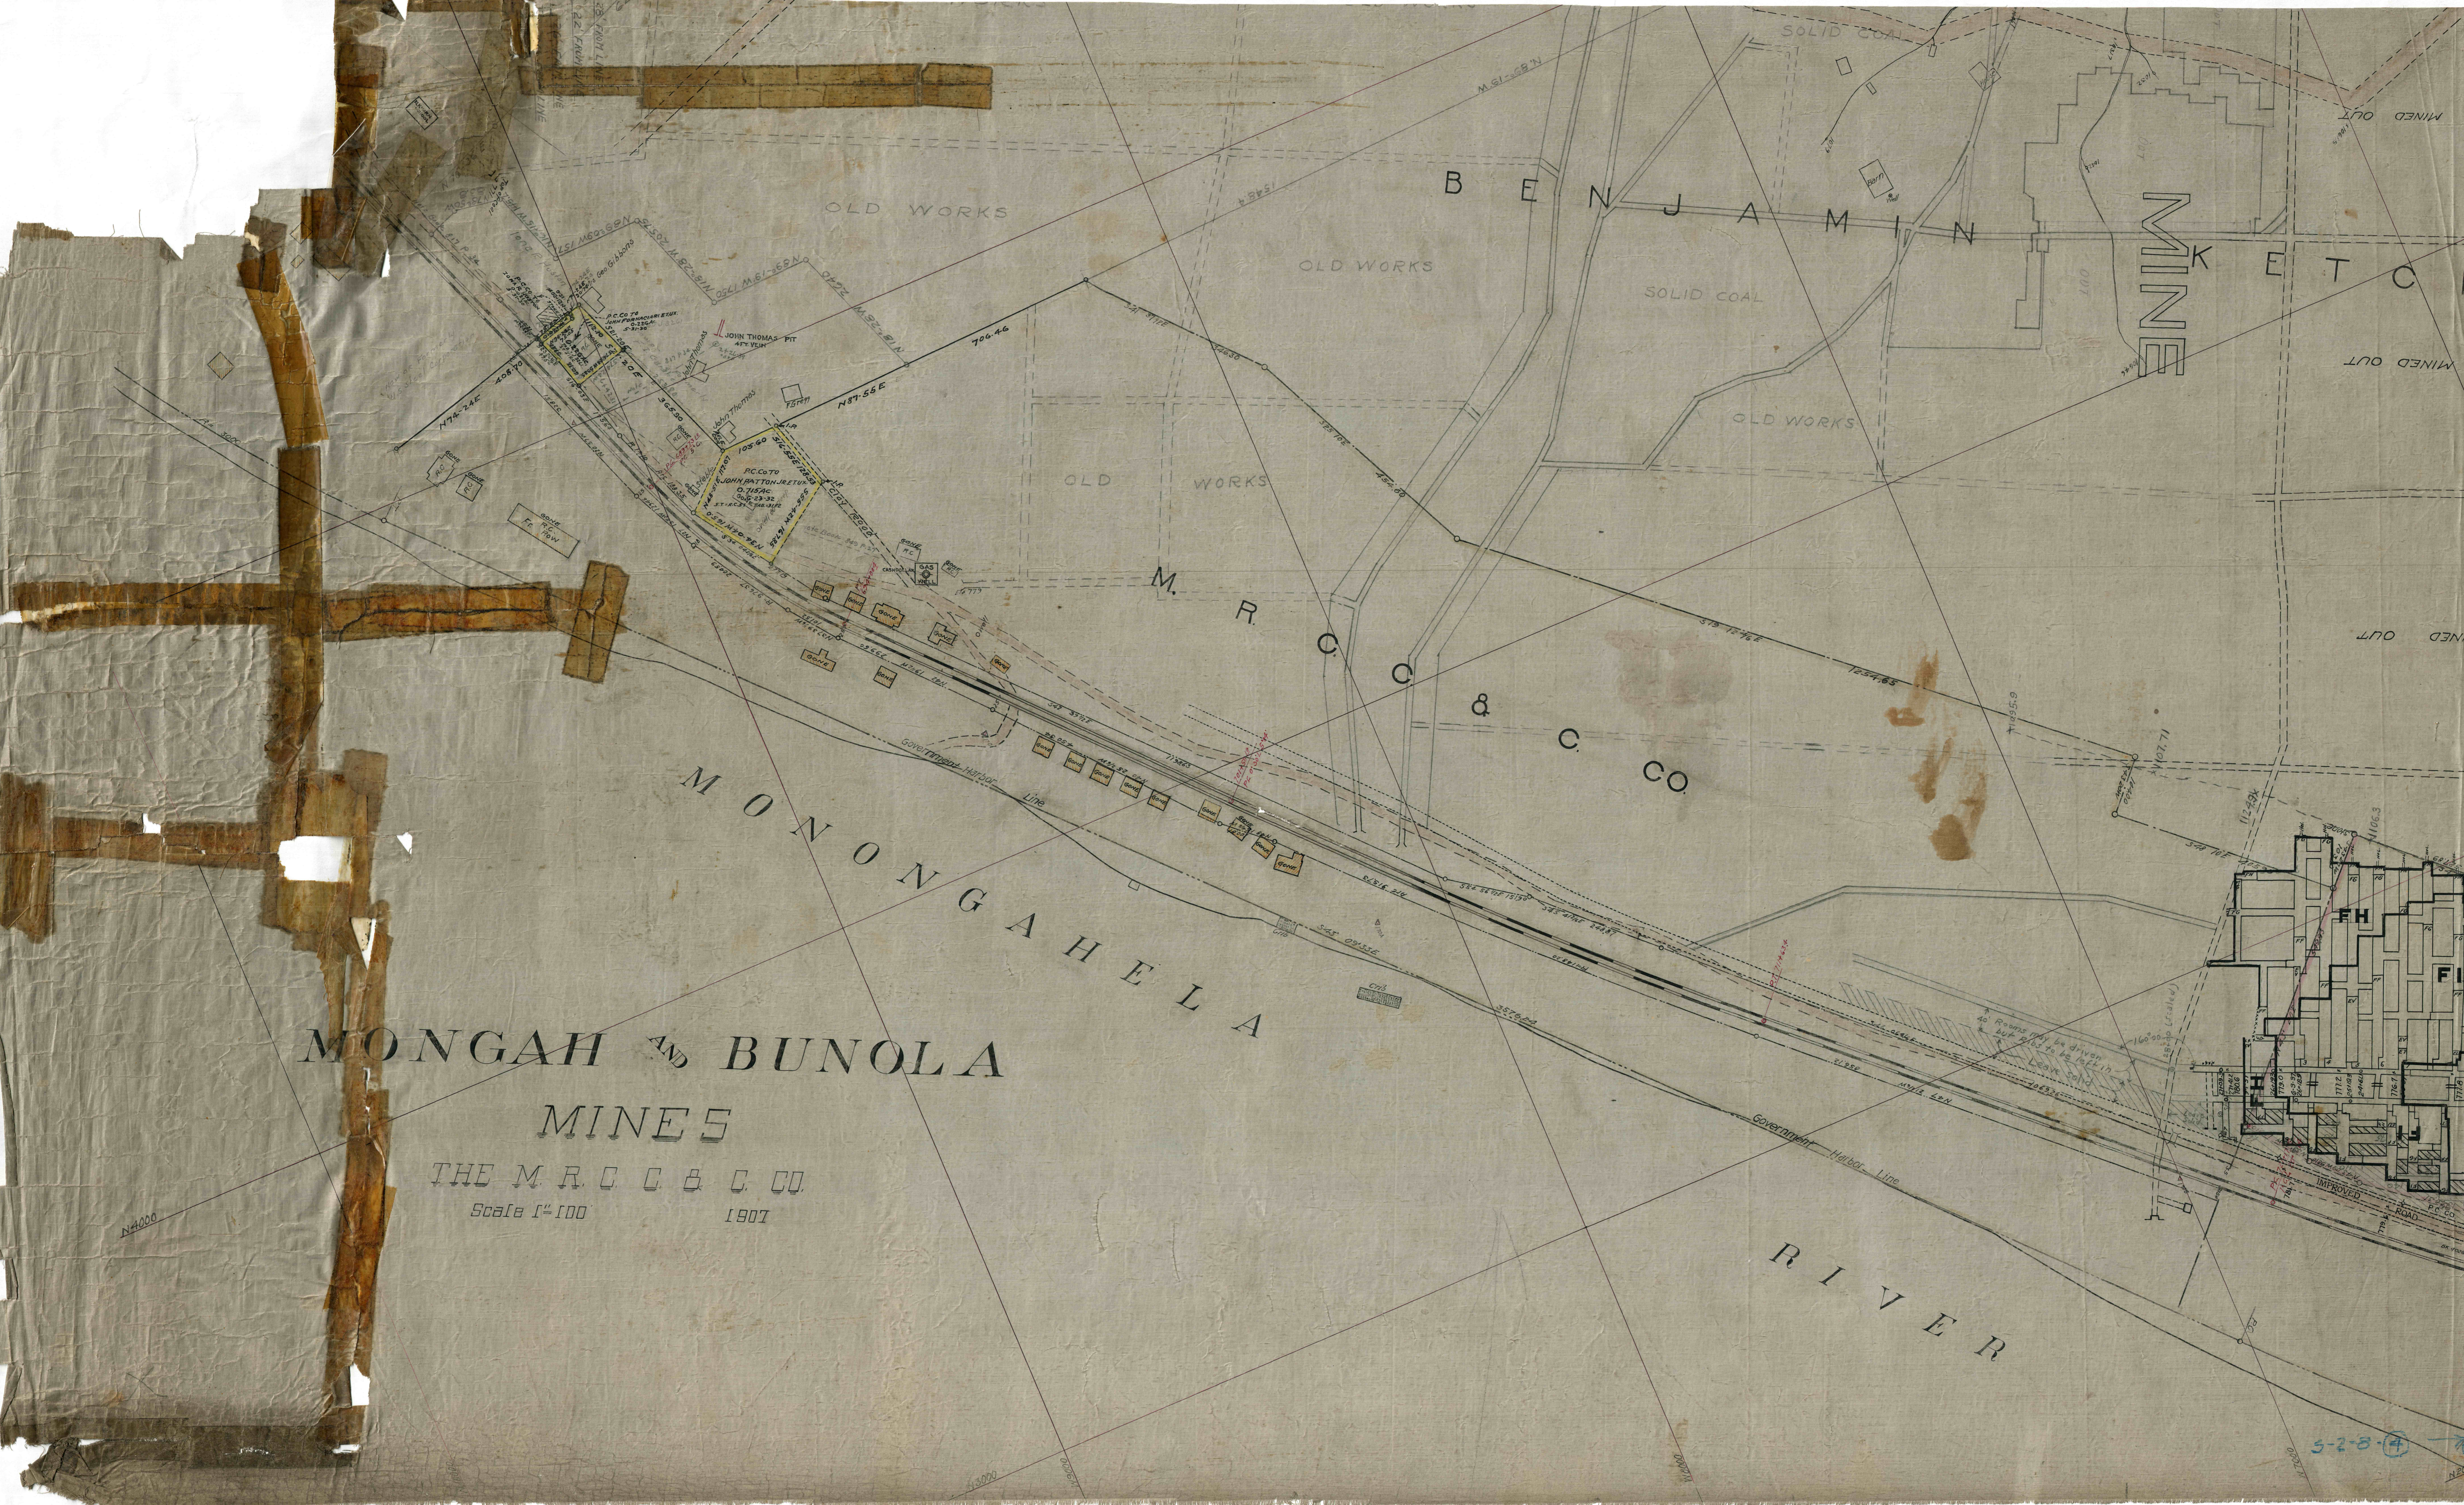

5-2-8-4