

CHARTERS VALLEY R.R.

JAS. DICKSON
1.55 ACRES P.C. COAL
PART OF THE 112 ACRES 3PER




50 COVER LINE

MONT #4 MINE
1"=100'
WORKINGS AS OF 1-14-49

BLACK TOB ROAD

BOUNDARY LINE

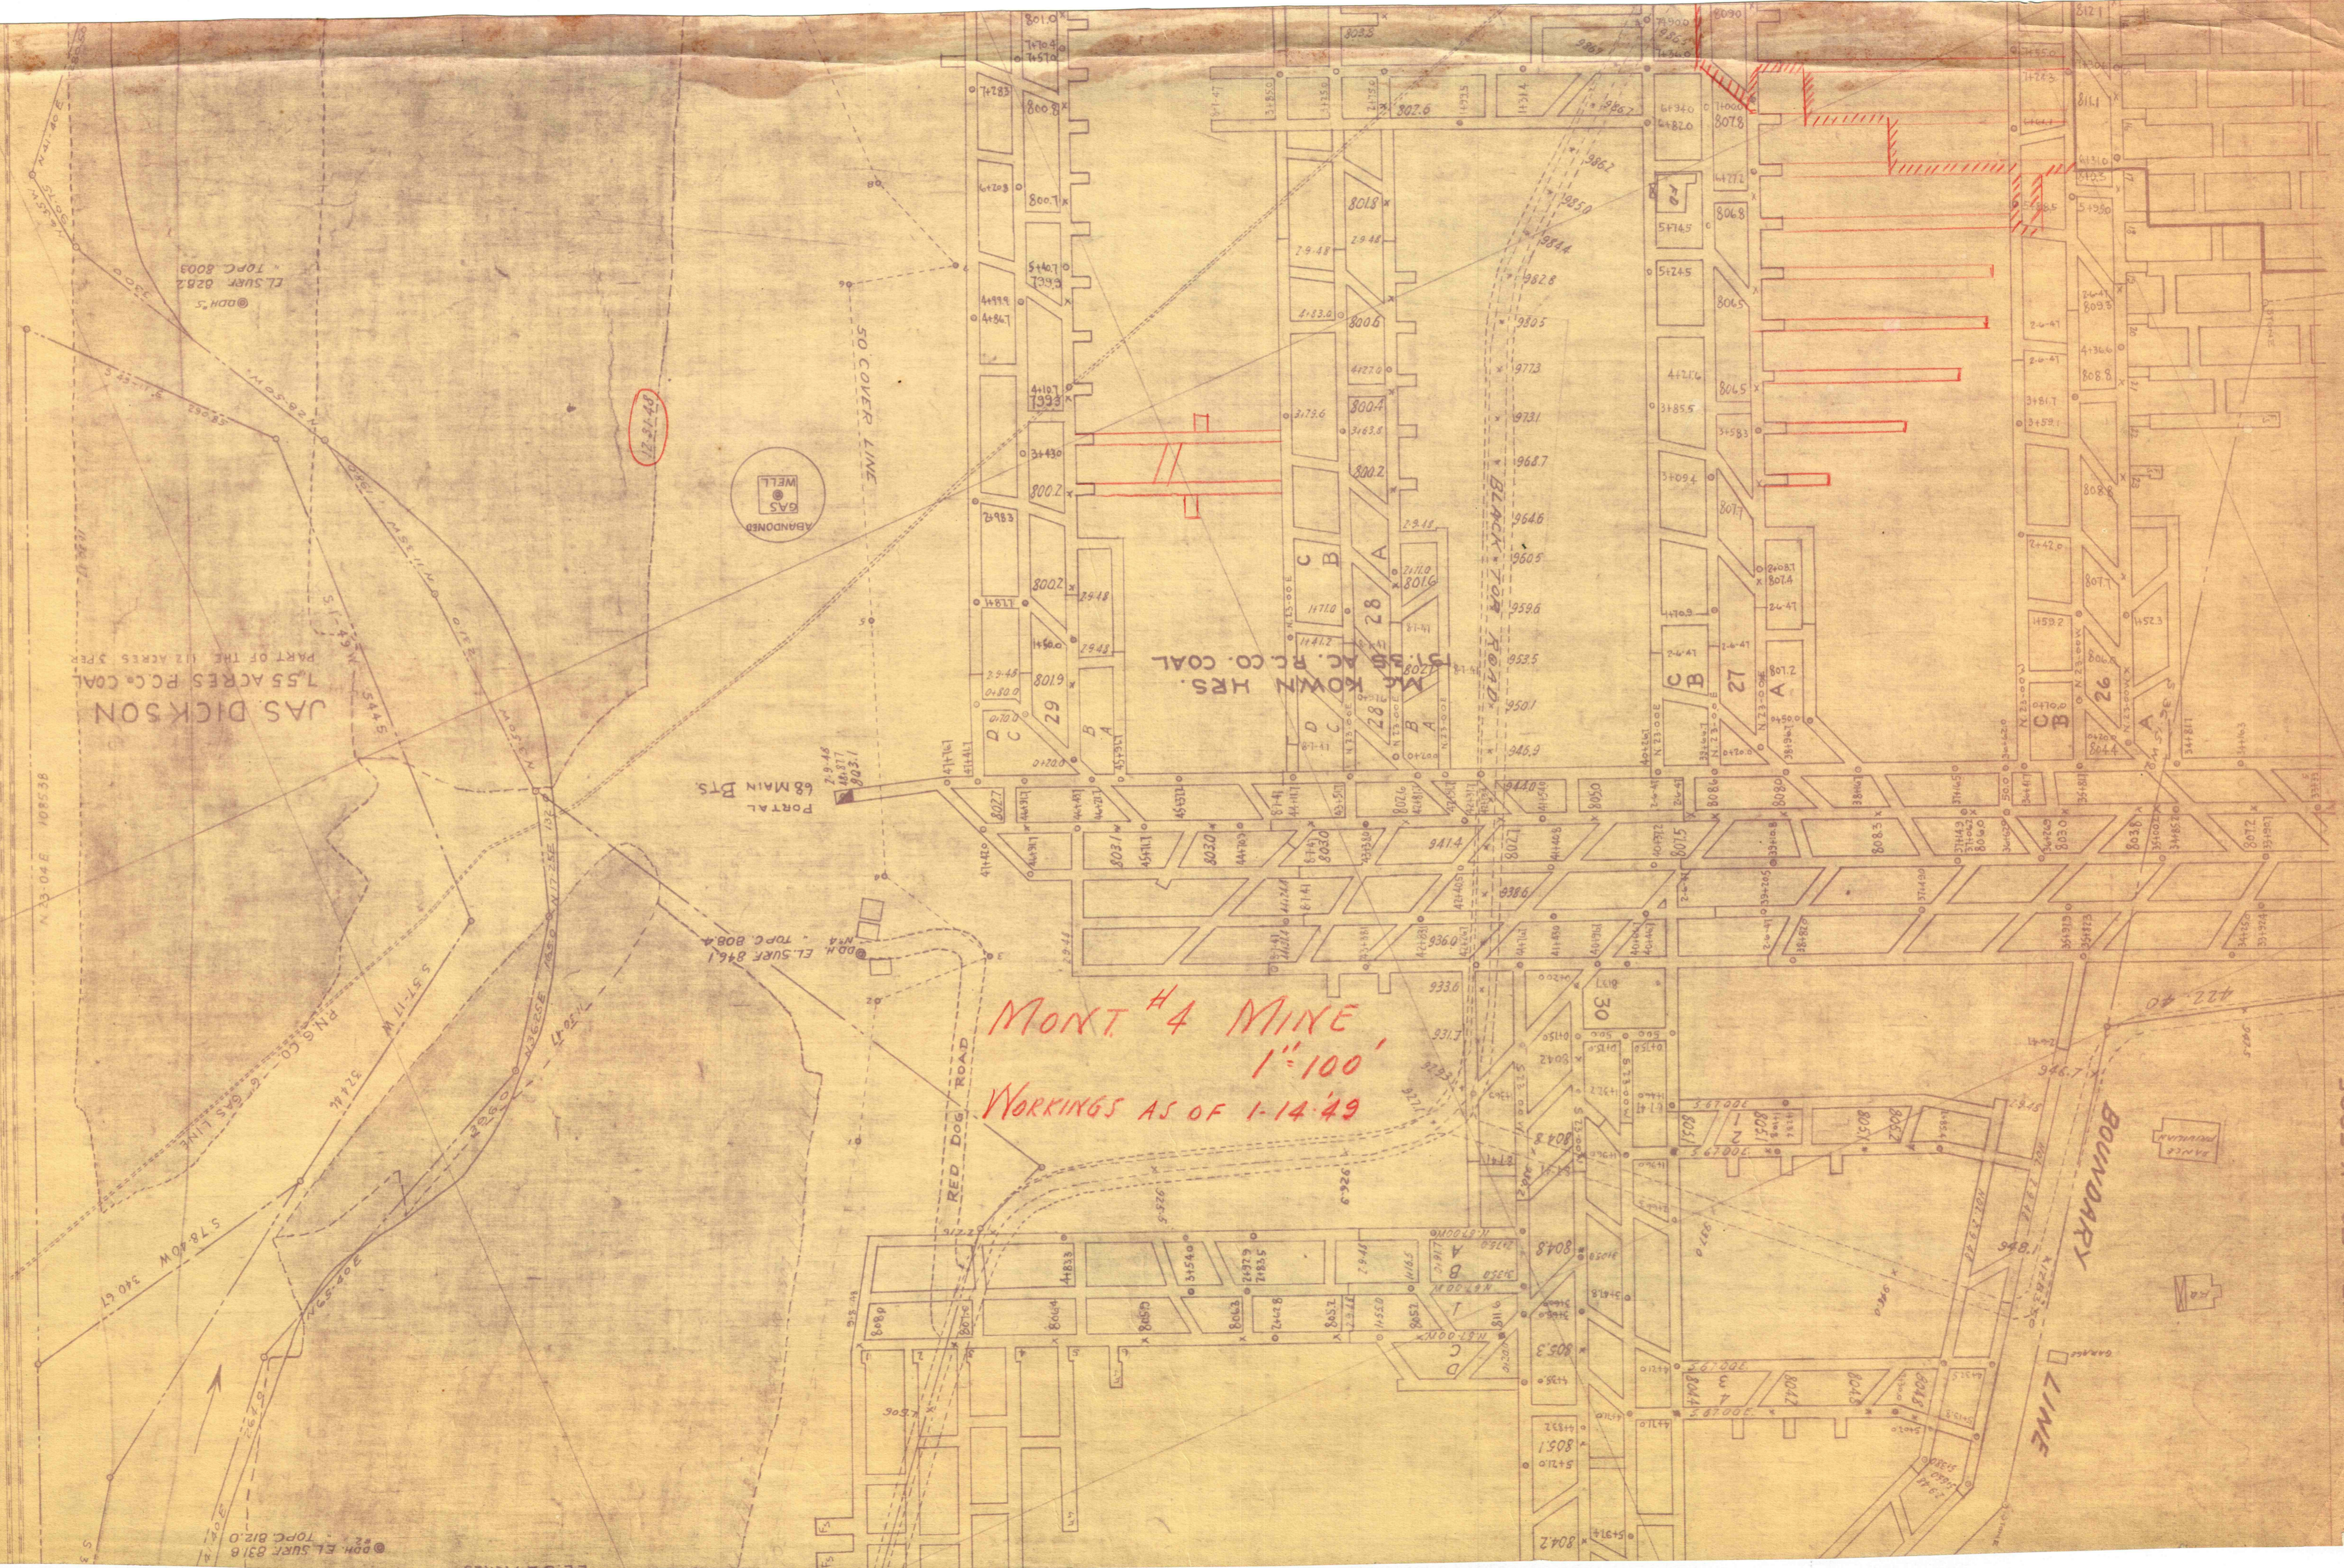

CL SURF. 8282
TOPC. 8003
@BDH'S

N. 33-04 E 108538

615191 W 70323 S

S 78-40 W 340 61

S 57-11 W 374 41

@BDH. EL SURF. 8318
TOPC. 812.0

EL SURF. 8461
TOPC. 8084

PORTAL DTS
68 MAIN DTS

J.M. KOWIN MRS.
P.C. CO. COAL

5025 K-5205