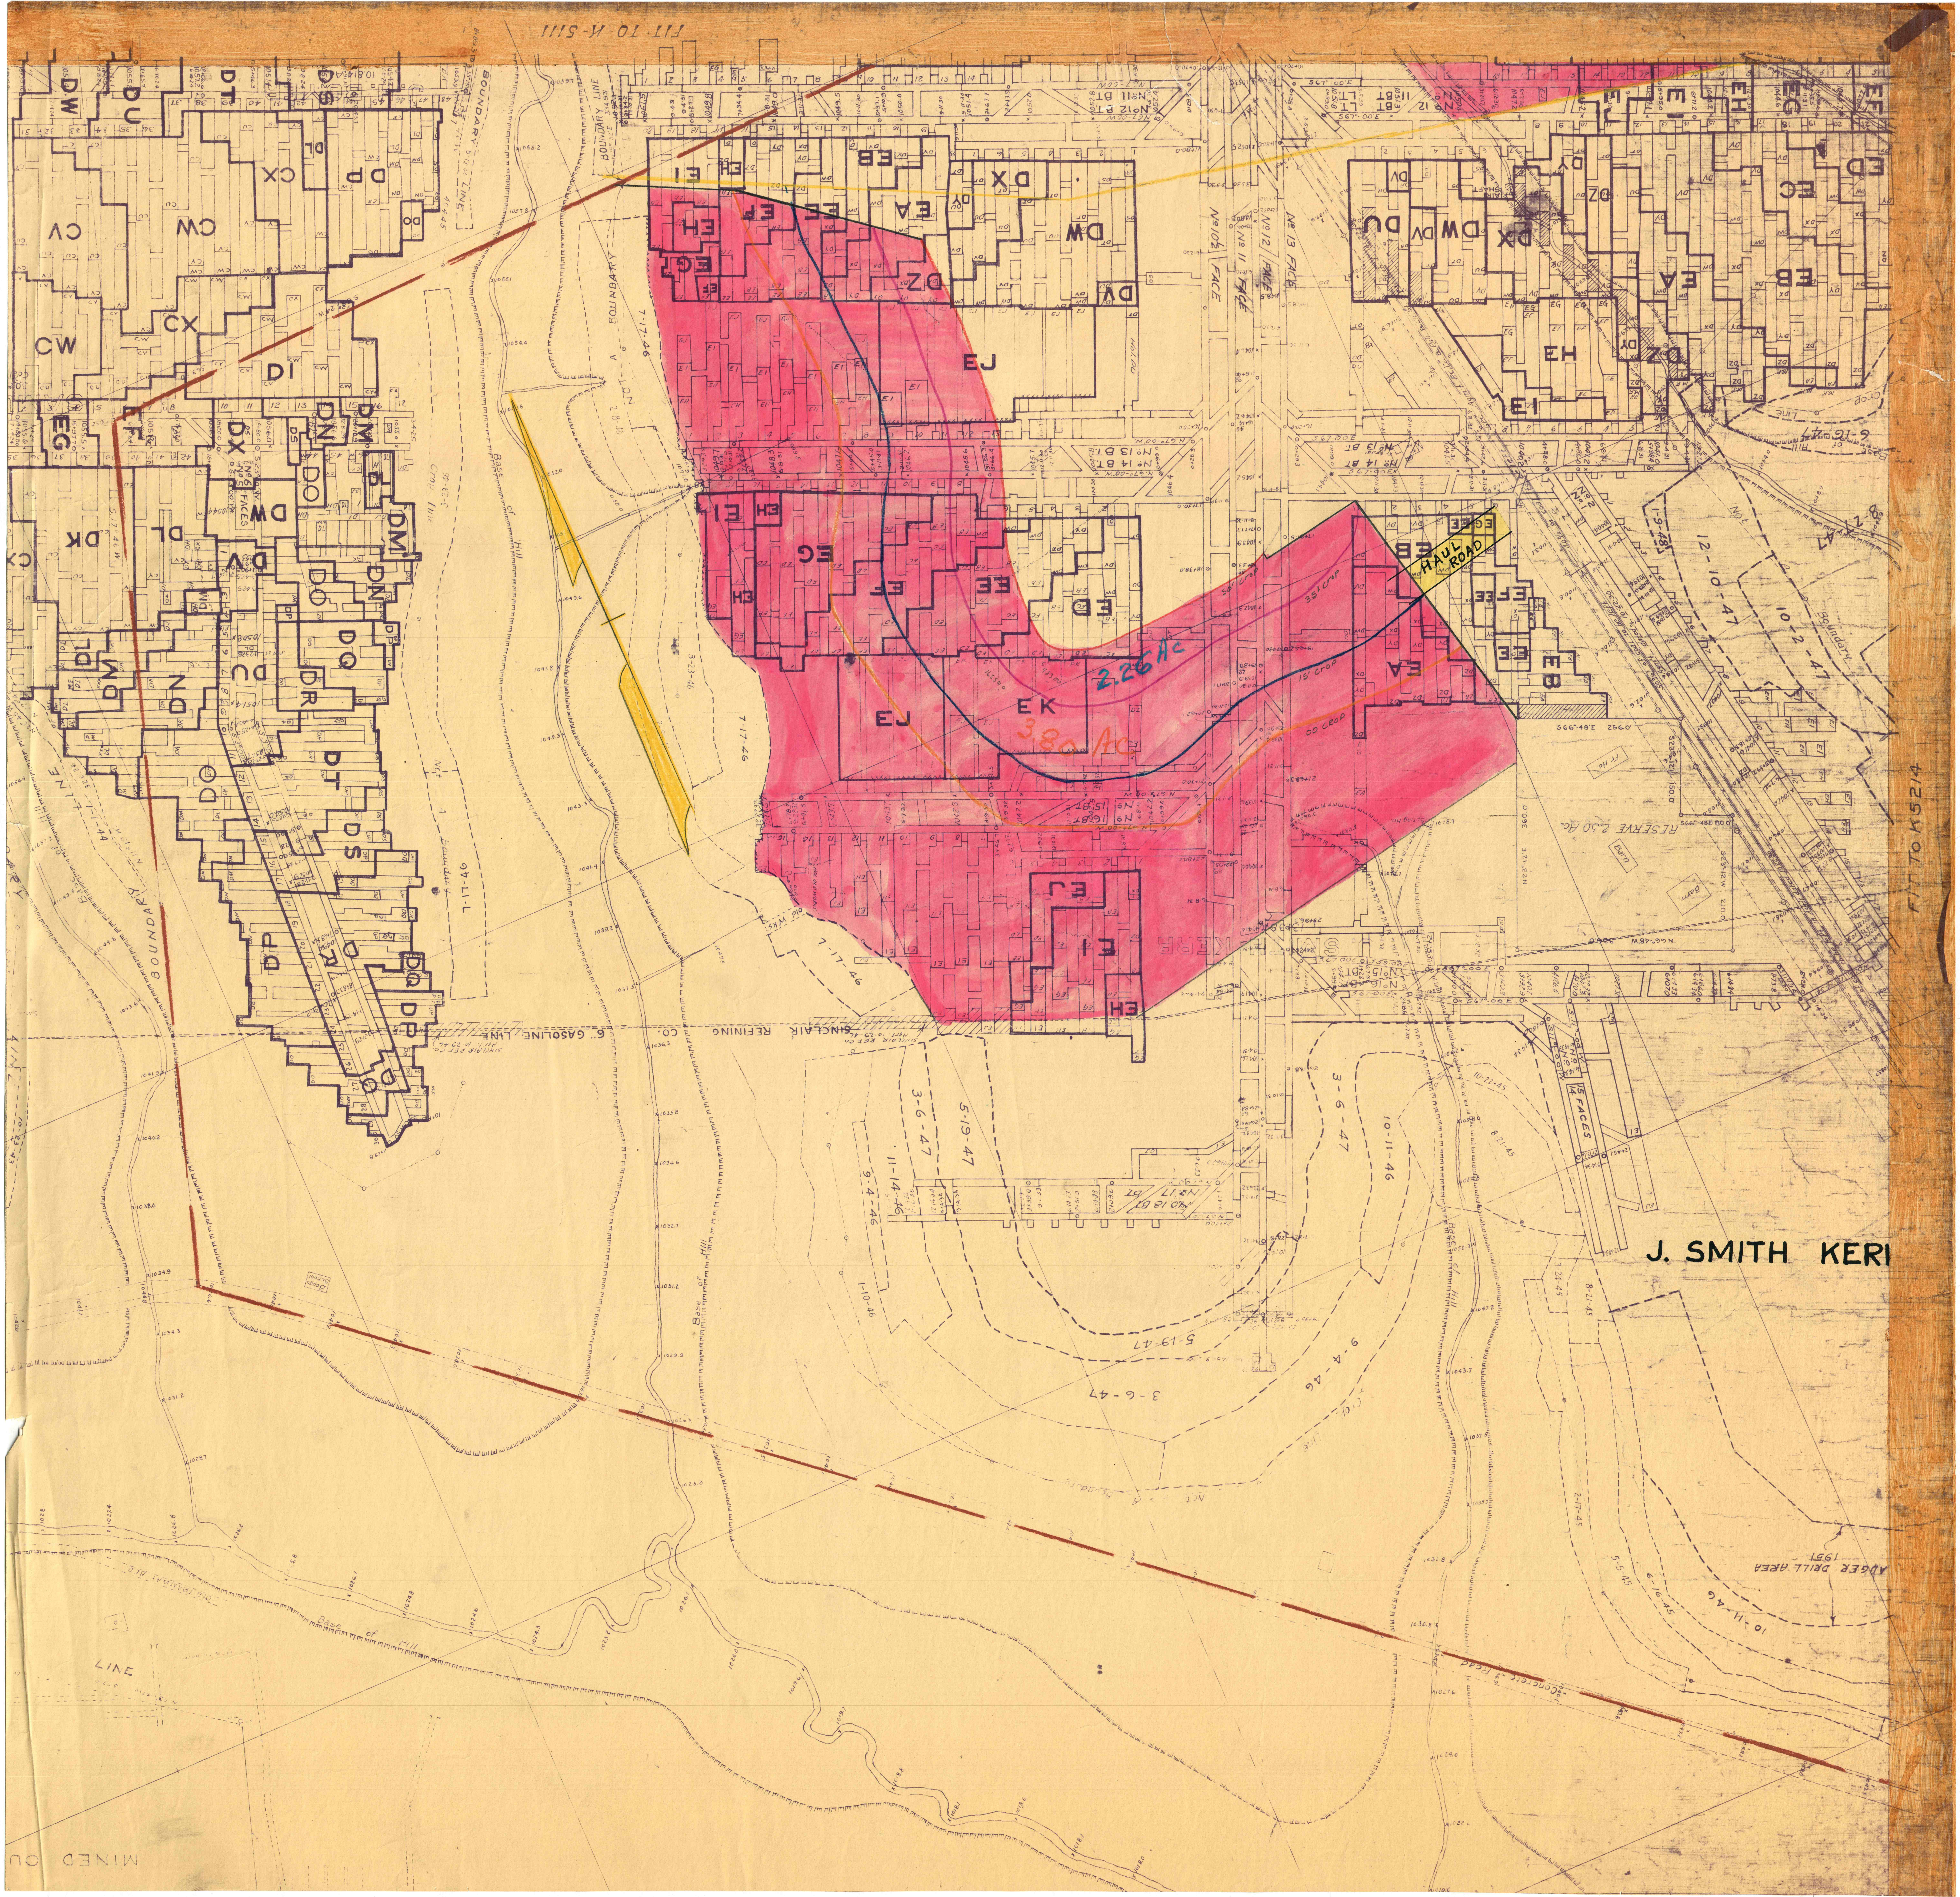
FIT TO K-5111
BOUNDARY LINE
HAUL ROAD
2.26 Ac
3.80 Ac
6" GASOLINE LINE
SINCLAIR REFINING CO.
RESERVE 2.50 Ac.
Barn
15 14 FACES
J. SMITH KERI
AUGER DRILL AREA 1951
Base of Hill
OLD TRAMWAY BED
Concrete Road
MINED OU
FIT TO K5214