
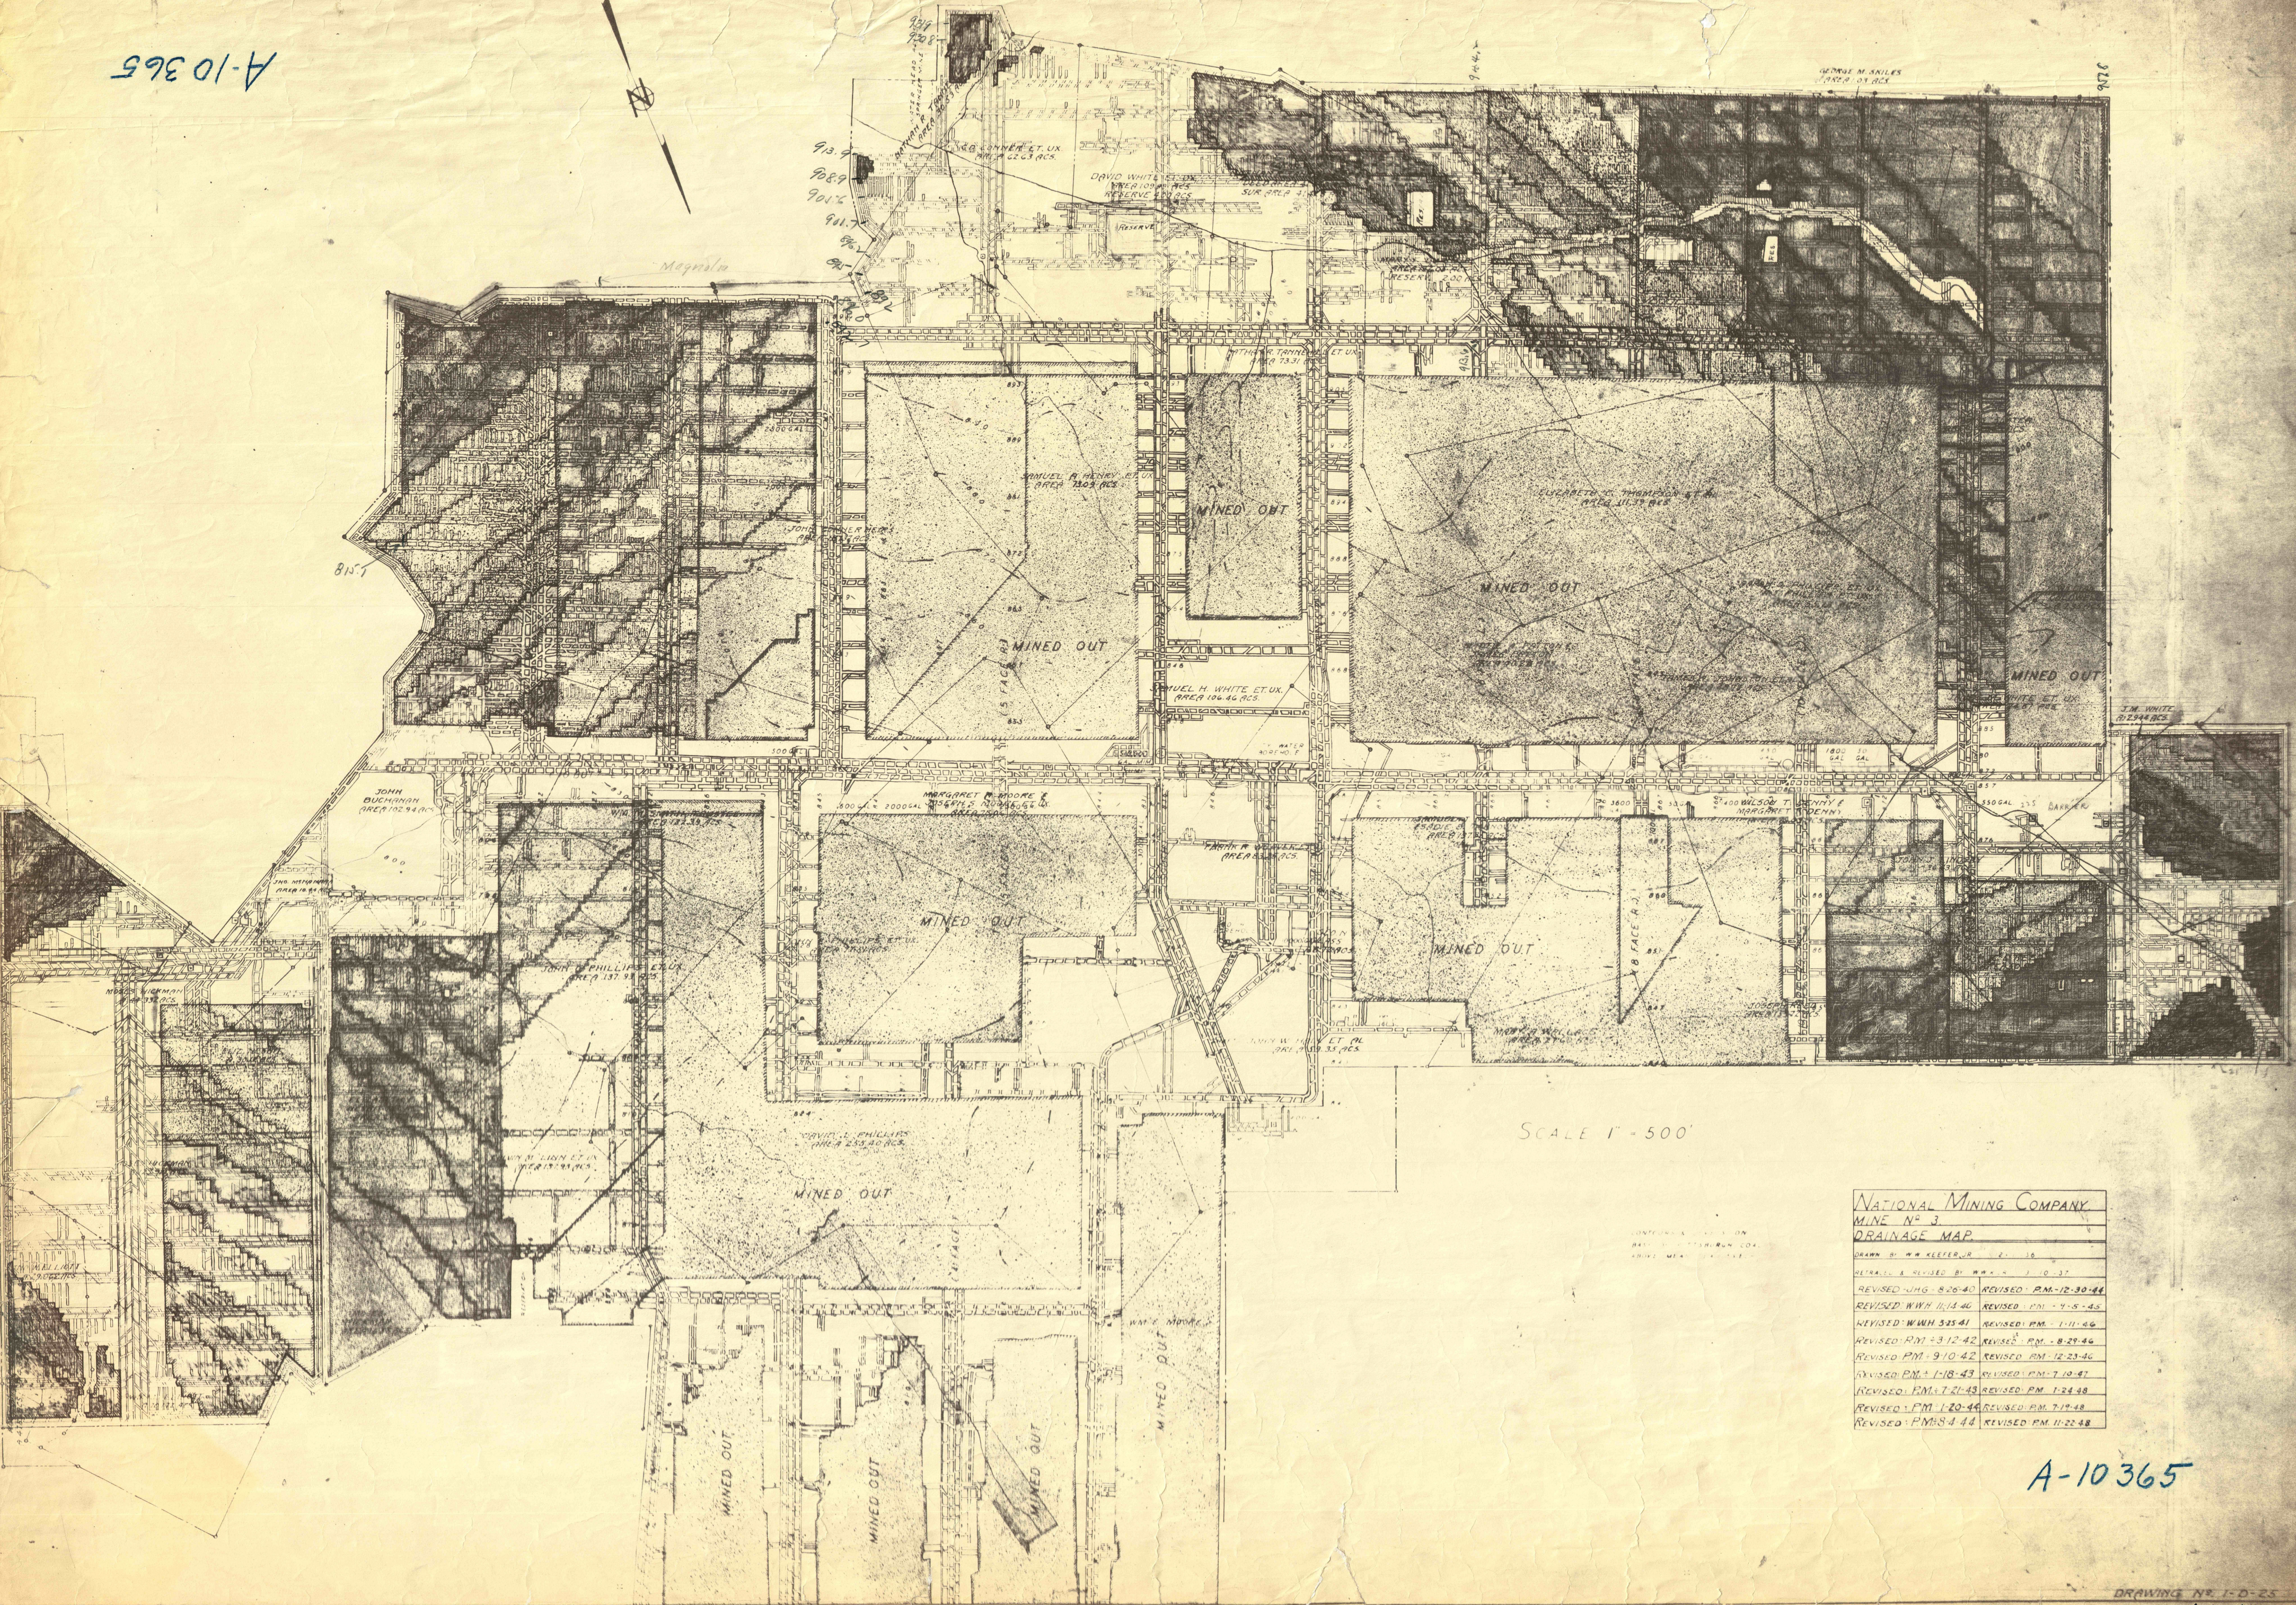


A-10365

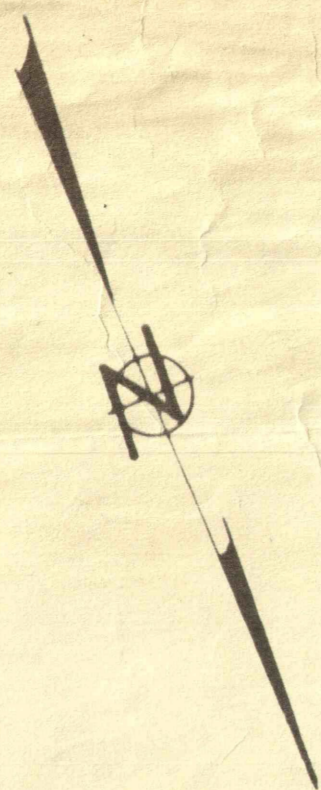

SCALE 1" = 500'

|                                       |                       |
|---------------------------------------|-----------------------|
| NATIONAL MINING COMPANY               |                       |
| MINE NO. 3                            |                       |
| DRAINAGE MAP                          |                       |
| DRAWN BY W.W. KEETER, JR. 2-16        |                       |
| RETRACED & REVISED BY W.W. K. 1-10-37 |                       |
| REVISED W.W.K. 8-26-40                | REVISED P.M. 12-30-44 |
| REVISED W.W.K. 11-14-40               | REVISED P.M. 7-5-45   |
| REVISED W.W.K. 5-25-41                | REVISED P.M. 1-11-46  |
| REVISED P.M. 3-12-42                  | REVISED P.M. 8-29-46  |
| REVISED P.M. 9-10-42                  | REVISED P.M. 12-23-46 |
| REVISED P.M. 1-18-43                  | REVISED P.M. 7-10-47  |
| REVISED P.M. 7-21-43                  | REVISED P.M. 1-24-48  |
| REVISED P.M. 1-20-44                  | REVISED P.M. 7-19-48  |
| REVISED P.M. 4-44                     | REVISED P.M. 11-22-48 |

A-10365