


Cross Section

350 Feet East
of Newkirk Slope.

Scale 1" = 300' - Pottsville, Jan, 1907-

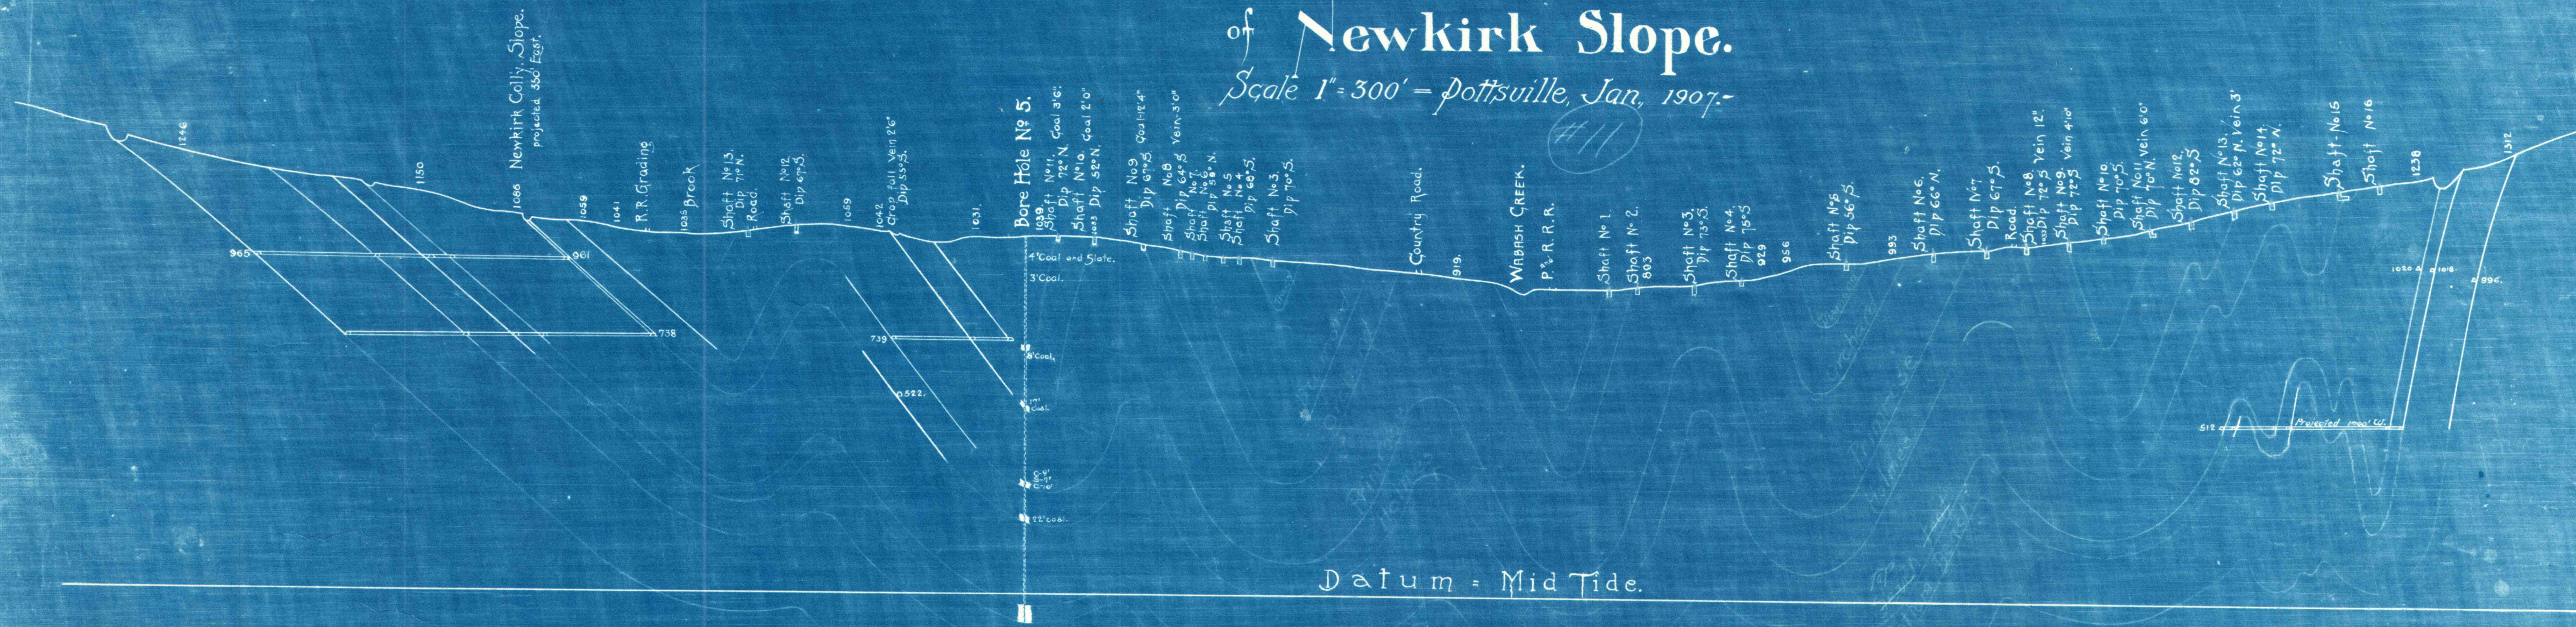

Datum = Mid Tide.