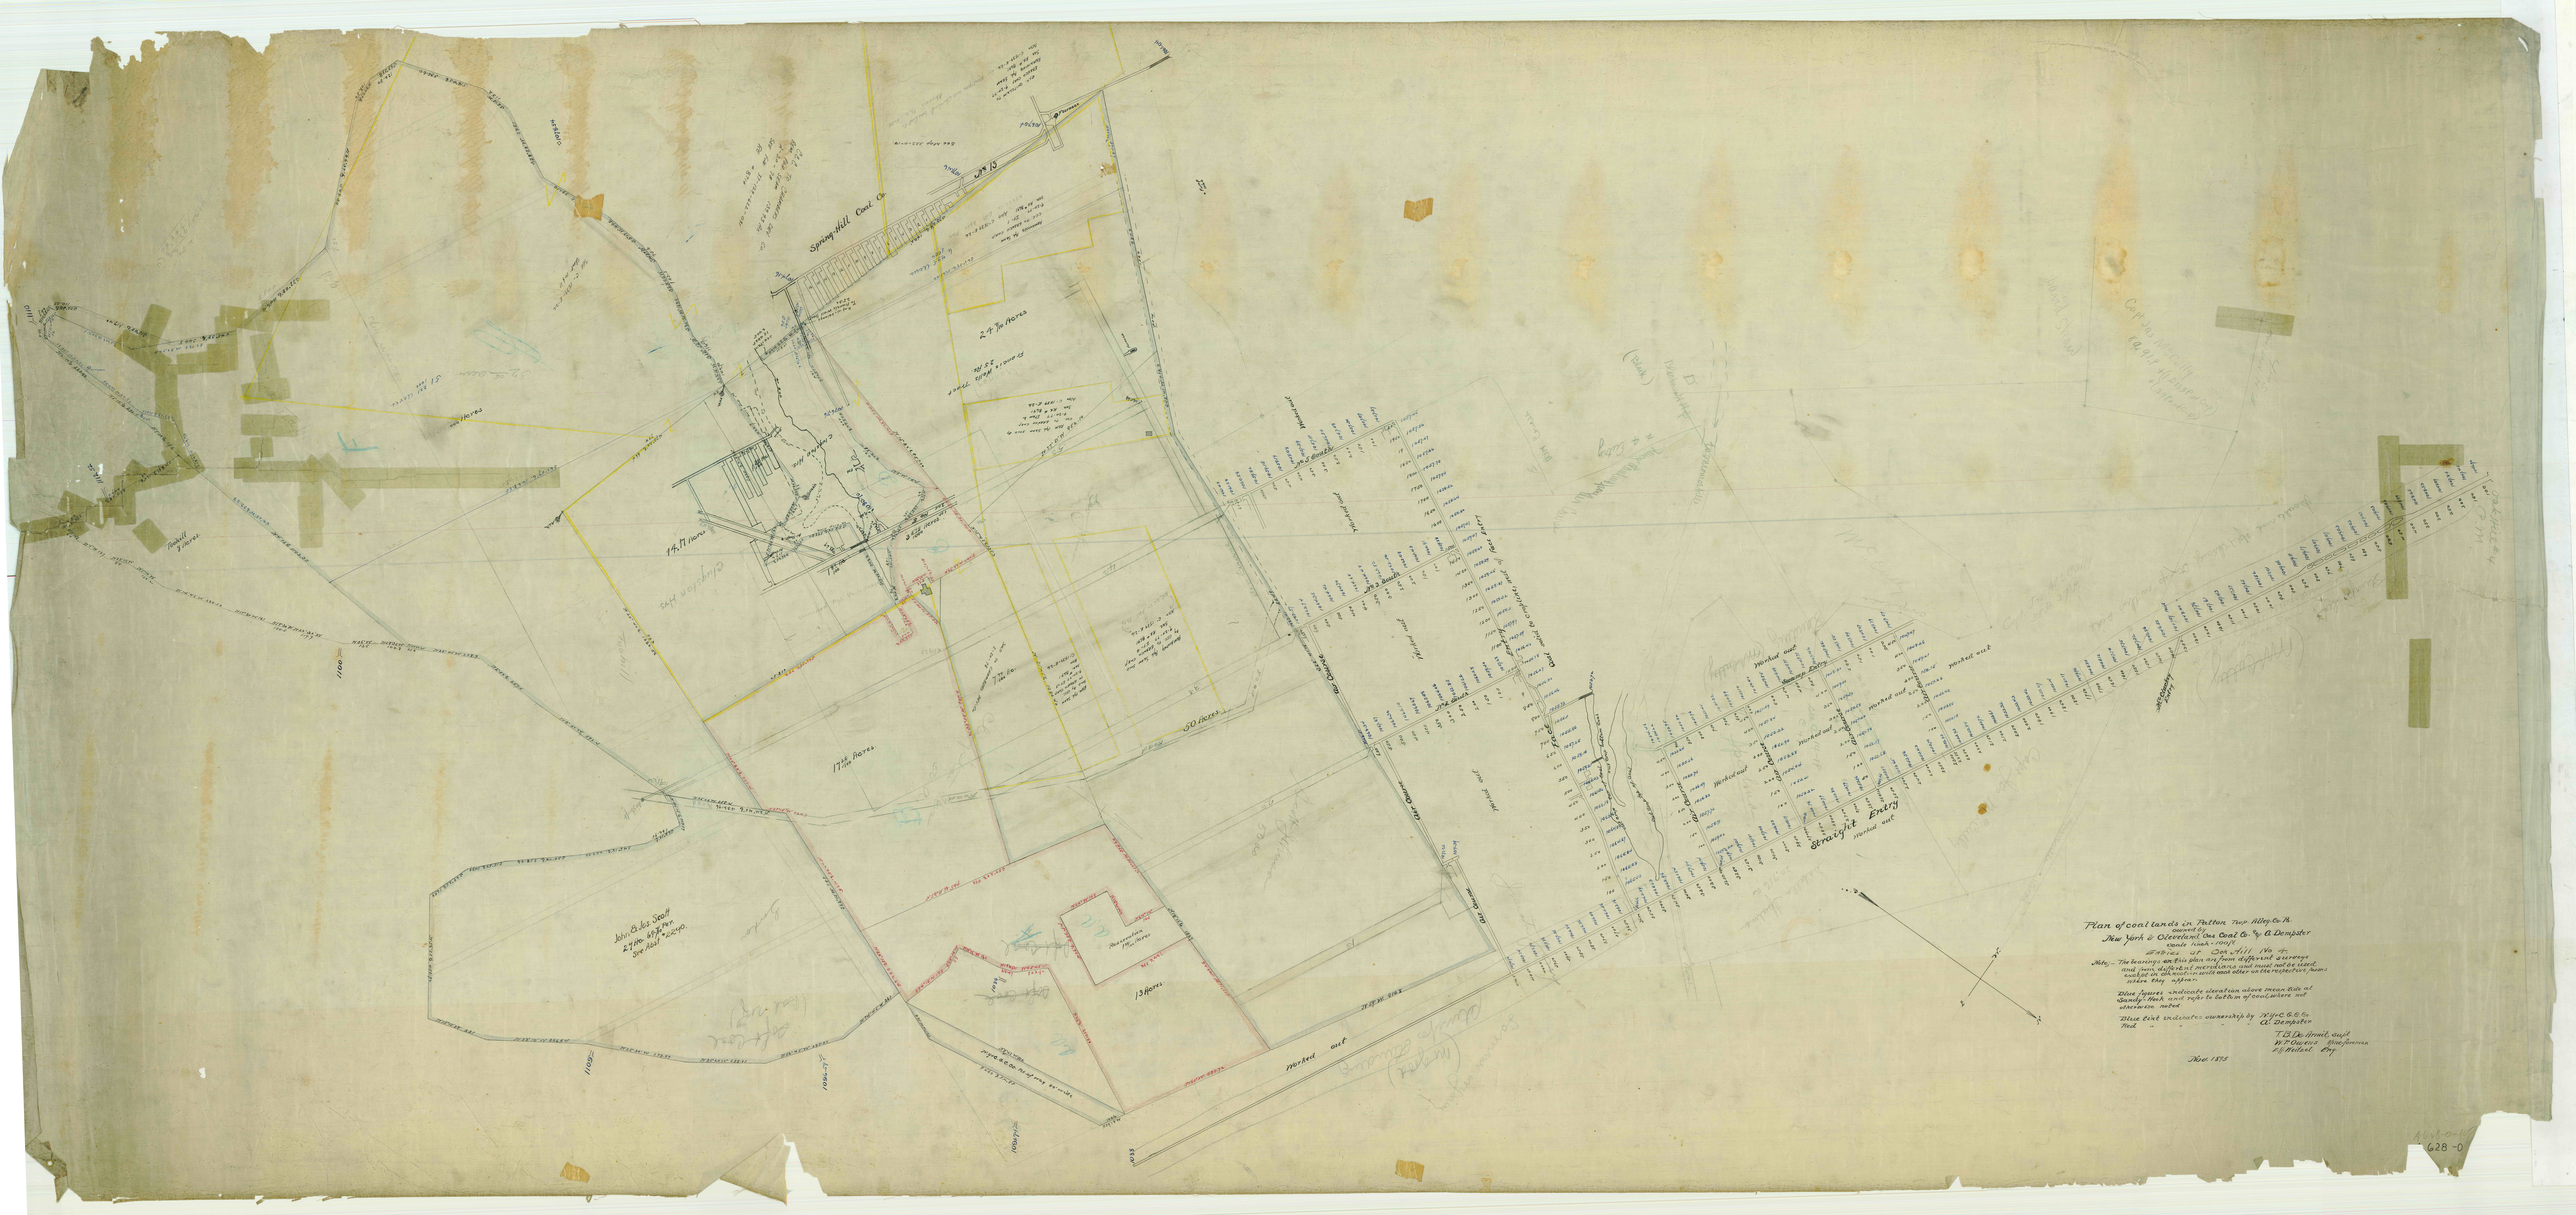
Spring Hill Coal Co
Straight Entry
Marked out
Plan of coal lands in Patton Twp Allg Co Pa
owned by
New York & Cleveland Gas Coal Co
by A. Dempster
scale 1 inch = 100 ft
Surveyed Oct 20th 1873 by T.E.
Note. The bearings on this plan are from different surveys and from different meridians and must not be used except on the meridian and near other to the respective lines they appear.
Blue figures indicate elevation above mean tide of Sandy Hook and refer to bottom of coal where not otherwise noted
Blue tint indicates ownership by N.Y.C.G.C.Co
A. Dempster
Red "
T.E. Dr. Hood, Asst
W.P. Owens Draftsman
J.B. Hedsel Eng
Nov 1873