


see A 633-0-14
for Cunningham

Wm Cunningham - Coal Worked out

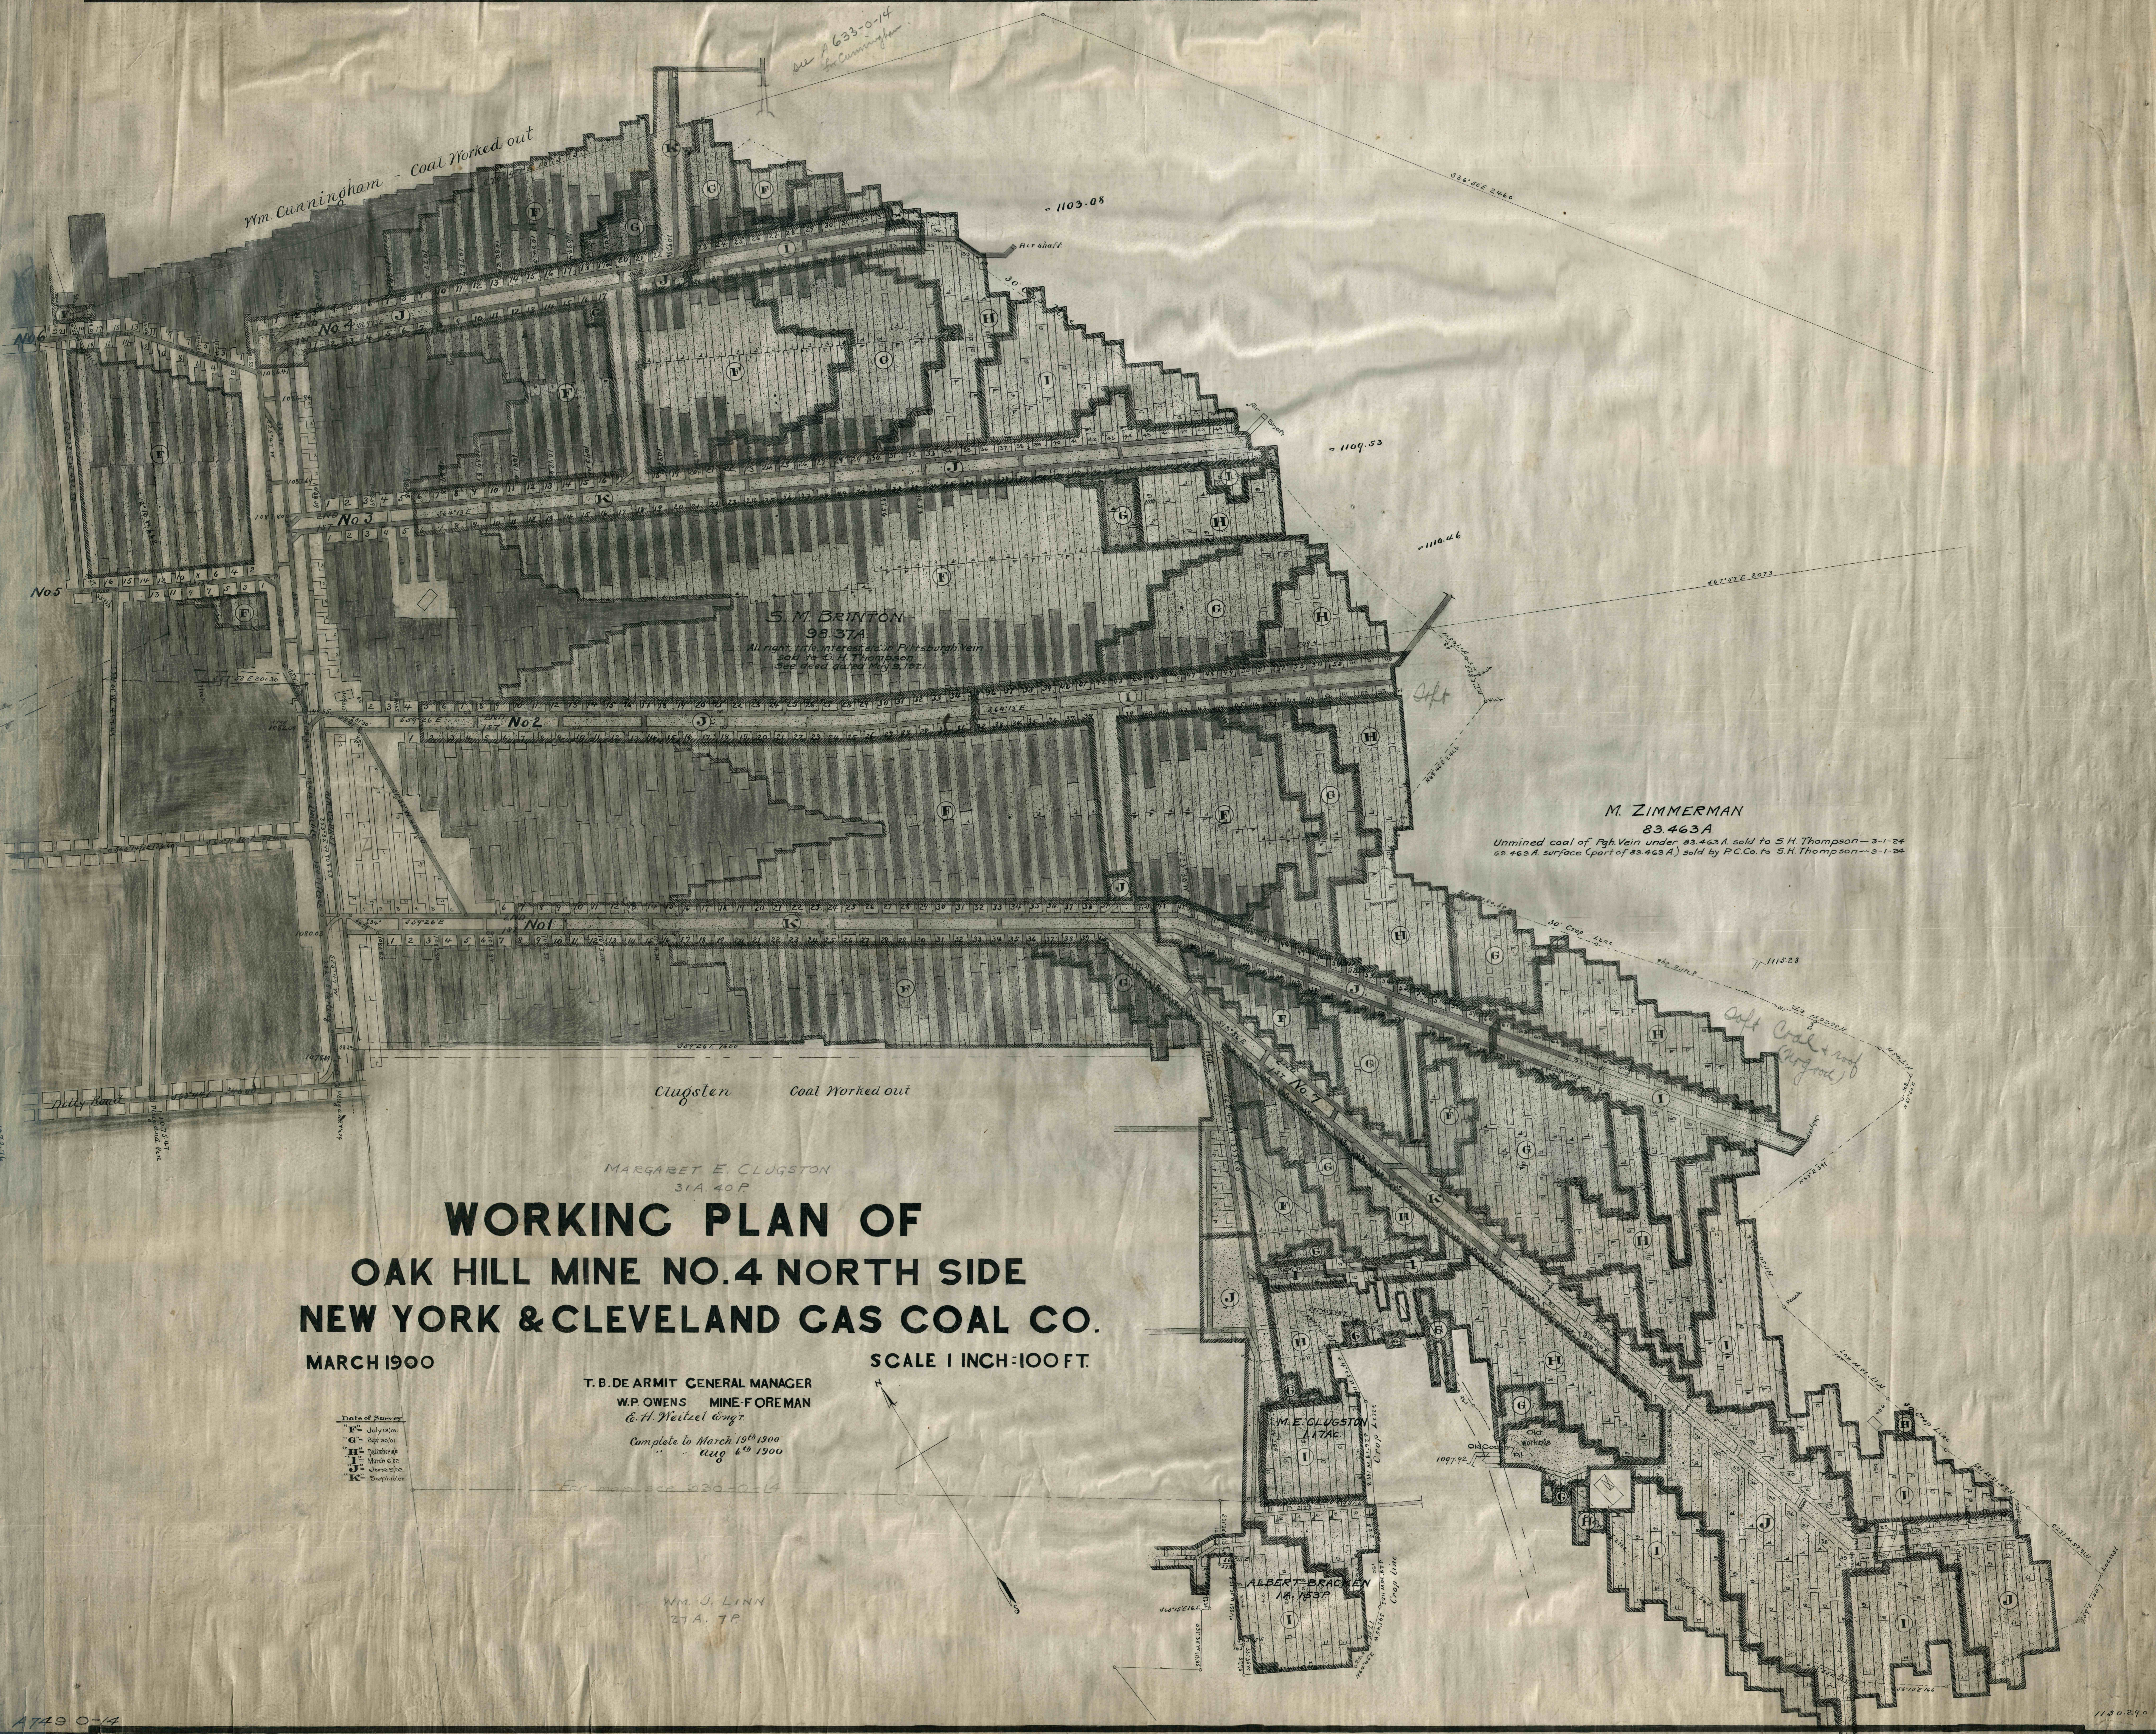

**WORKING PLAN OF
OAK HILL MINE NO.4 NORTH SIDE
NEW YORK & CLEVELAND GAS COAL CO.
MARCH 1900**

SCALE 1 INCH=100 FT.

T.B. DE ARMIT GENERAL MANAGER
W.P. OWENS MINE-FOREMAN
E.H. Weikel Engr.

Complete to March 19th 1900
" " Aug 6th 1900

- Date of Survey
- F July 1900
 - G Sept 2001
 - H November
 - I March 1900
 - J June 1900
 - K September

For map see 833-0-14

WM J. LINN
27A. 7P

M. ZIMMERMAN
83.463A
Unmined coal of Pgt Vein under 83.463A sold to S.H. Thompson-3-1-24
83.463A surface (part of 83.463A) sold by P.C.Co. to S.H. Thompson-3-1-24

MARGARET E. CLUGSTON
31A. 40P

M.E. CLUGSTON
17A.C

ALBERT BRACKEN
18. 153P