


WORKING PLAN  
 OF  
 OAK HILL MINE NO. 4.  
 NEW YORK & CLEVELAND GAS COAL CO  
 SCALE 1 INCH = 100 FEET      JAN. 1896

T.B. DEARMIT SUPT.  
 W.P. OWENS MINE FOREMAN  
 E.H. WEITZEL ENG.

See Map 333-0-14

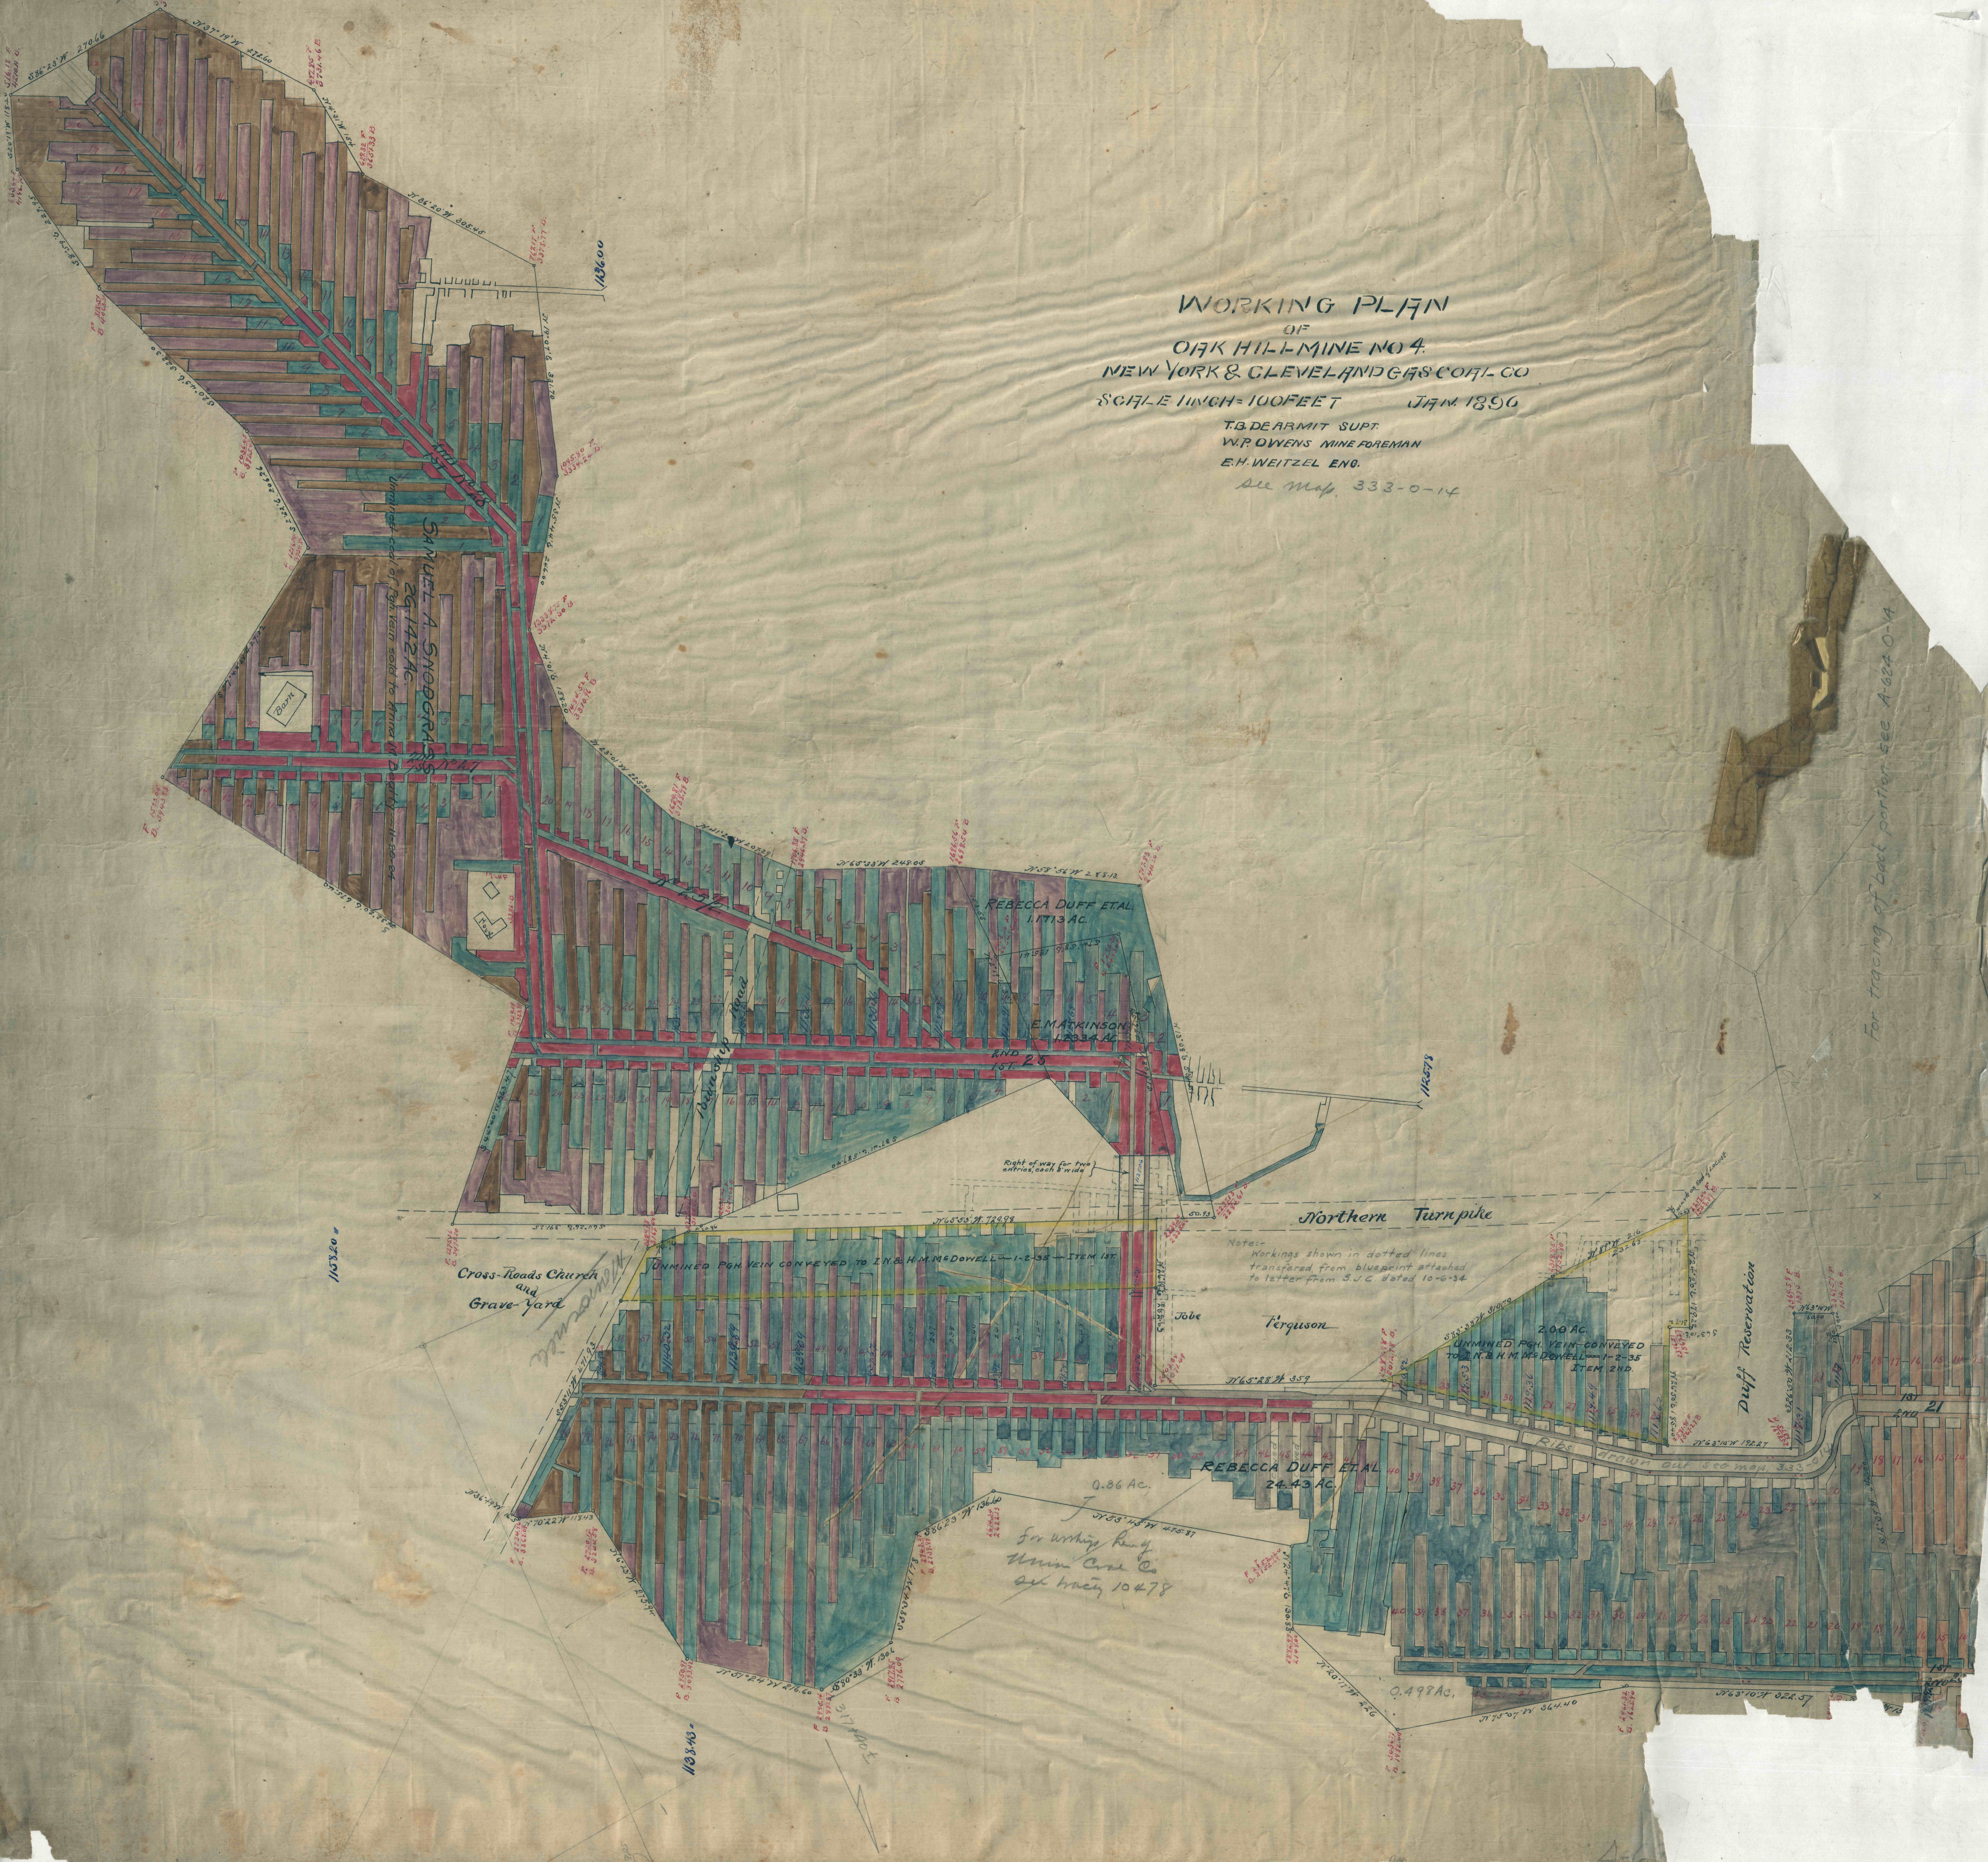

For tracing of back portion see A-624 0-14