


Keep with C-2301-D-10

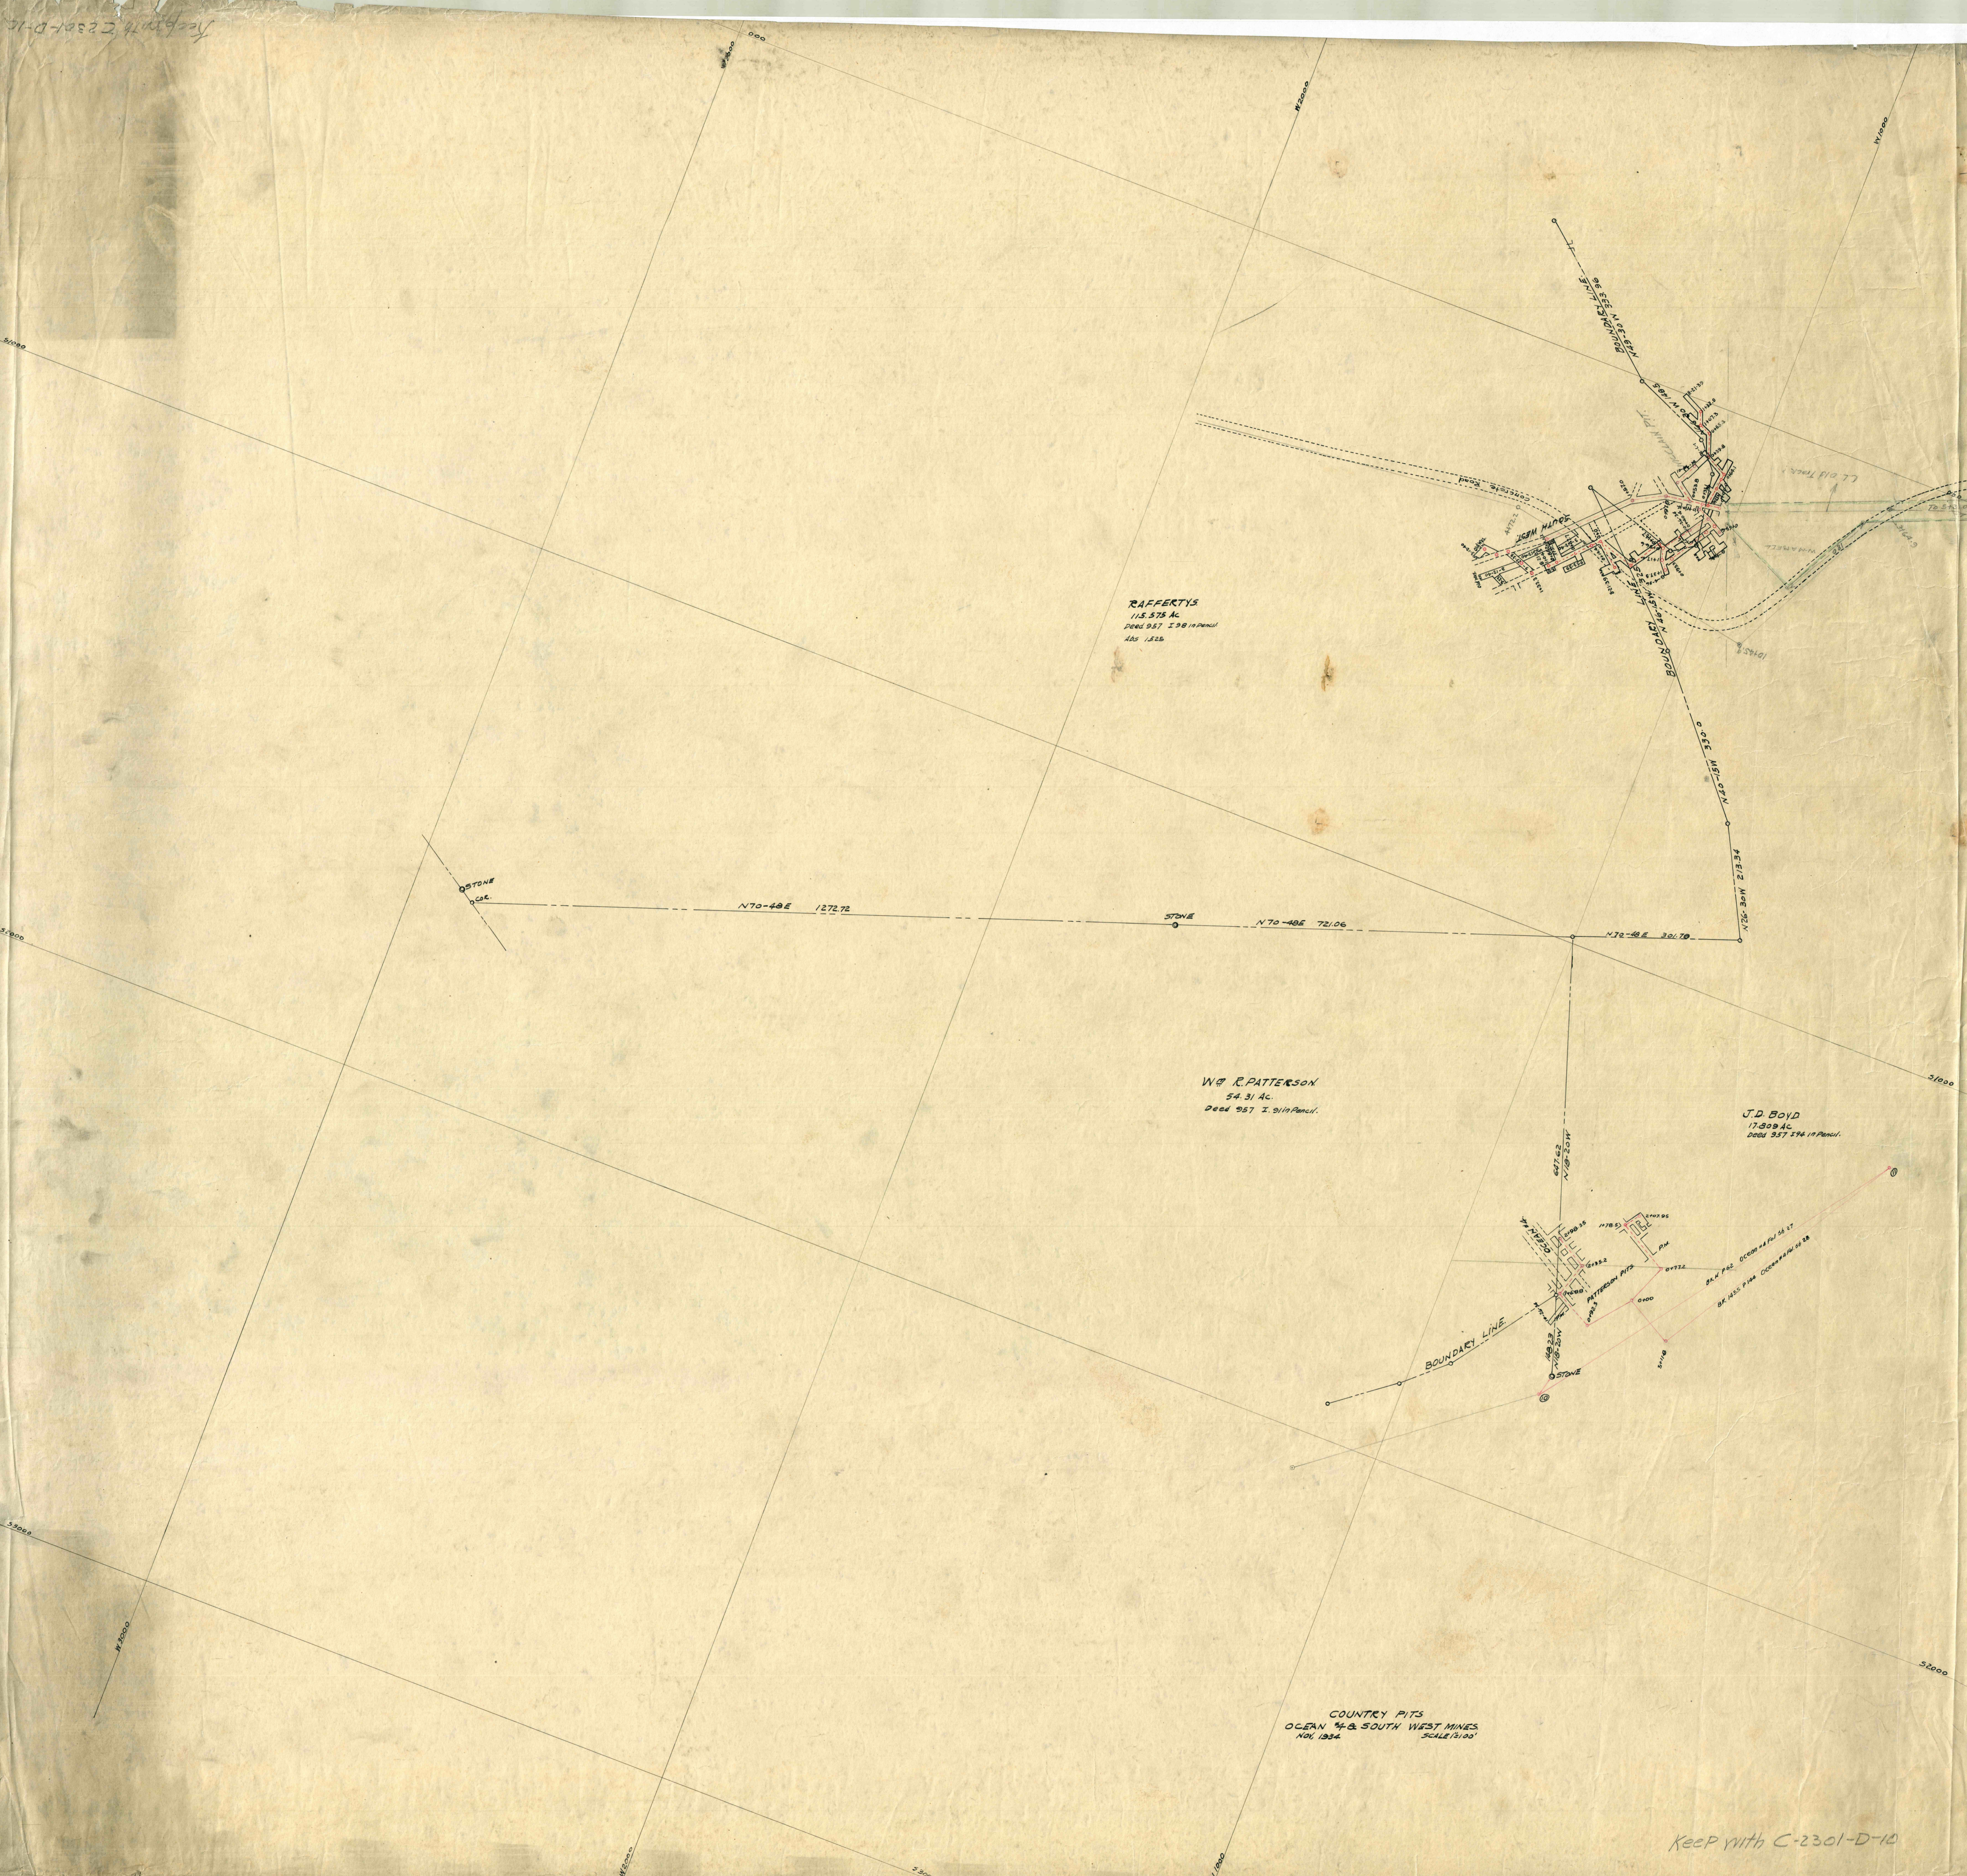

**RAFFERTYS**  
 115.575 Ac.  
 Deed 957 I. 98 in Parcel  
 Abs. 1825

**W.P. PATTERSON**  
 54.31 Ac.  
 Deed 957 I. 91 in Parcel

**J.D. BOYD**  
 17.309 Ac.  
 Deed 957 I. 94 in Parcel

COUNTRY PITS  
 OCEAN 4 & SOUTH WEST MINES  
 NOV. 1894  
 SCALE 1/100'

Keep with C-2301-D-10