


Dec 21/14
Keep with A 35-A-14

[Faint, illegible handwritten notes in pink ink]

SHOOT NEG. TO SCALE 1"=1000'
(SCALE OF THIS MAP IS 1"=100')

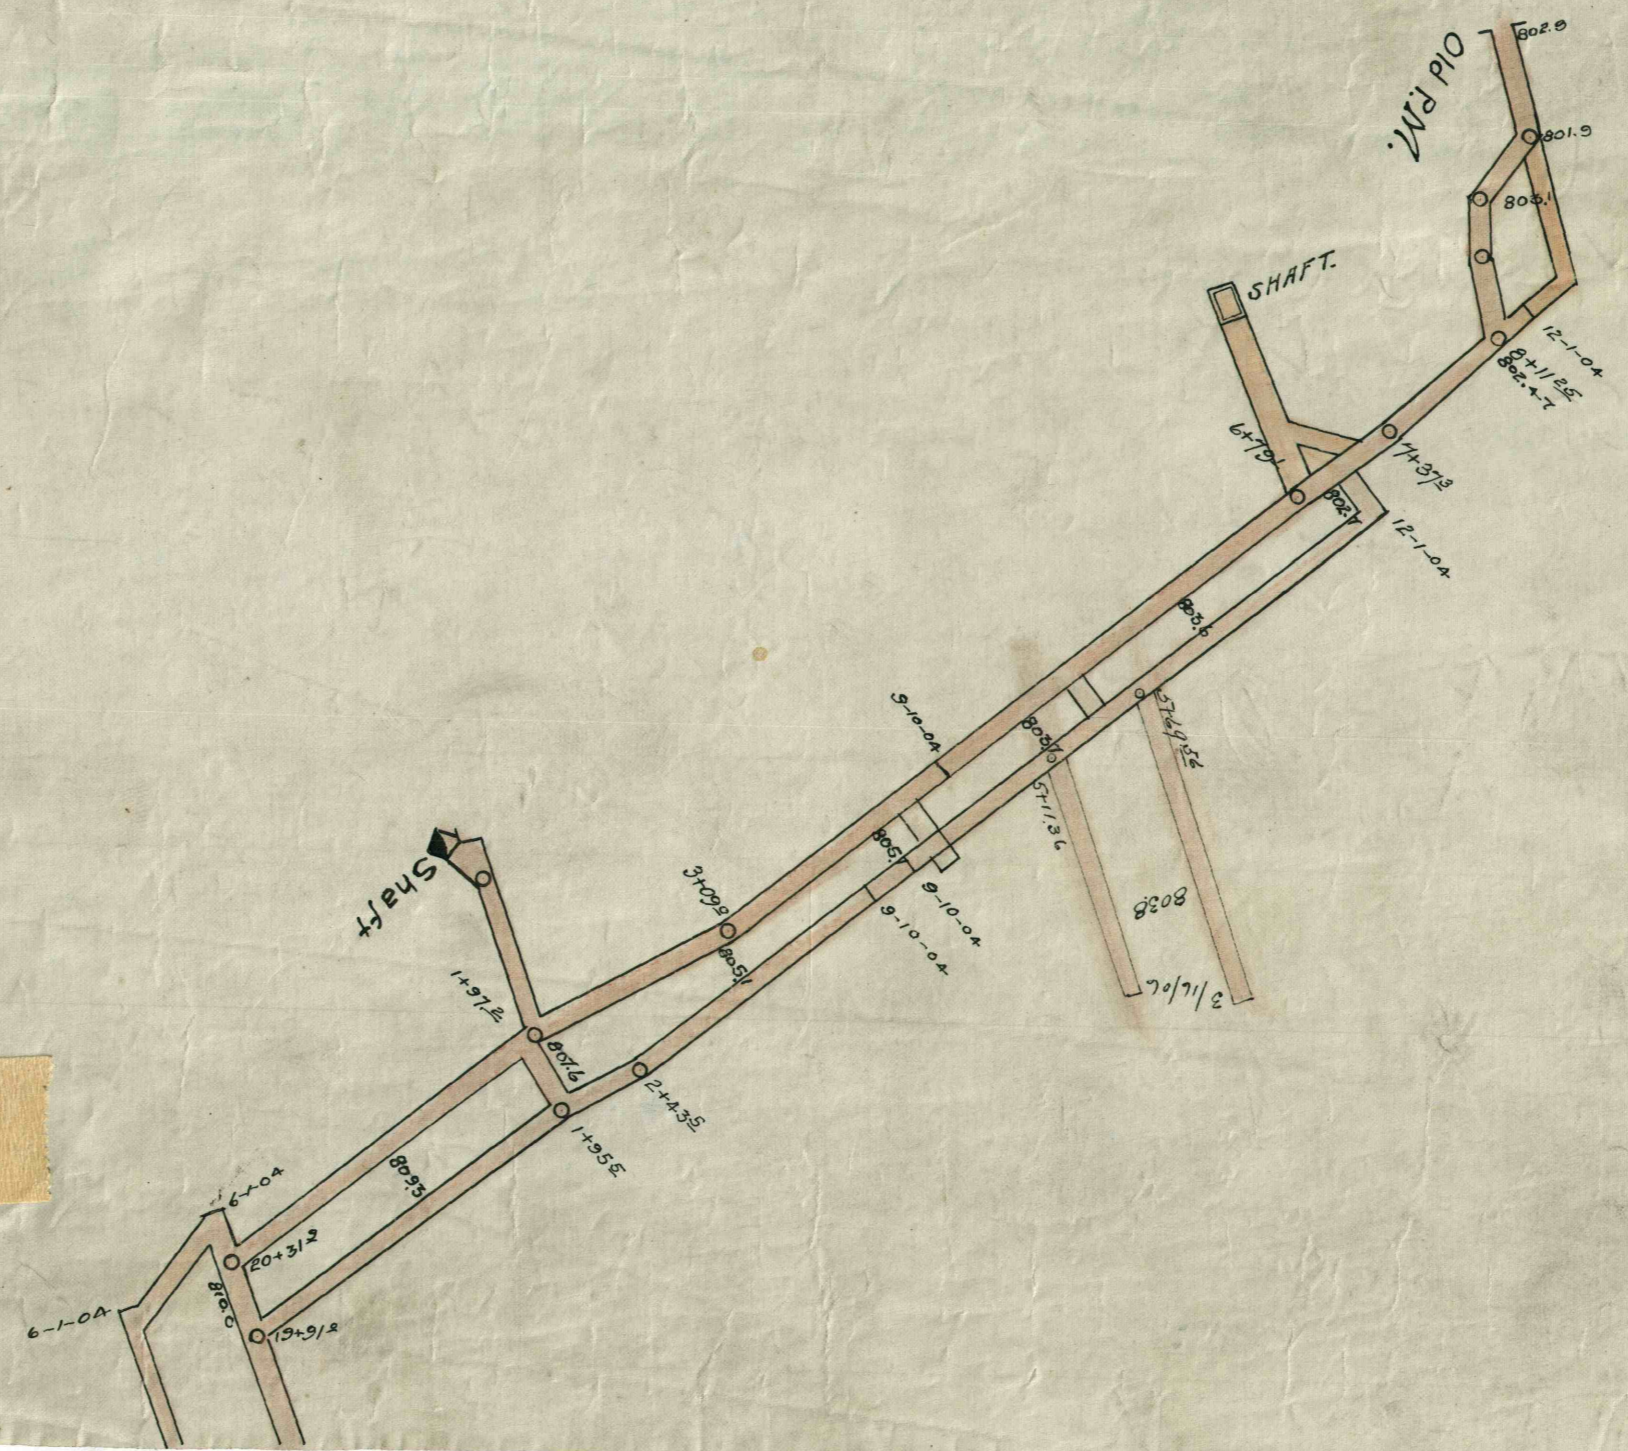

NOTICE
TO SUPERINTENDENTS AND MINE FOREMEN.
No ribs or pillars to be drawn without
written permission from the Engineering
Department. See Gen'l Supts. letter No. 790