


Keep with A35-A-14

NOTICE
TO SUPERINTENDENTS AND MINE FOREMEN.
No ribs or pillars to be drawn without
written permission from the Engineering
Department. See Gen'l Supts. letter No. 790

Addition to Ocean No. 1.

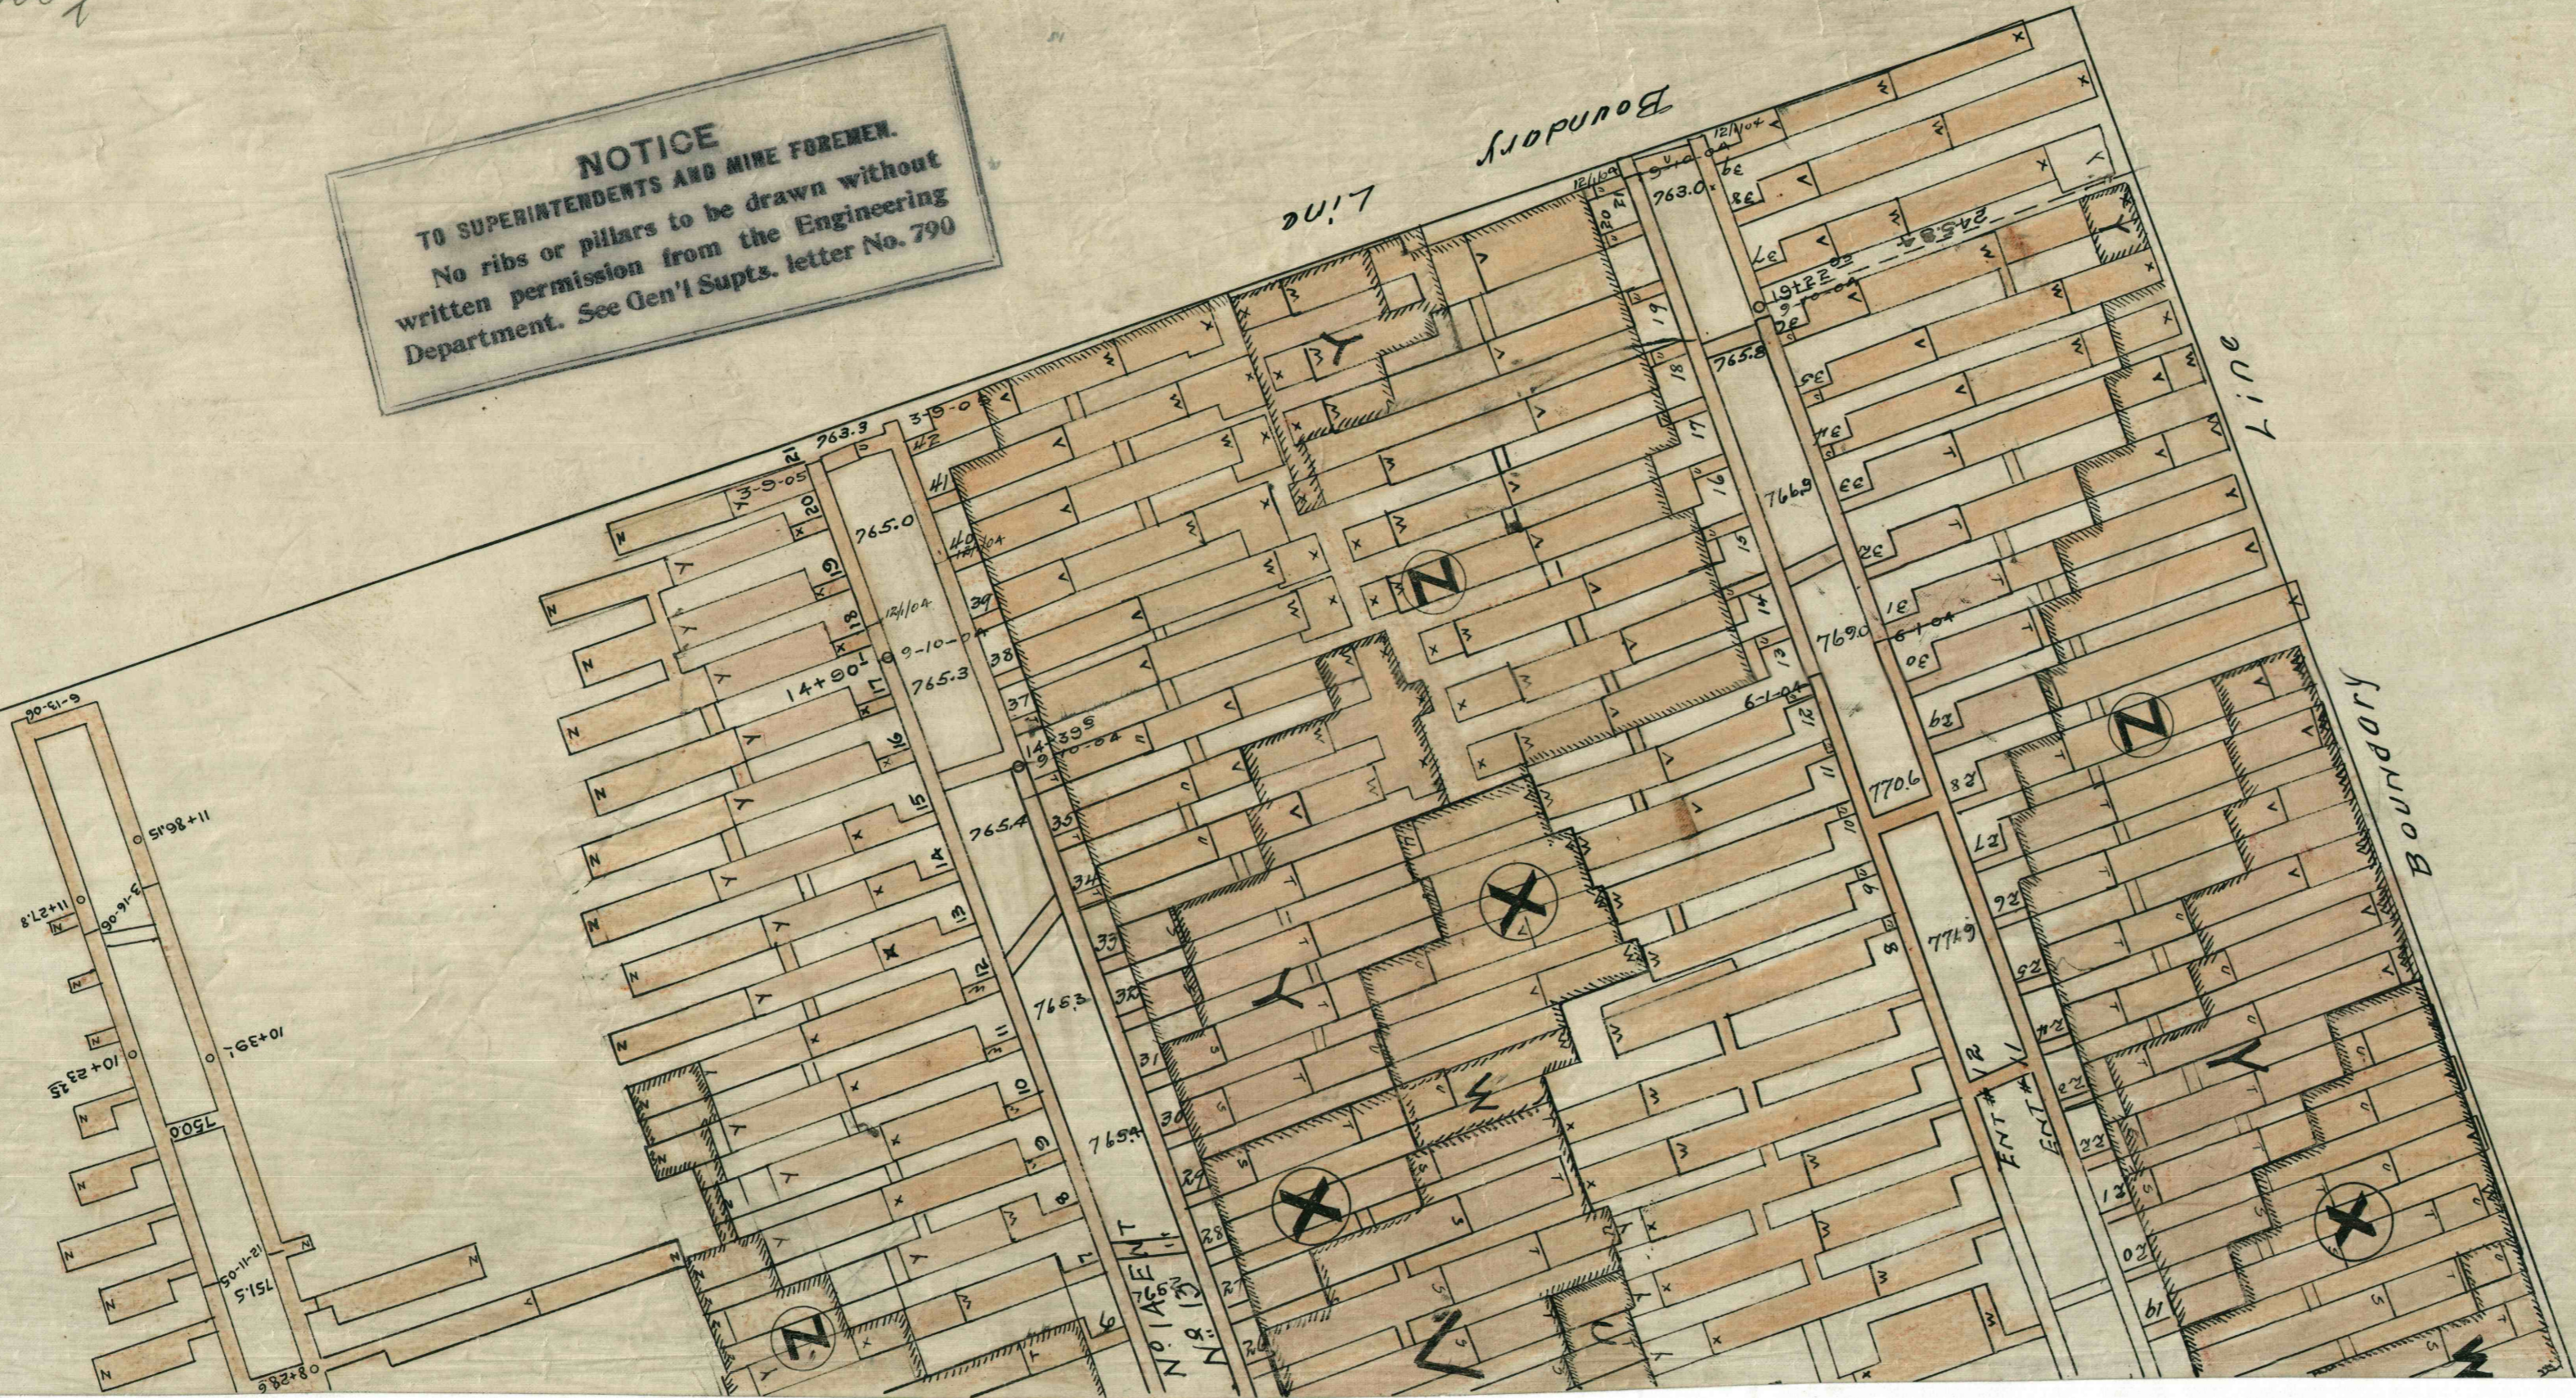

Keep with A35-A-14