


W-41,000

Fit to H5198

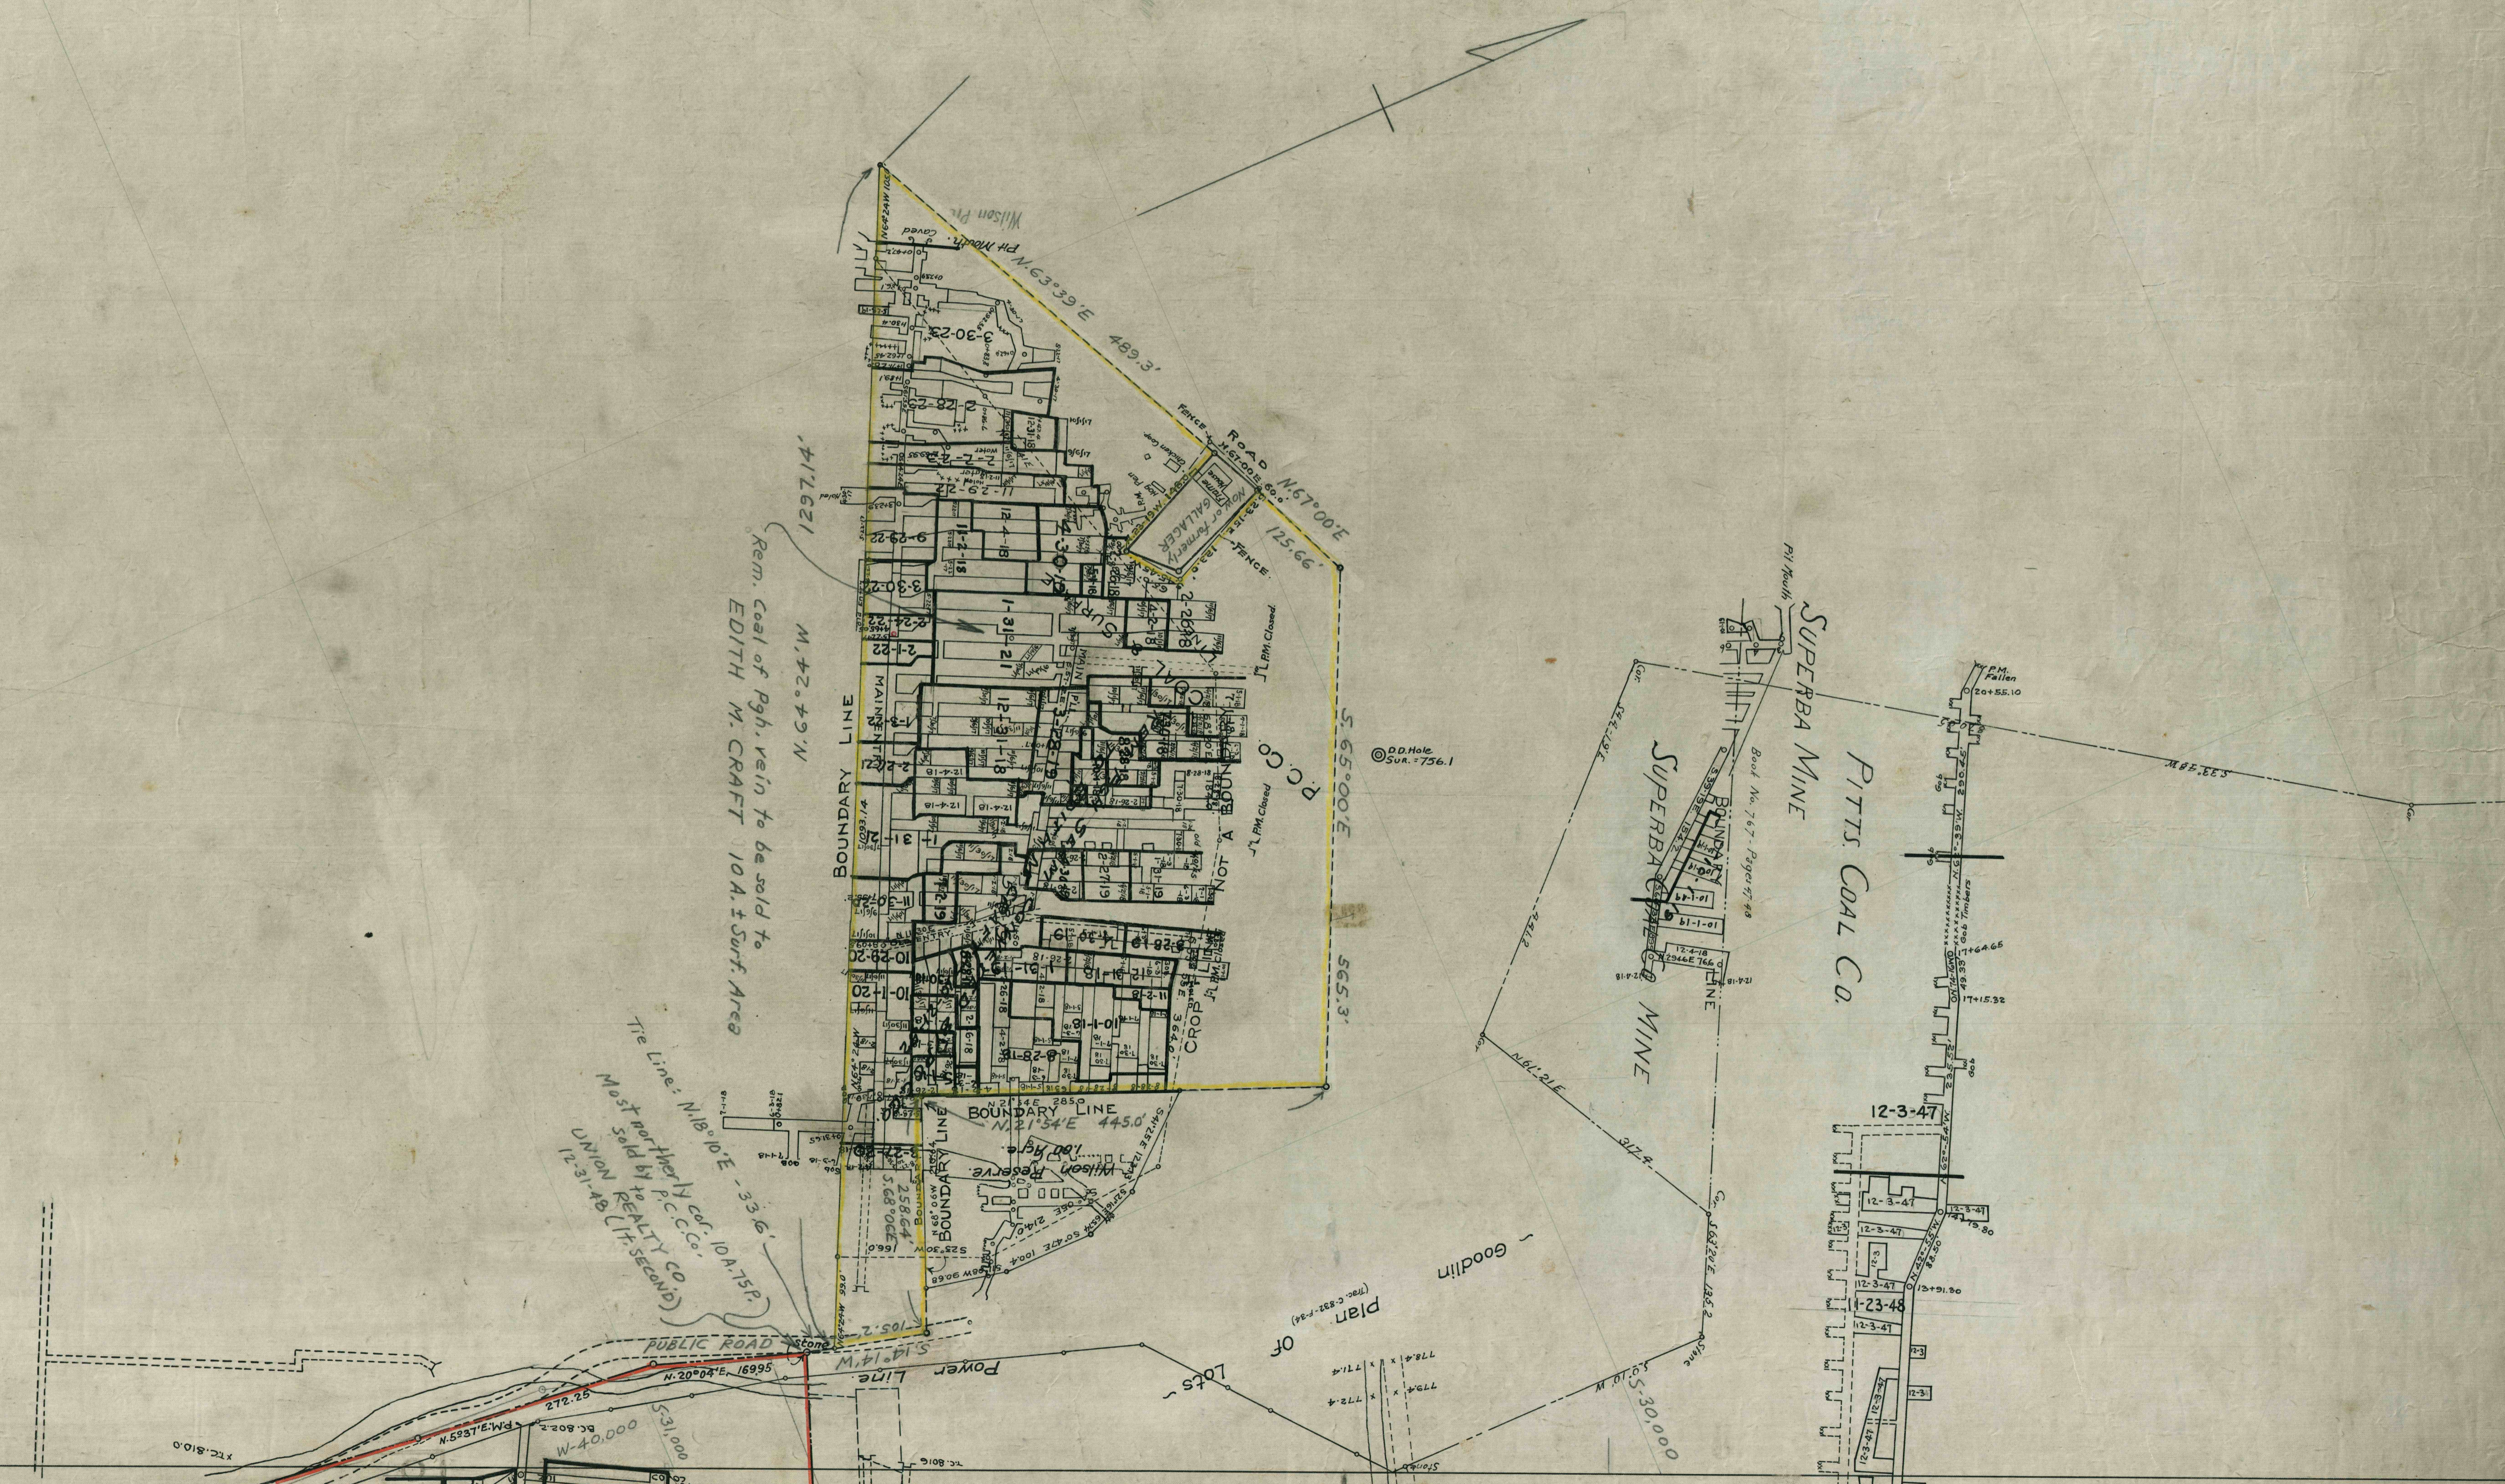

Rem. Coal of Pgh. vein to be sold to  
EDITH M. CRAFT 10A. Surf. Area

The Line: N 10° E - 35.6'  
Most part then by P.C.C. Co. (10A.15P)  
UNION REALTY CO. (15-second)  
12-31-48