


FIT TO A801 F-18 Sheet #2

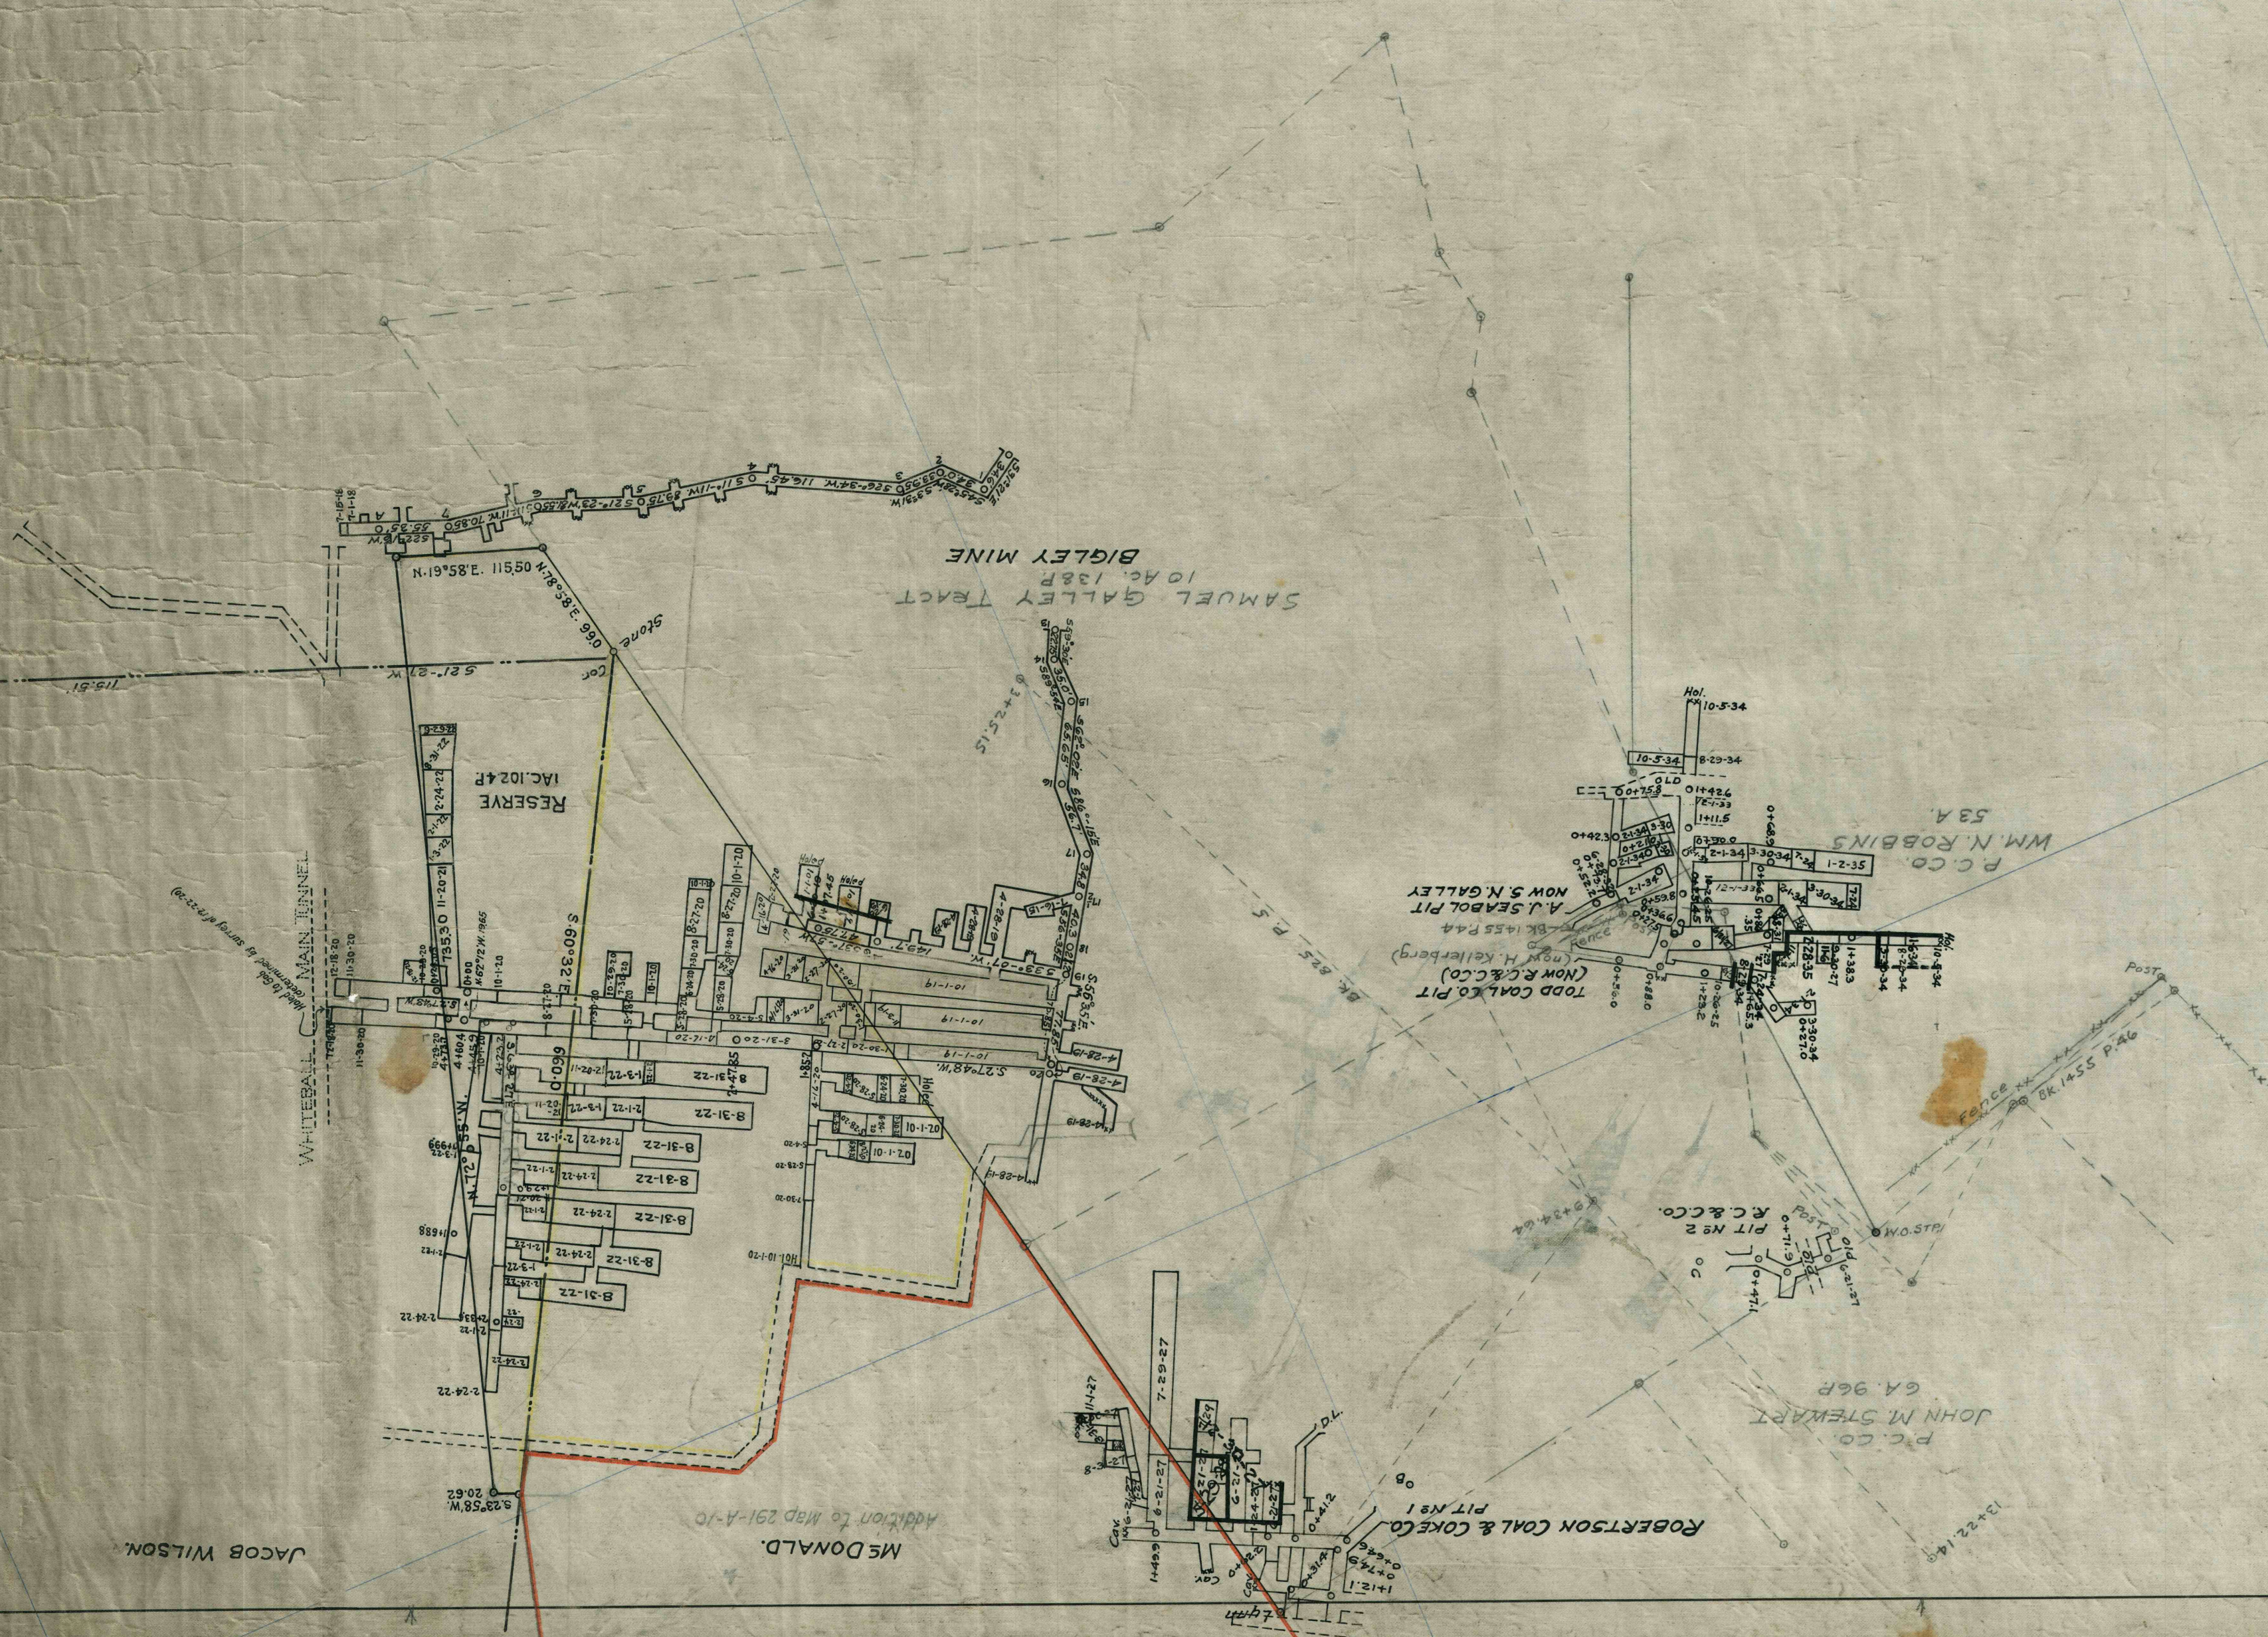

JACOB WILSON.

MS DONALD.
Addition to Map 291-A-10

FIT TO H 5014