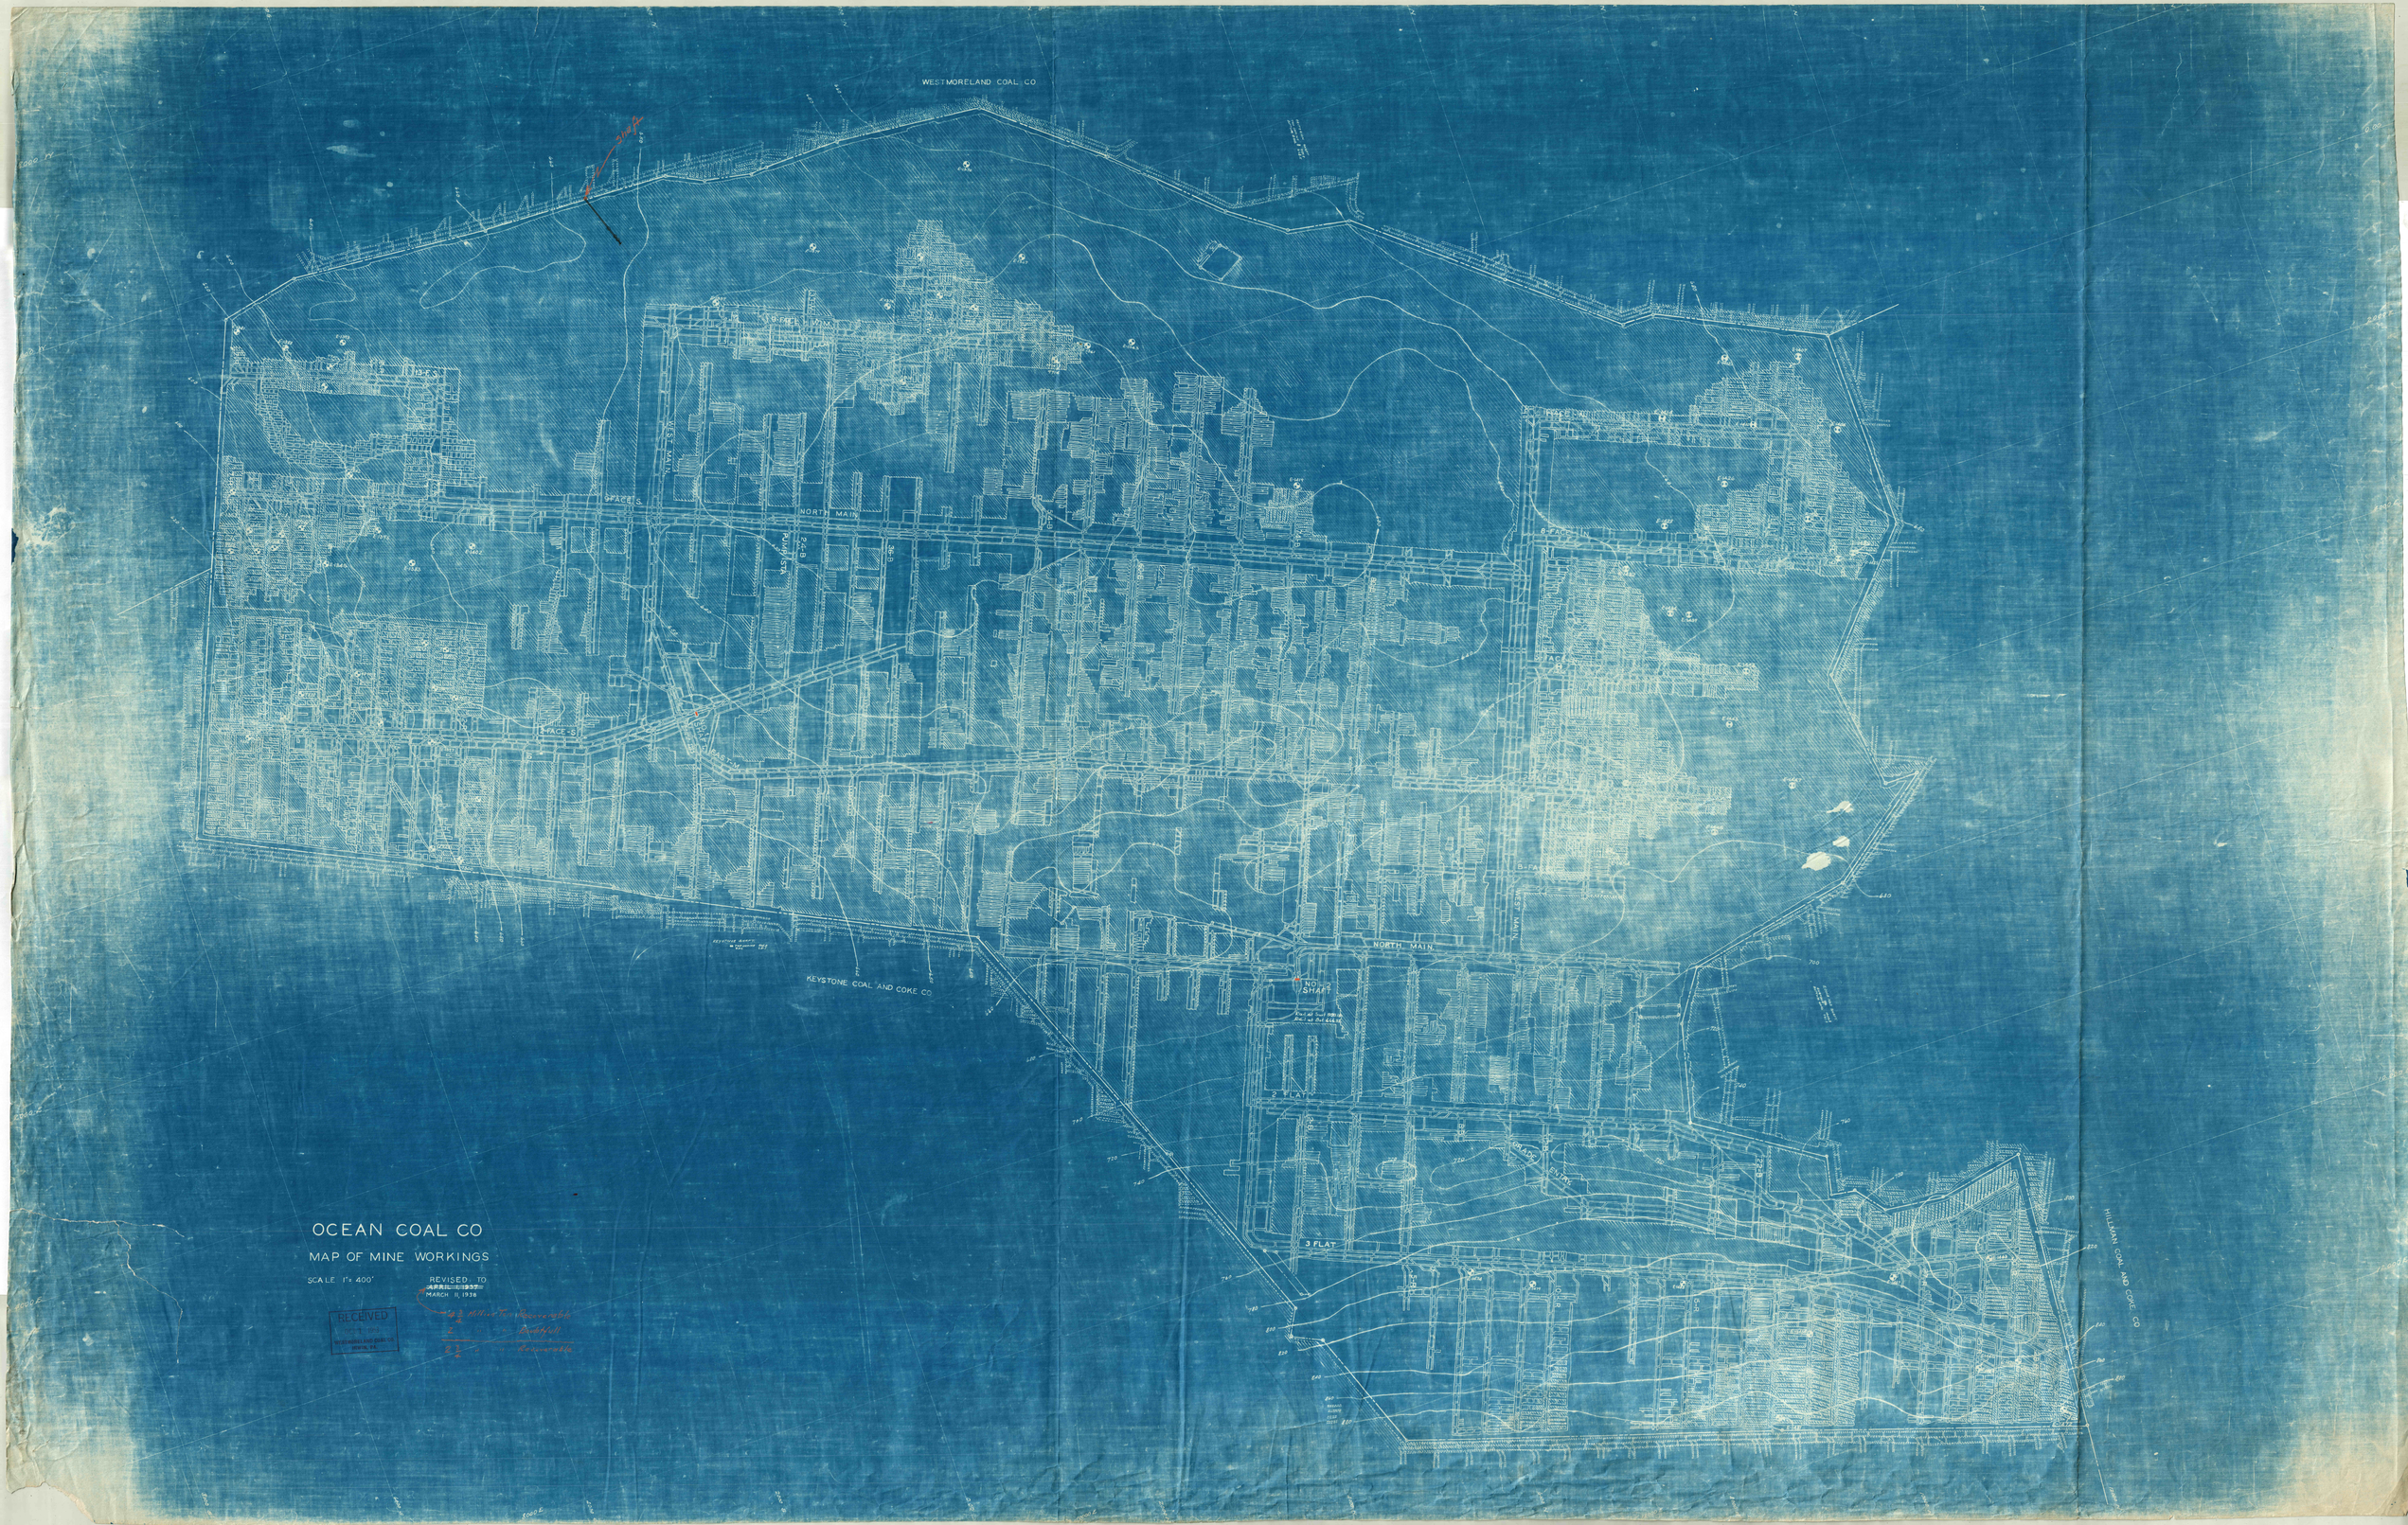
WESTMORELAND COAL CO
KEYSTONE COAL AND COKE CO
HILLMAN COAL AND COKE CO
NORTH MAIN
WEST MAIN
6 FACE S.
5 FACE S.
4 FACE S.
2 FACE S.
1 FACE S.
2 FLAT
3 FLAT
4 FLAT
NO. 1 SHAFT
Elev. at Top 1088.0
Elev. at Bottom 1000.0
BLACK CREEK
Ground Surface Elevations Taken Sept. 1937
OCEAN COAL CO
MAP OF MINE WORKINGS
SCALE 1" = 400'
REVISED TO
MARCH 11, 1938
RECEIVED
WESTMORELAND COAL CO
PITTSBURGH, PA.
43 Miles Recoverable
Bedrock
23 Recoverable