


FT 10 H5202

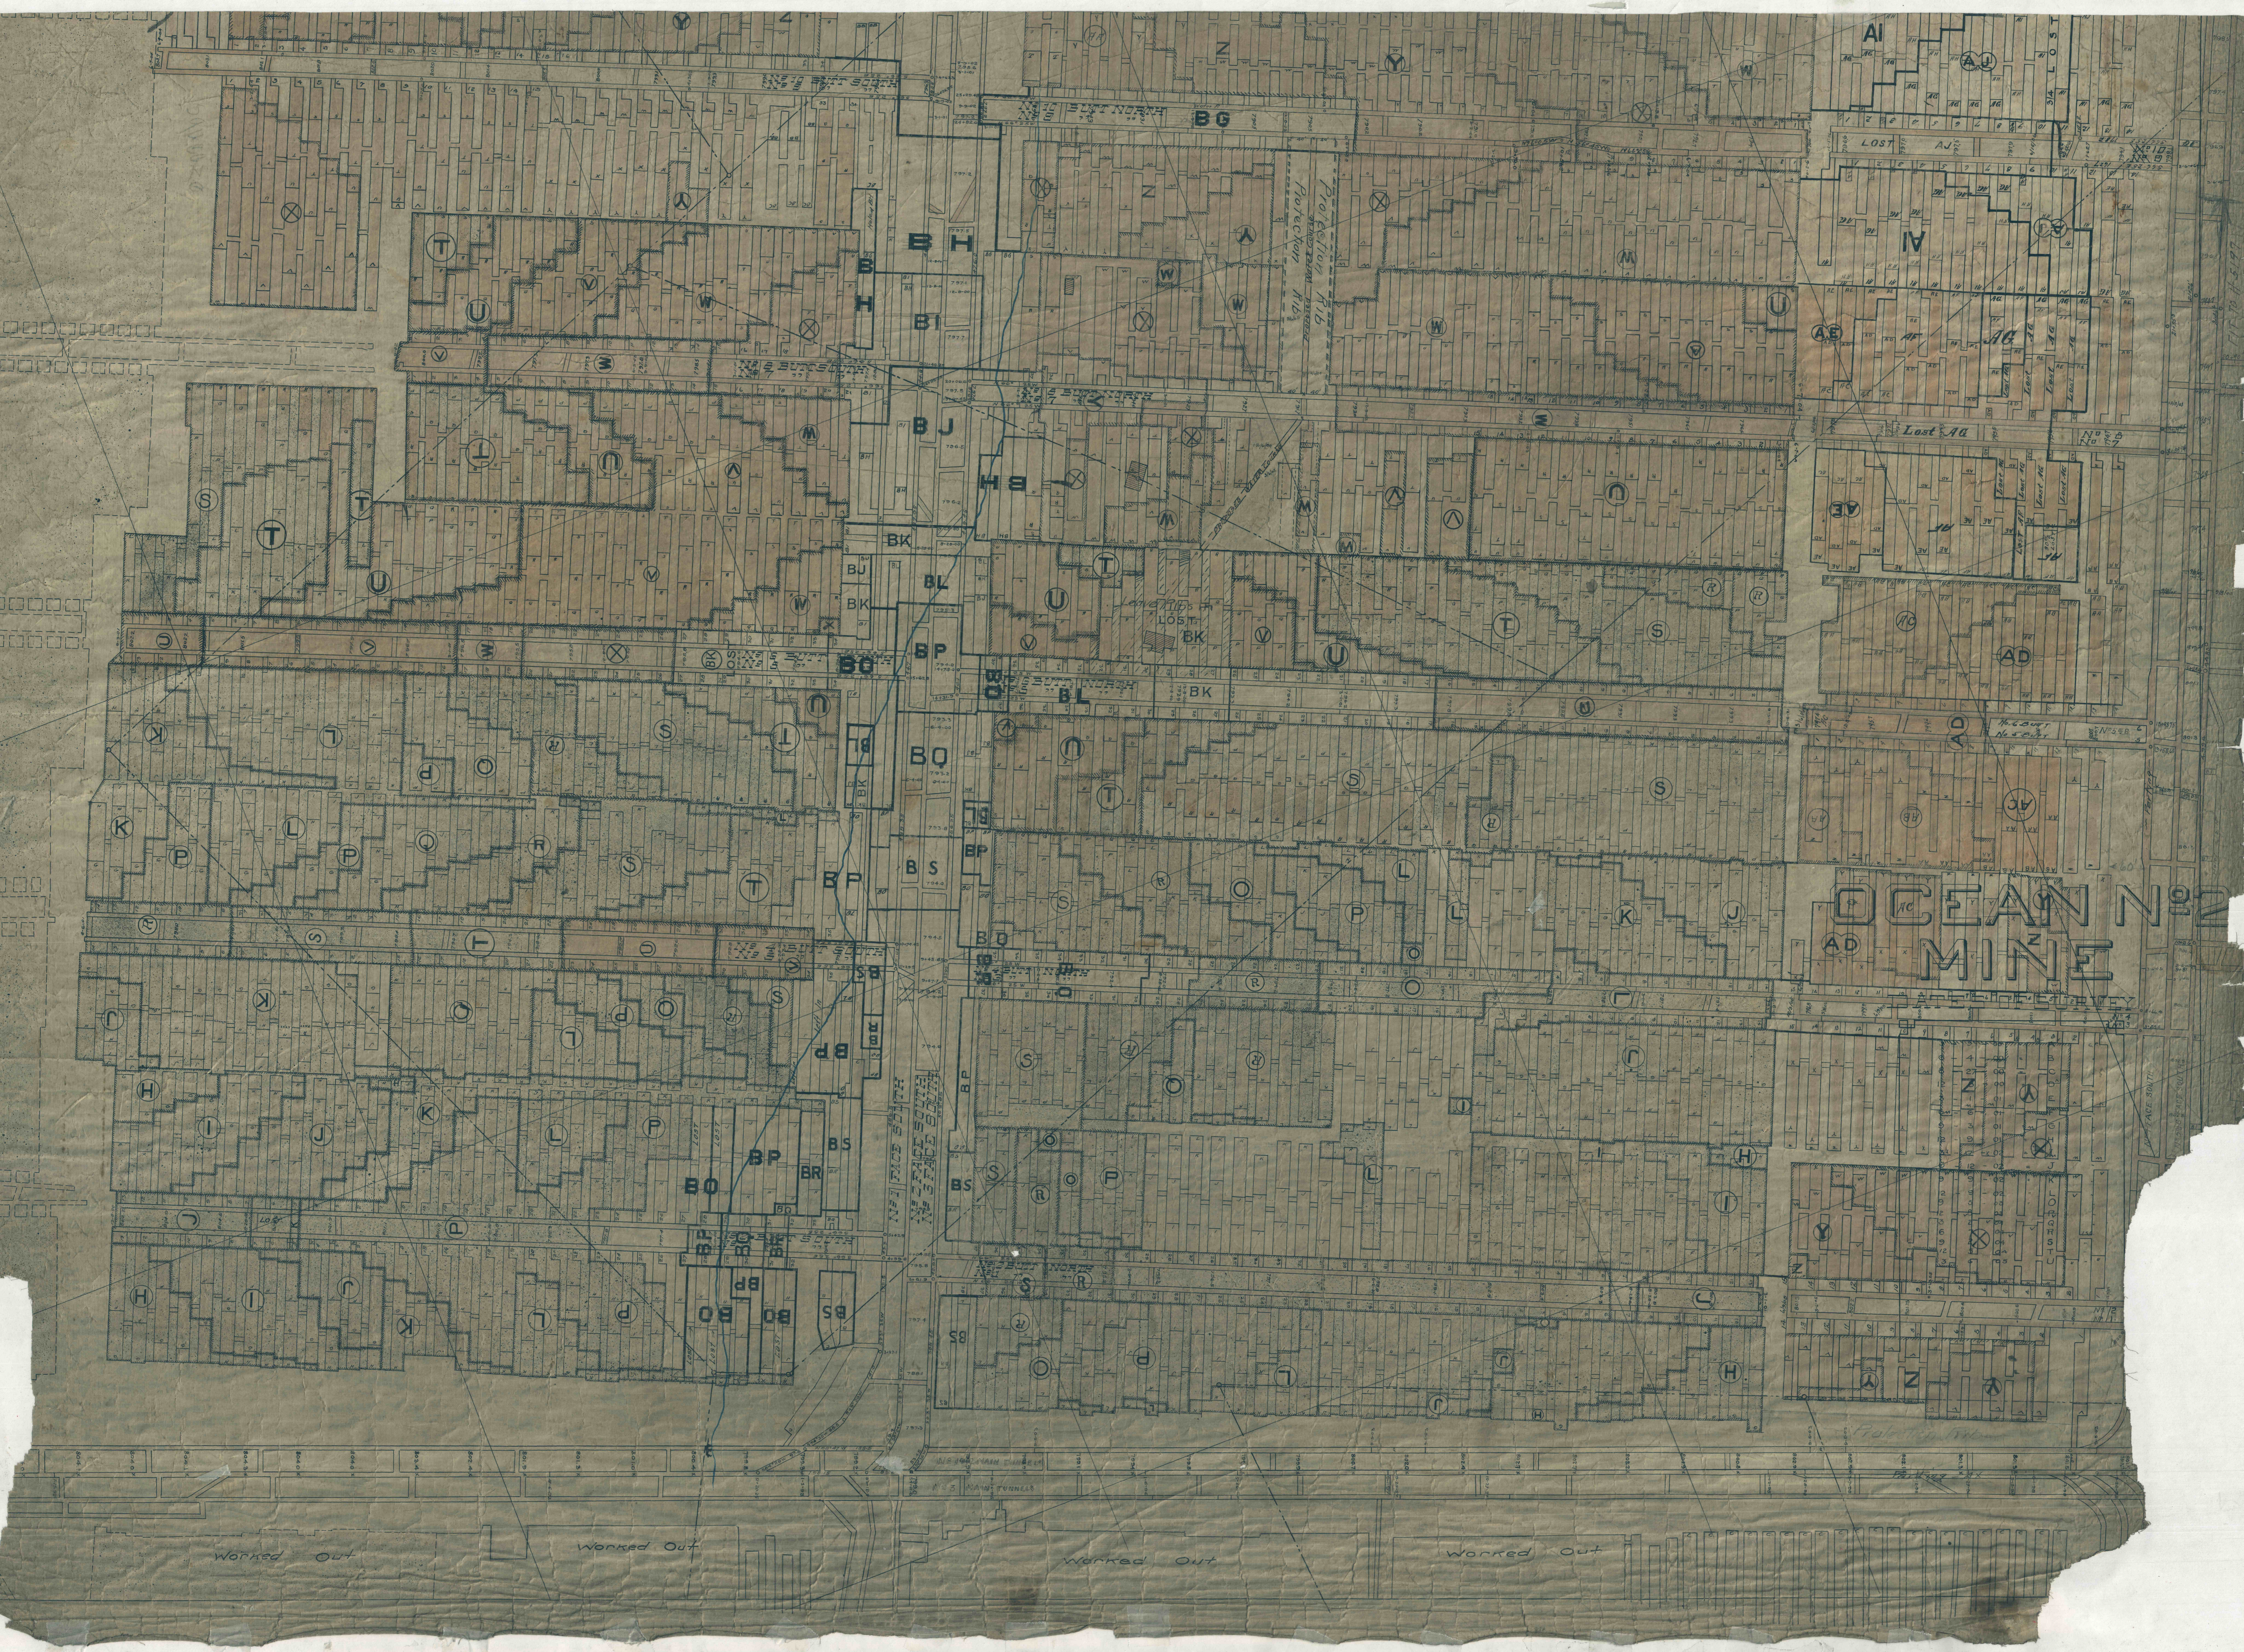

# OCEAN No 2 MINE

Protection H/B  
Protection H/B

Worked Out

Worked Out

Worked Out

Worked Out