


WESTMORELAND COAL COMPANY.

PLAN
of
PENN MINE.

Scale 1"=600'

March 1913.

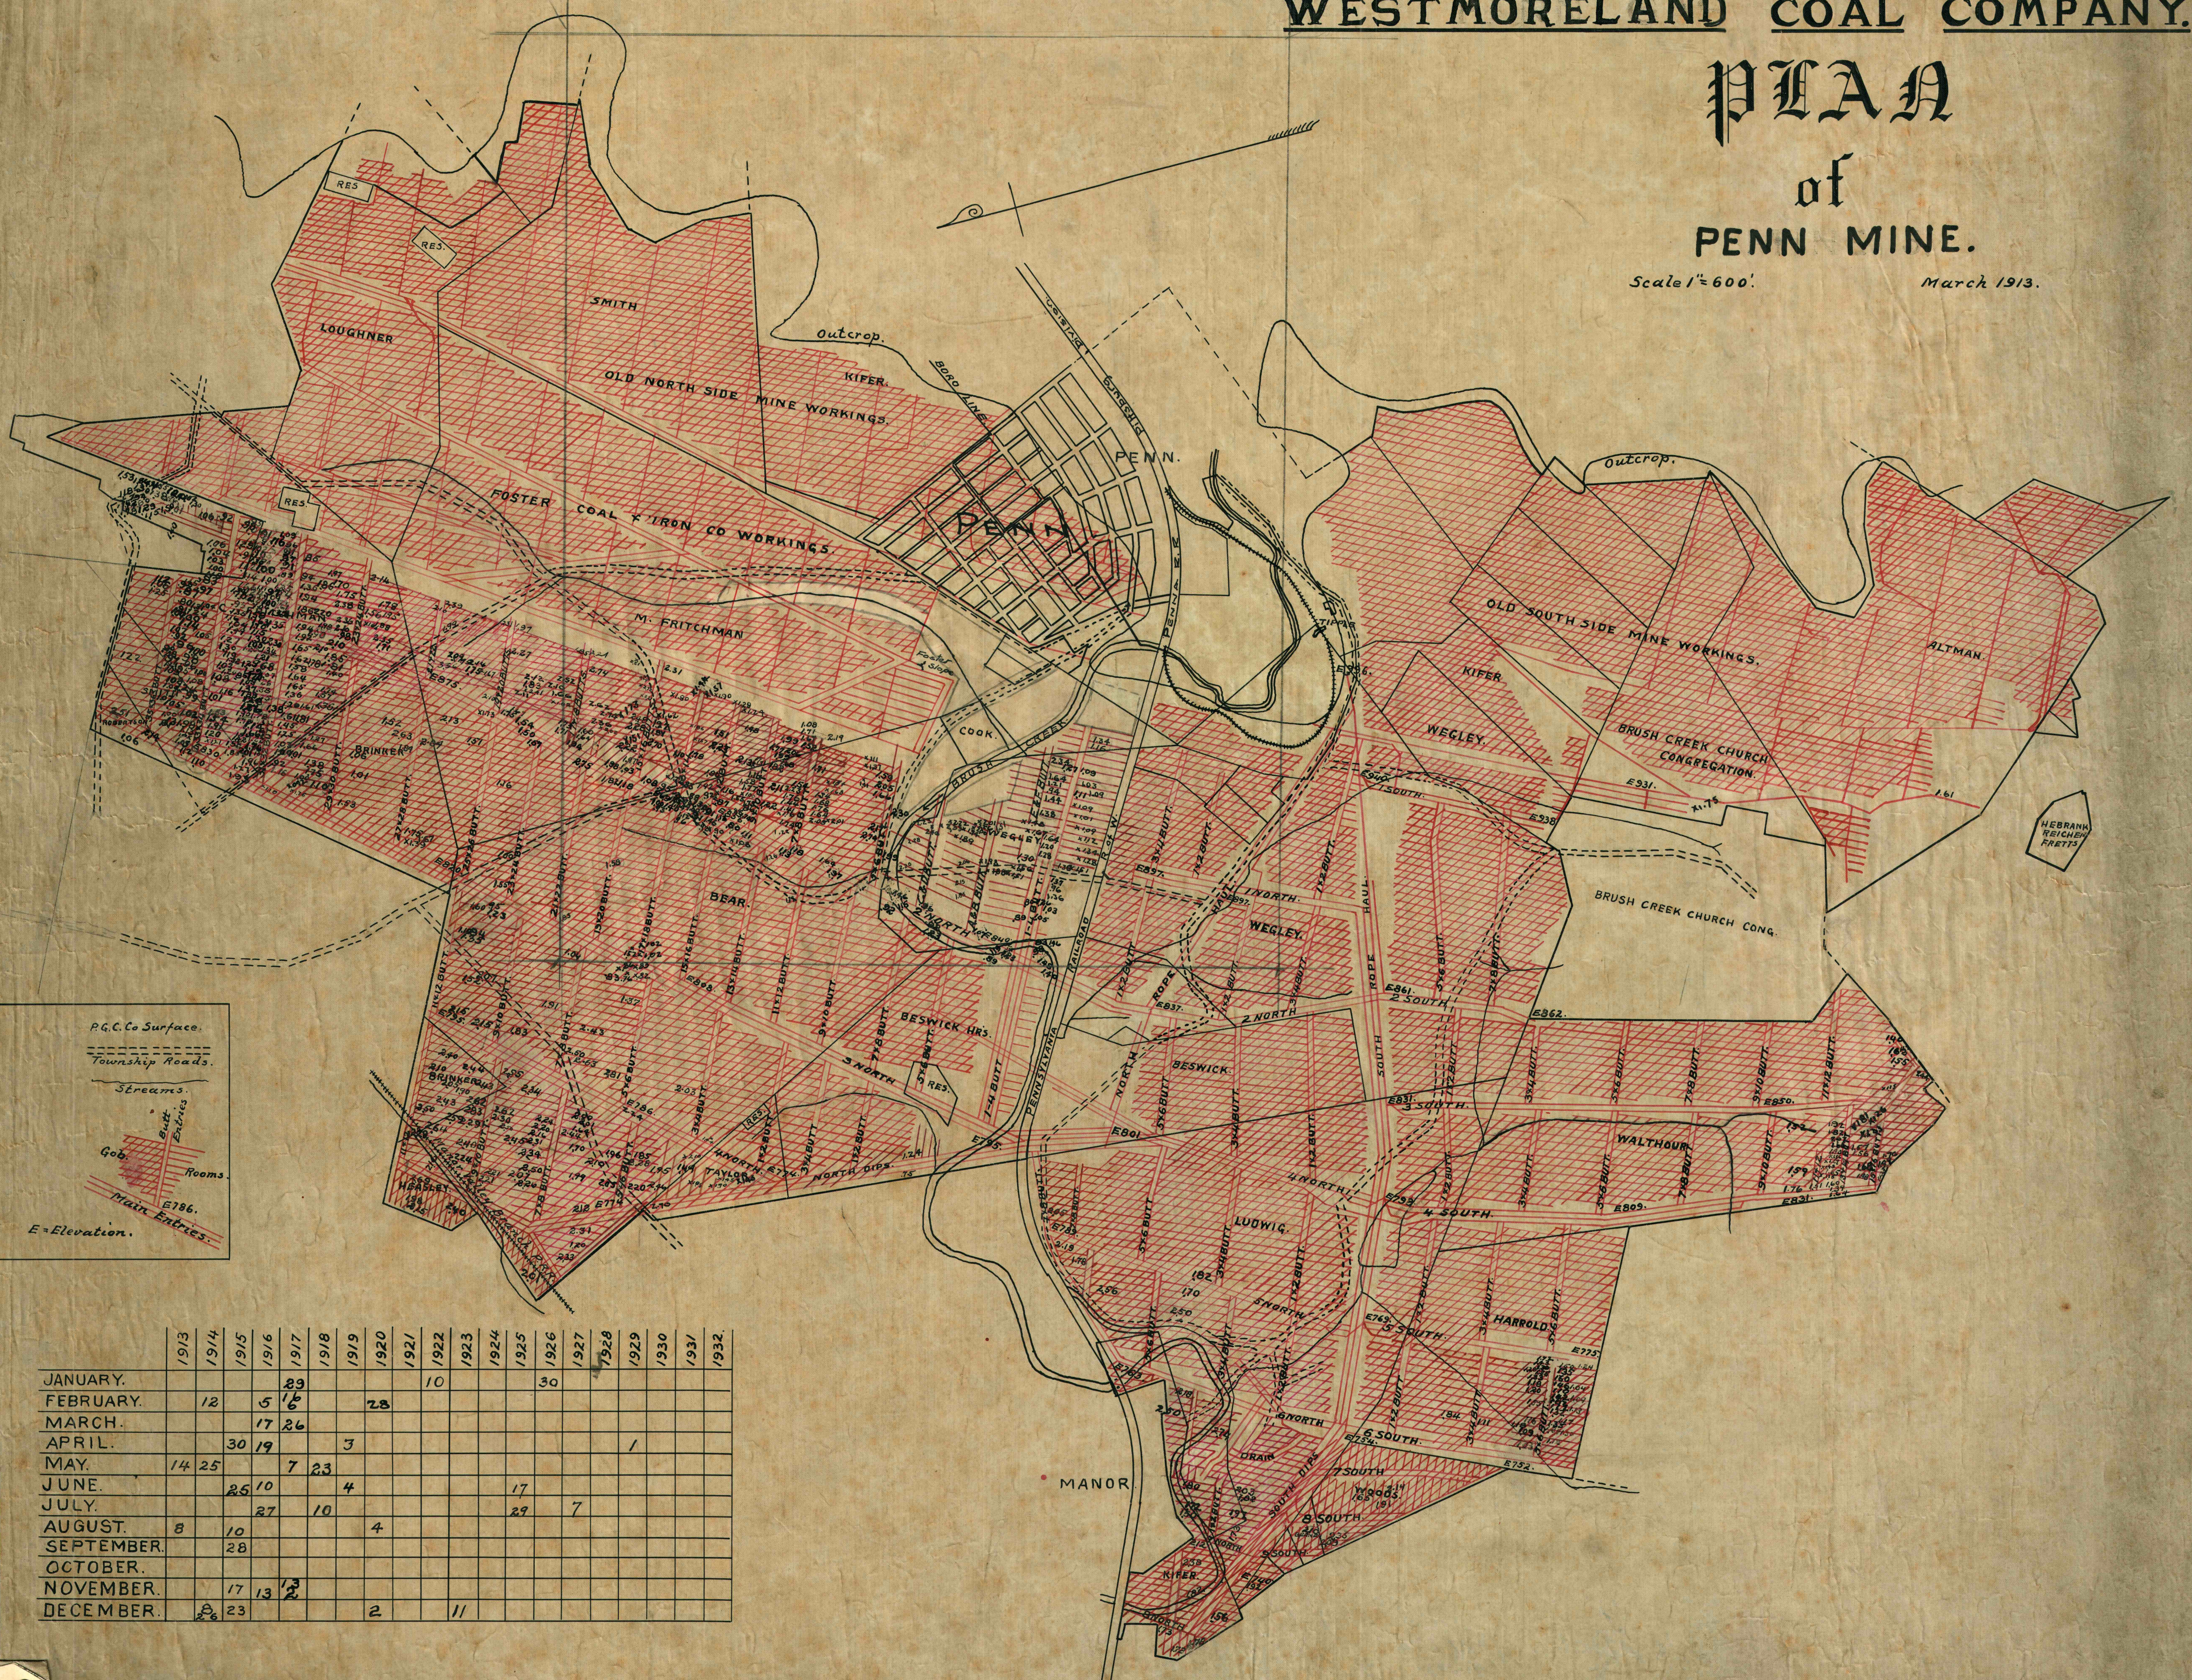

P.G.C. Co Surface.

Township Roads.

Streams.

Butt Entries.

Gov. Rooms.

Main Entries.

E=Elevation.

	1913	1914	1915	1916	1917	1918	1919	1920	1921	1922	1923	1924	1925	1926	1927	1928	1929	1930	1931	1932
JANUARY.					23					10				30						
FEBRUARY.		12		5	6			28												
MARCH.				17	26															
APRIL.			30	19		3												1		
MAY.		14	25		7	23														
JUNE.			25	10		4							17							
JULY.														7						
AUGUST.	8		10		27	10		4					29		7					
SEPTEMBER.				28																
OCTOBER.																				
NOVEMBER.			17	13	2															
DECEMBER.	8	23					2	11												