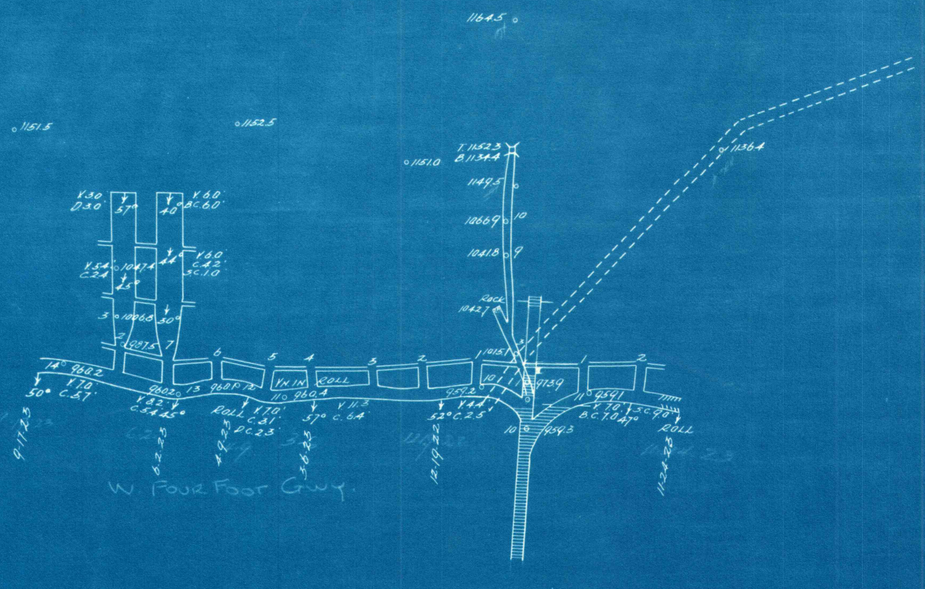
1164.5
1151.5
1152.5
1151.0
T. 1152.3
B. 1134.4
1149.5
10869
10818
ROCK
10427
1015.1
1136.4
1147.8
1148.7
W. FOUR FOOT GUY.