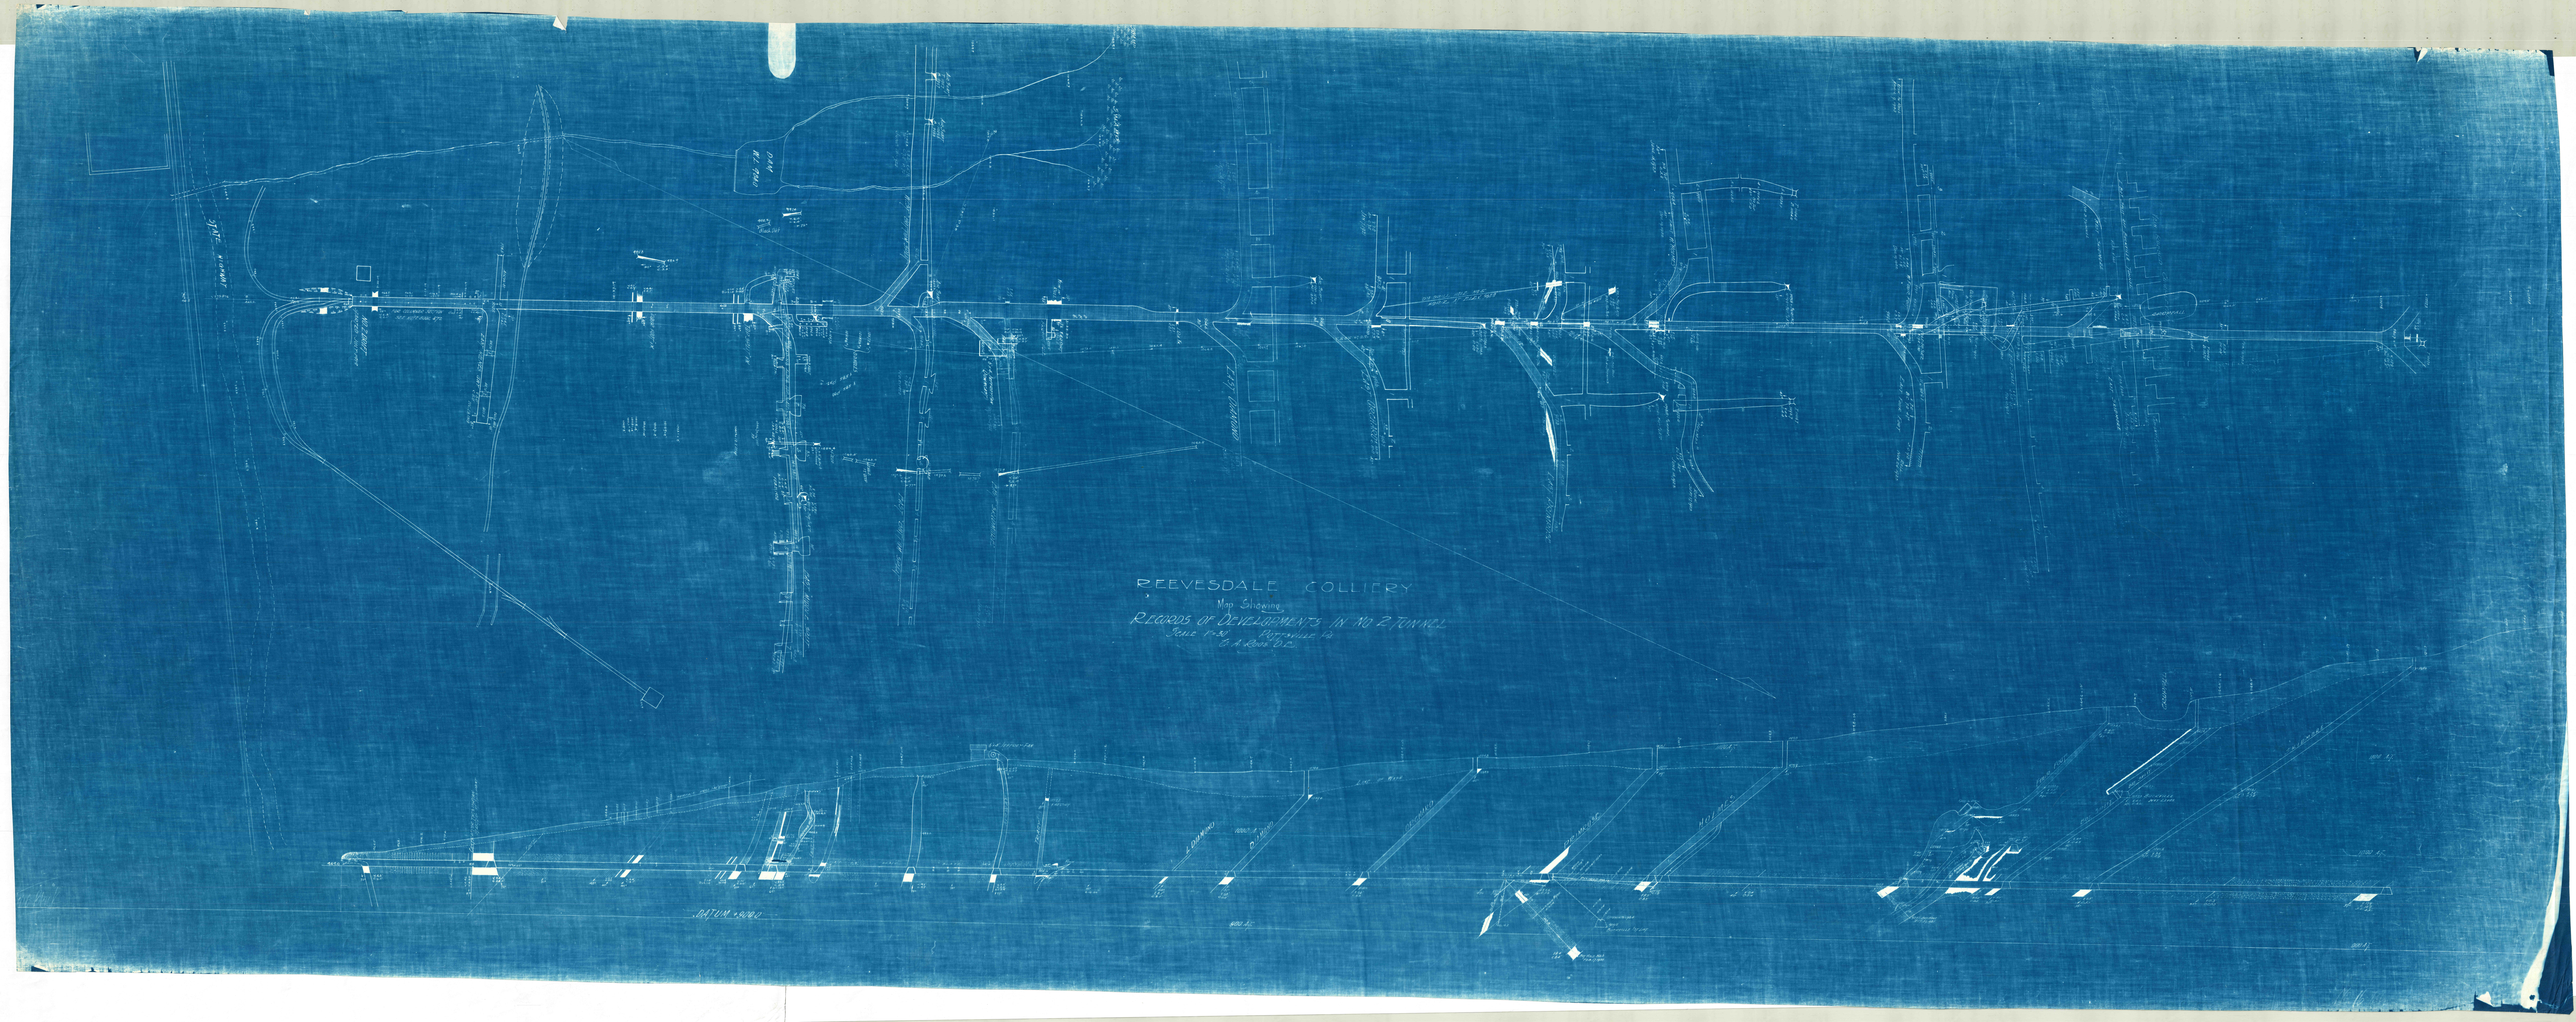
REEVESDALE COLLIERY
Map Showing
RECORDS OF DEVELOPMENTS IN NO 2 TUNNEL
Scale 1:20
Pottsville Pa
E.A. Ross D.E.
DATUM 1000