


CA

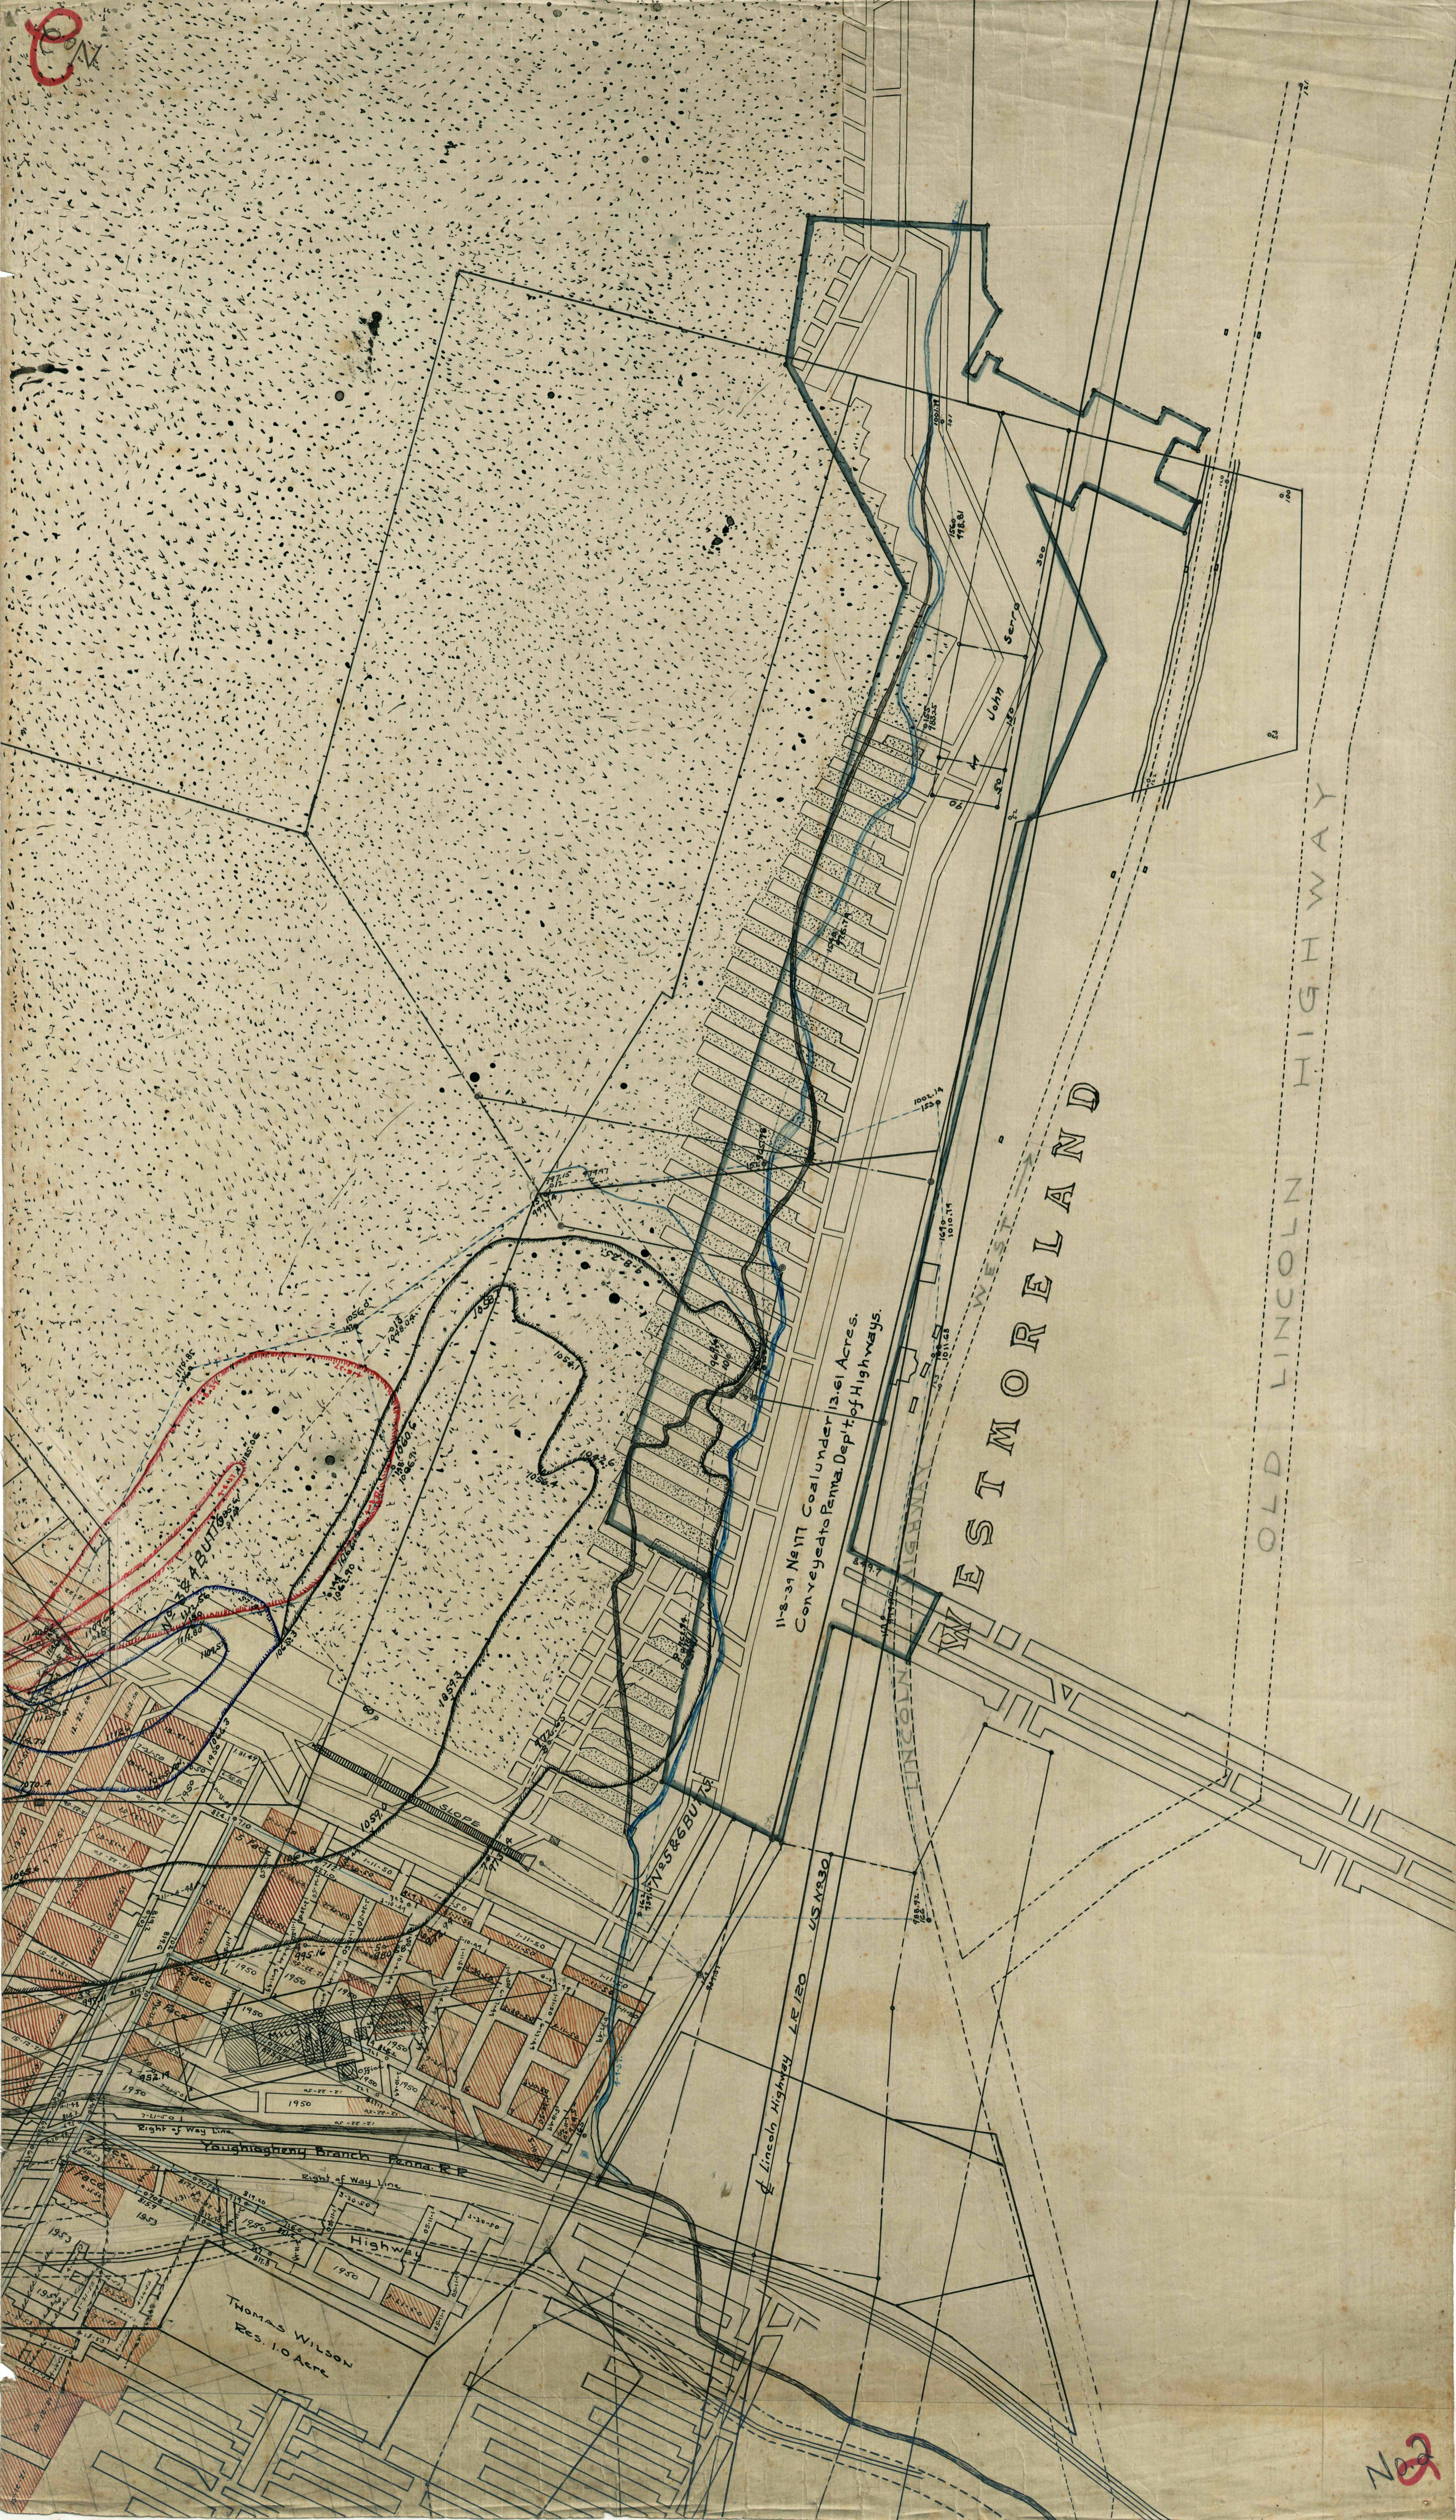

11-3-39 Nelt Coal under 13.61 Acres.  
 Conveyed to Penna. Dept. of Highways.

WESTMORELAND

OLD LINCOLN HIGHWAY

Thomas Wilson  
 Res. 1.0 Acre

102