


9

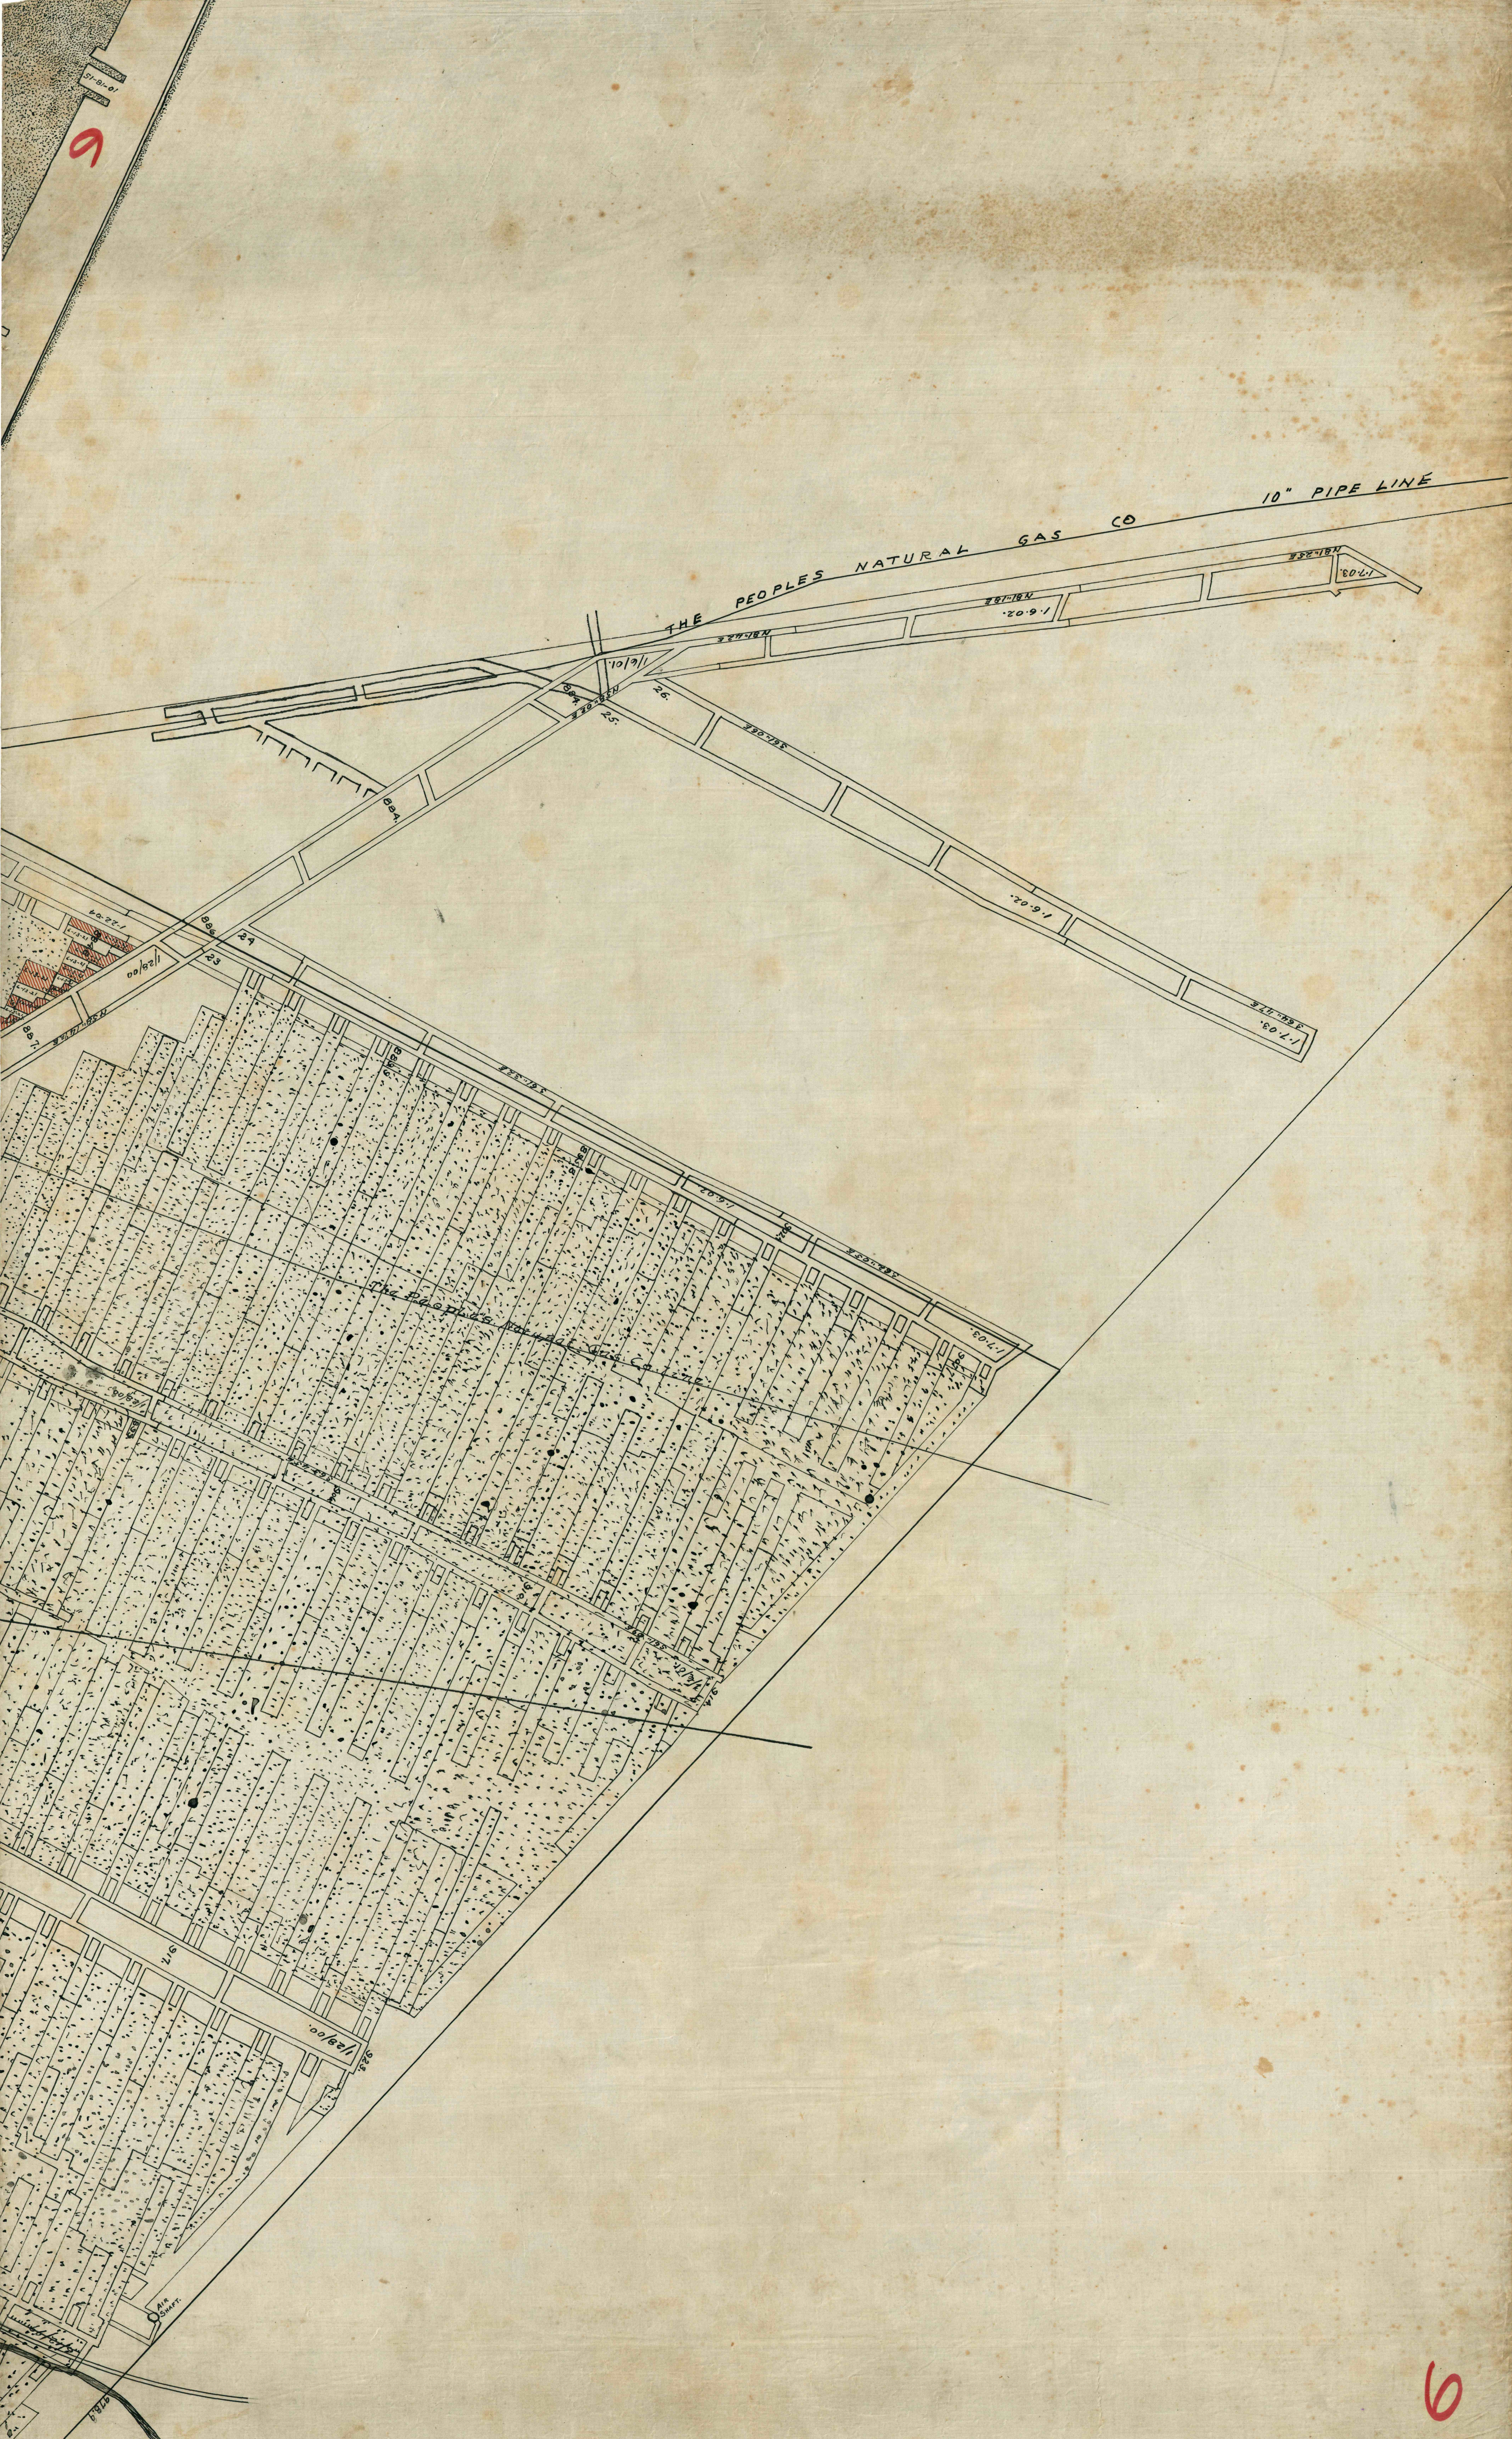

6