


90N

GAS

90N

COAL

COMPANY

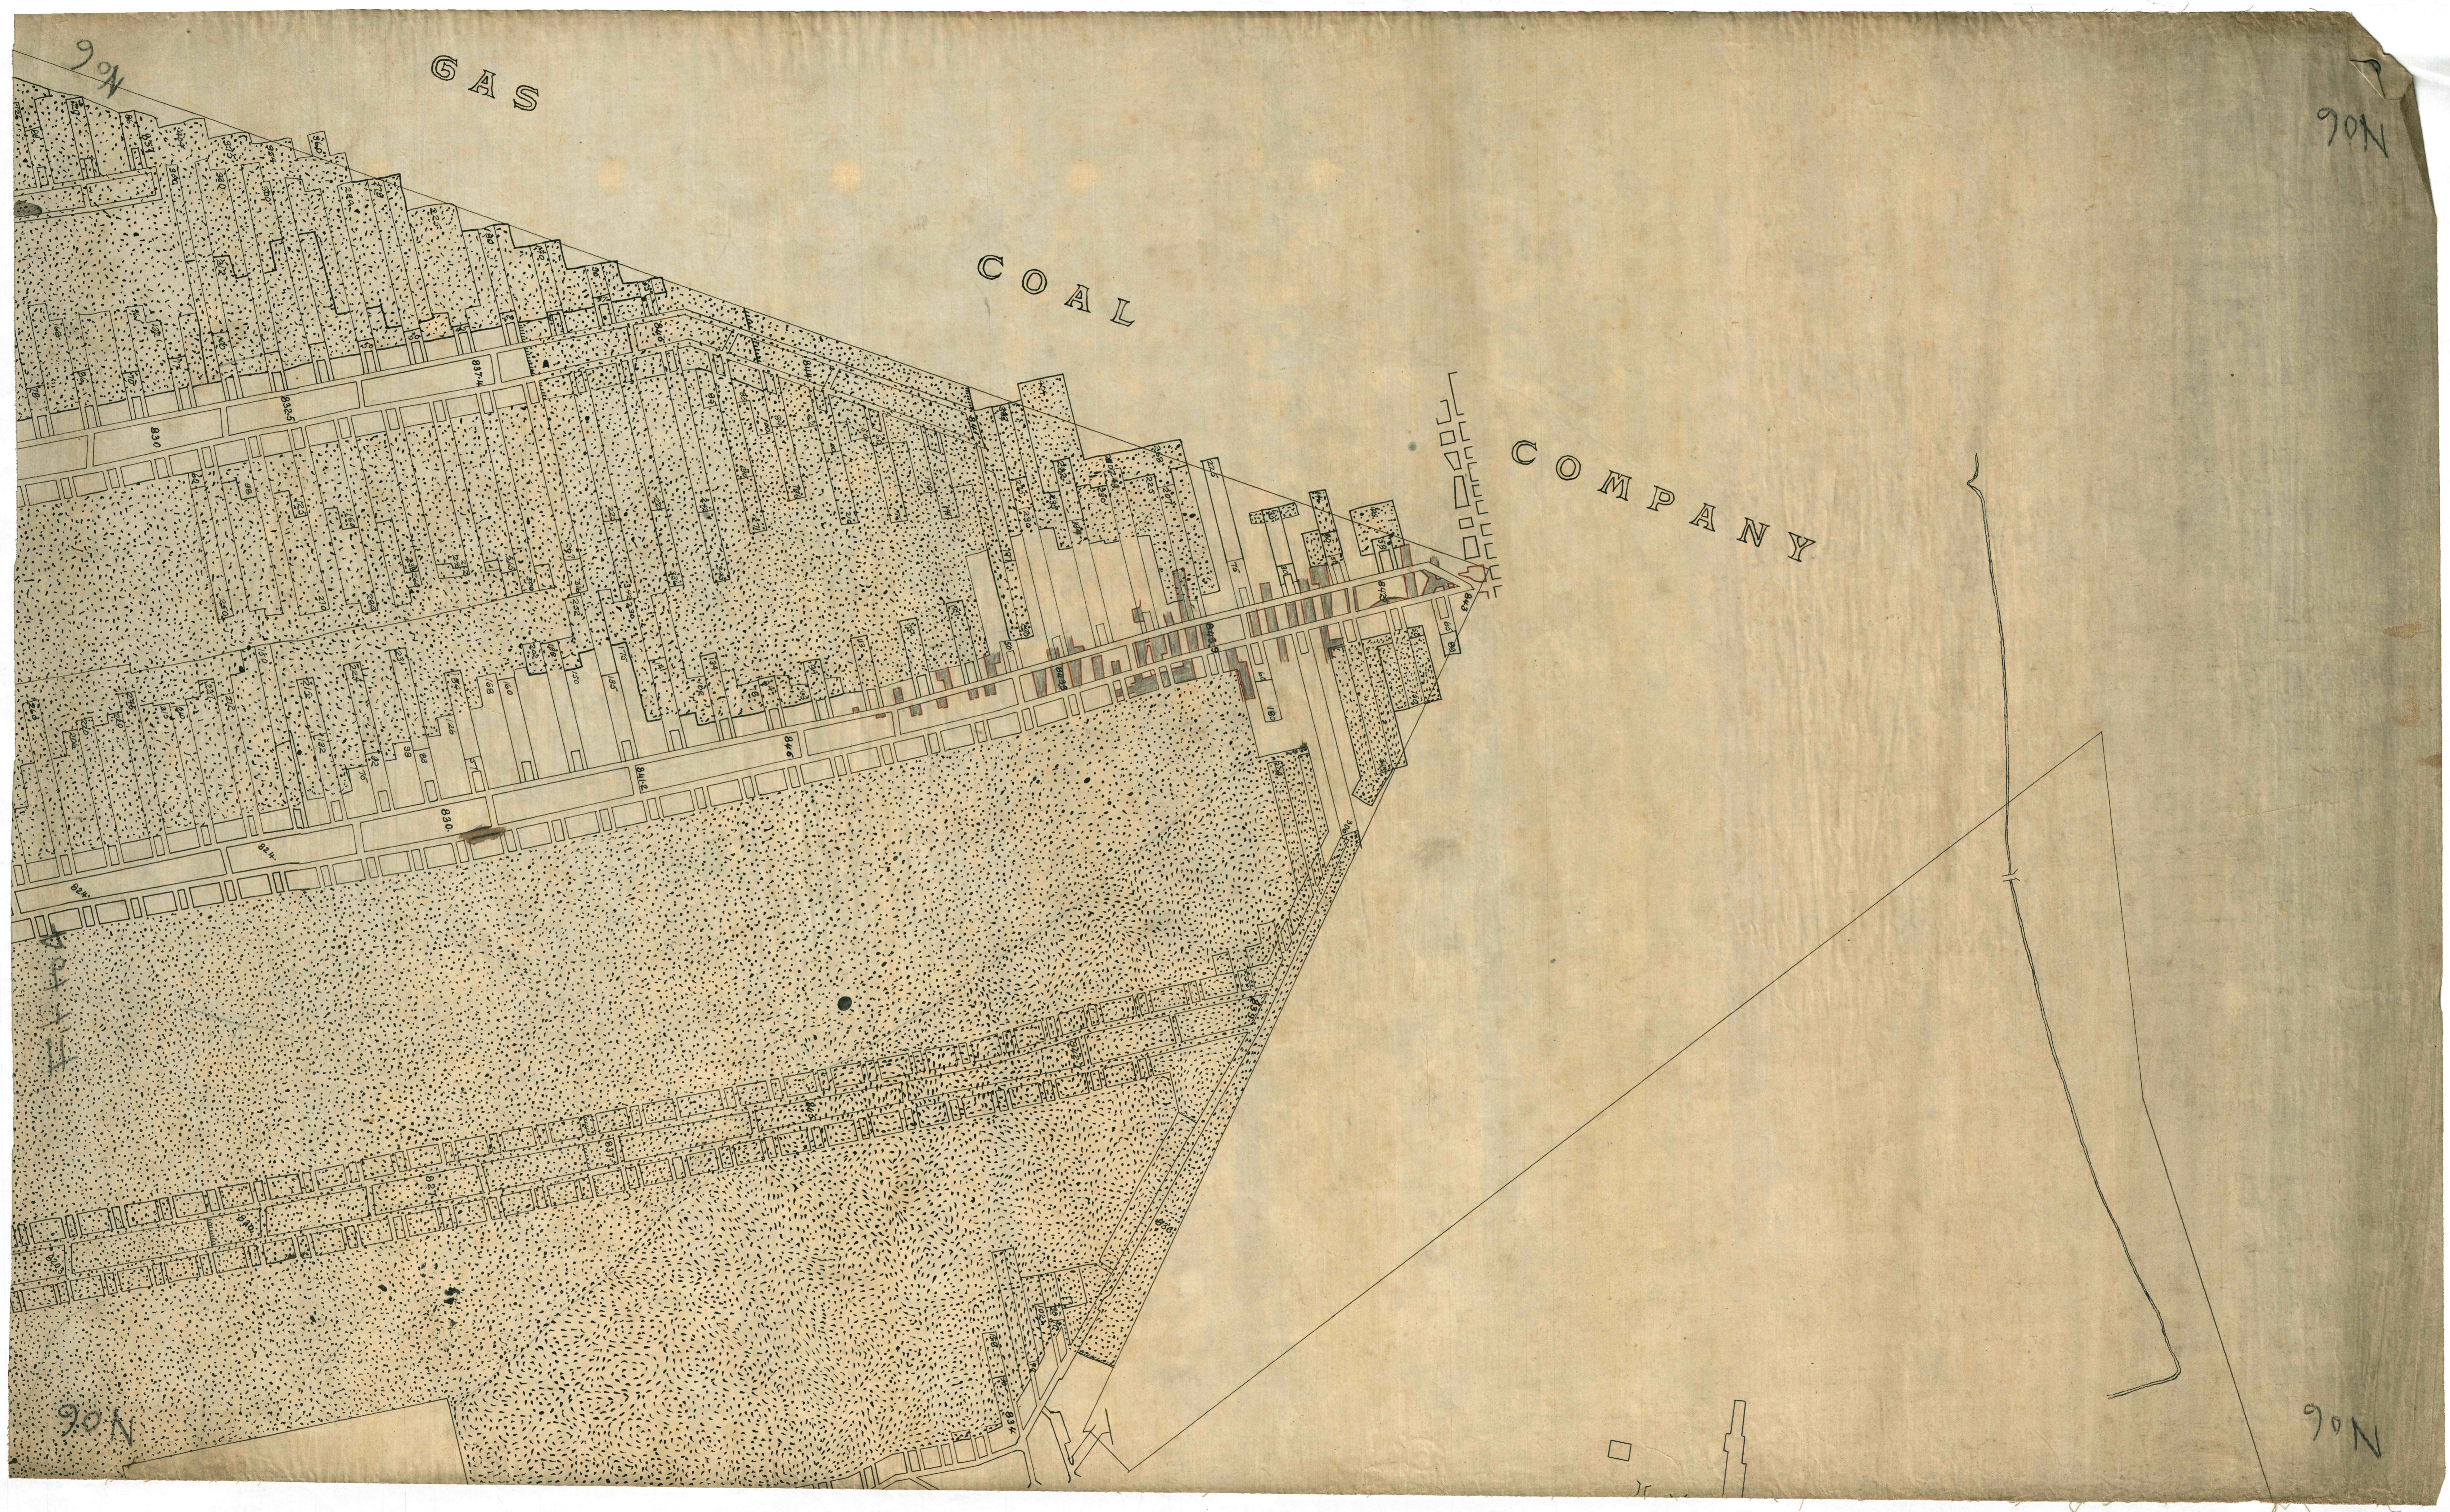

90N

90N

90N