


FIT TO SHEET No. 14

FIT TO SHEET No. 8

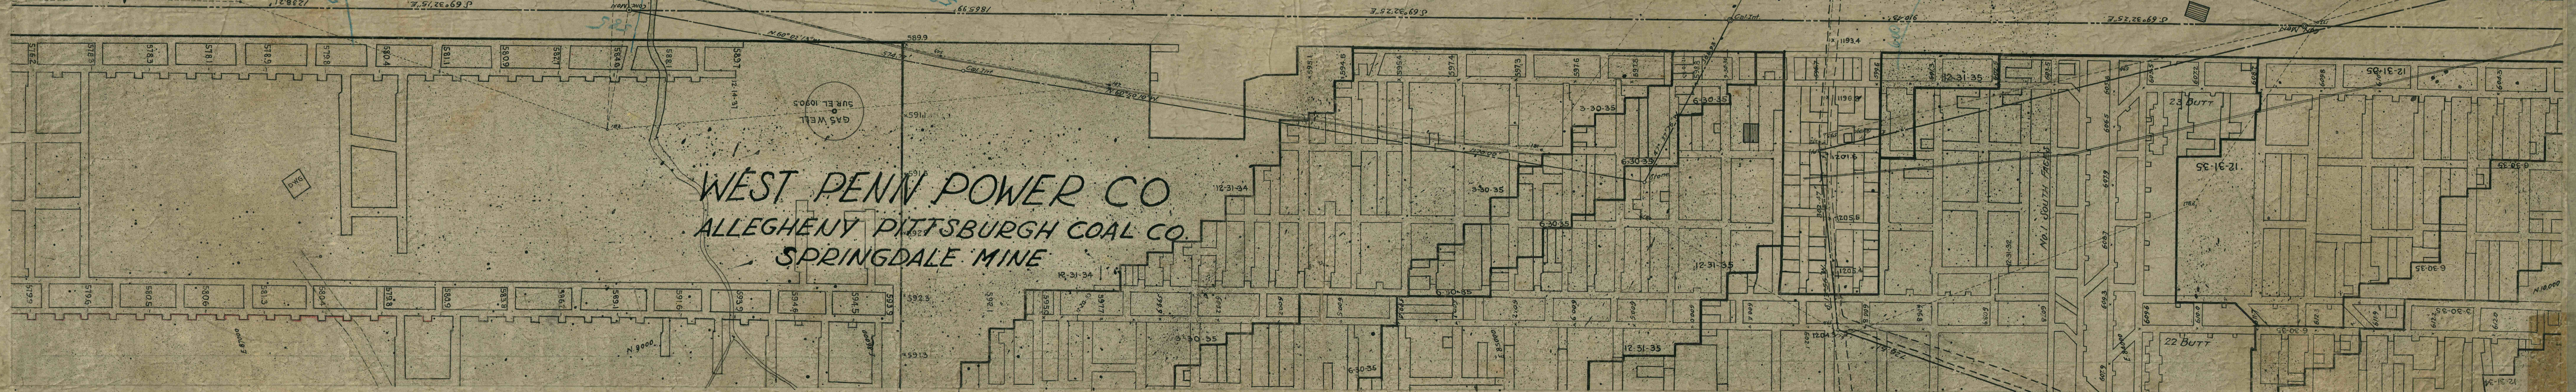

WEST PENN POWER CO  
 ALLEGHENY PITTSBURGH COAL CO.  
 SPRINGDALE MINE