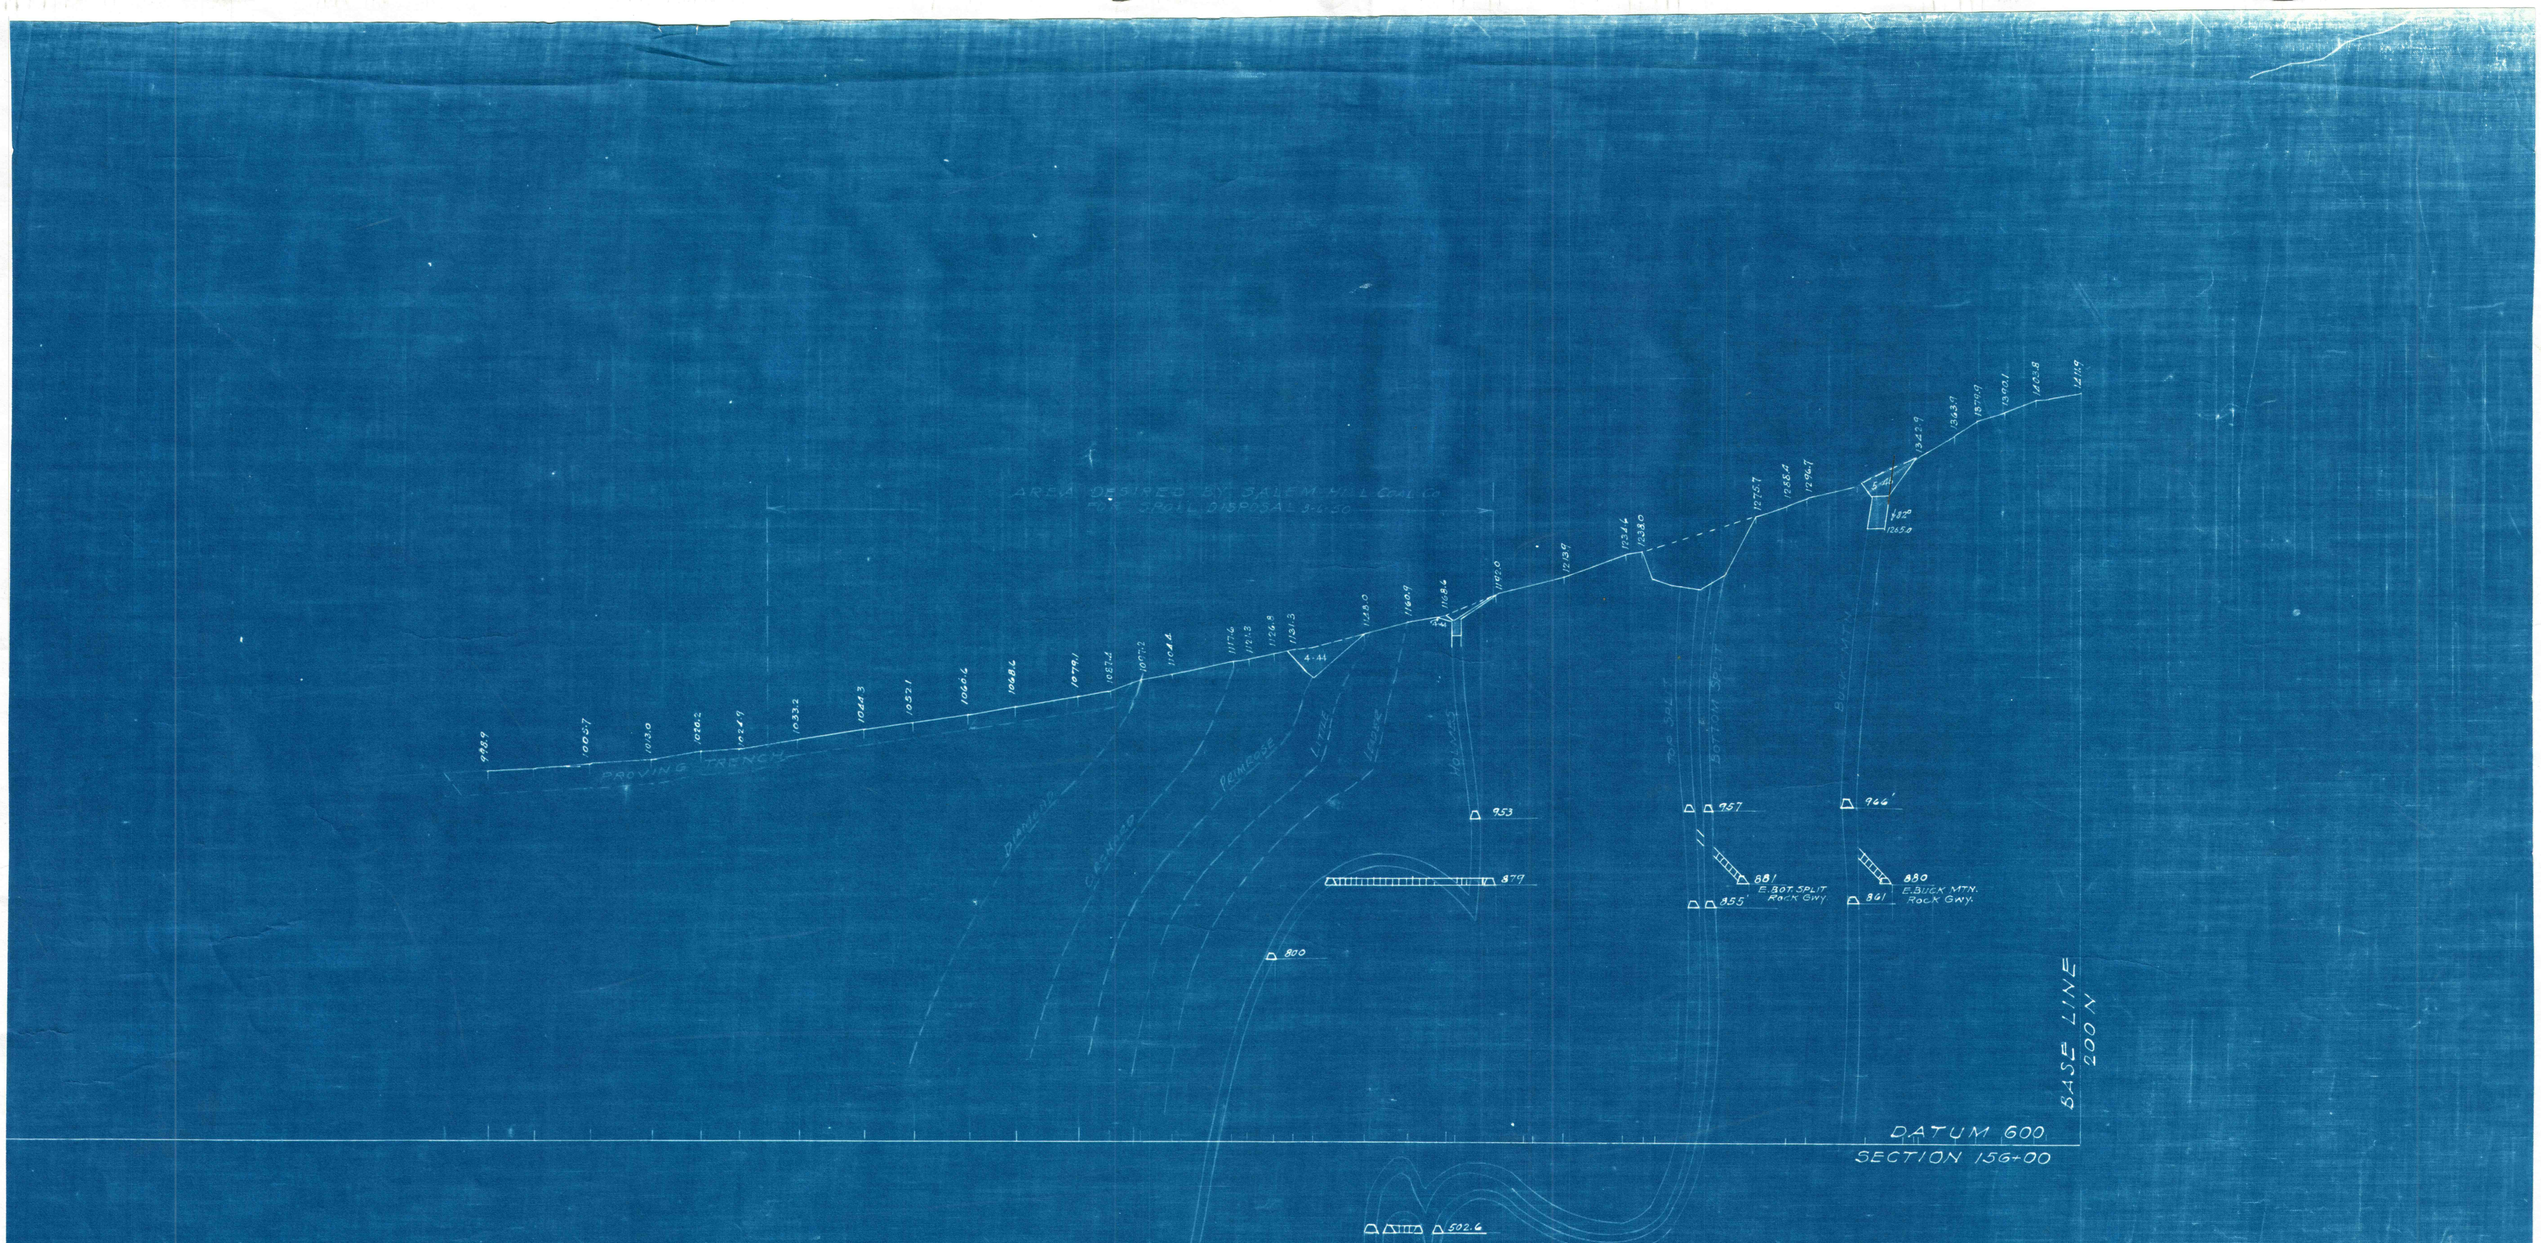
AREA DESIRED BY SALEM-H & L COAL CO FOR SPOIL DISPOSAL 9-1-50
PROVING TRENCH
9989
10057
10130
10202
10249
10332
10443
10521
10604
10686
10796
10874
10977.2
11044
11174
11213
11268
11291.3
11328.0
11369
11384
11418.0
11439
12314
12380
12775.7
12854
12944.7
13423.9
13437
13769
13903.1
14030.8
12119
4-44
5-41
432°
1265.0
953
957
966
879
881
E. BOT. SPLIT
Rock Qwy.
955'
861
880
E. BUCK MTN.
Rock Qwy.
800
DIAMOND
CREEK
PEWTERS
LITTLE
LAUREL
HOLLOW
BOTTOM SPLIT
BUCK MTN.
BASE LINE
200 N
DATUM 600
SECTION 156+00
502.6