


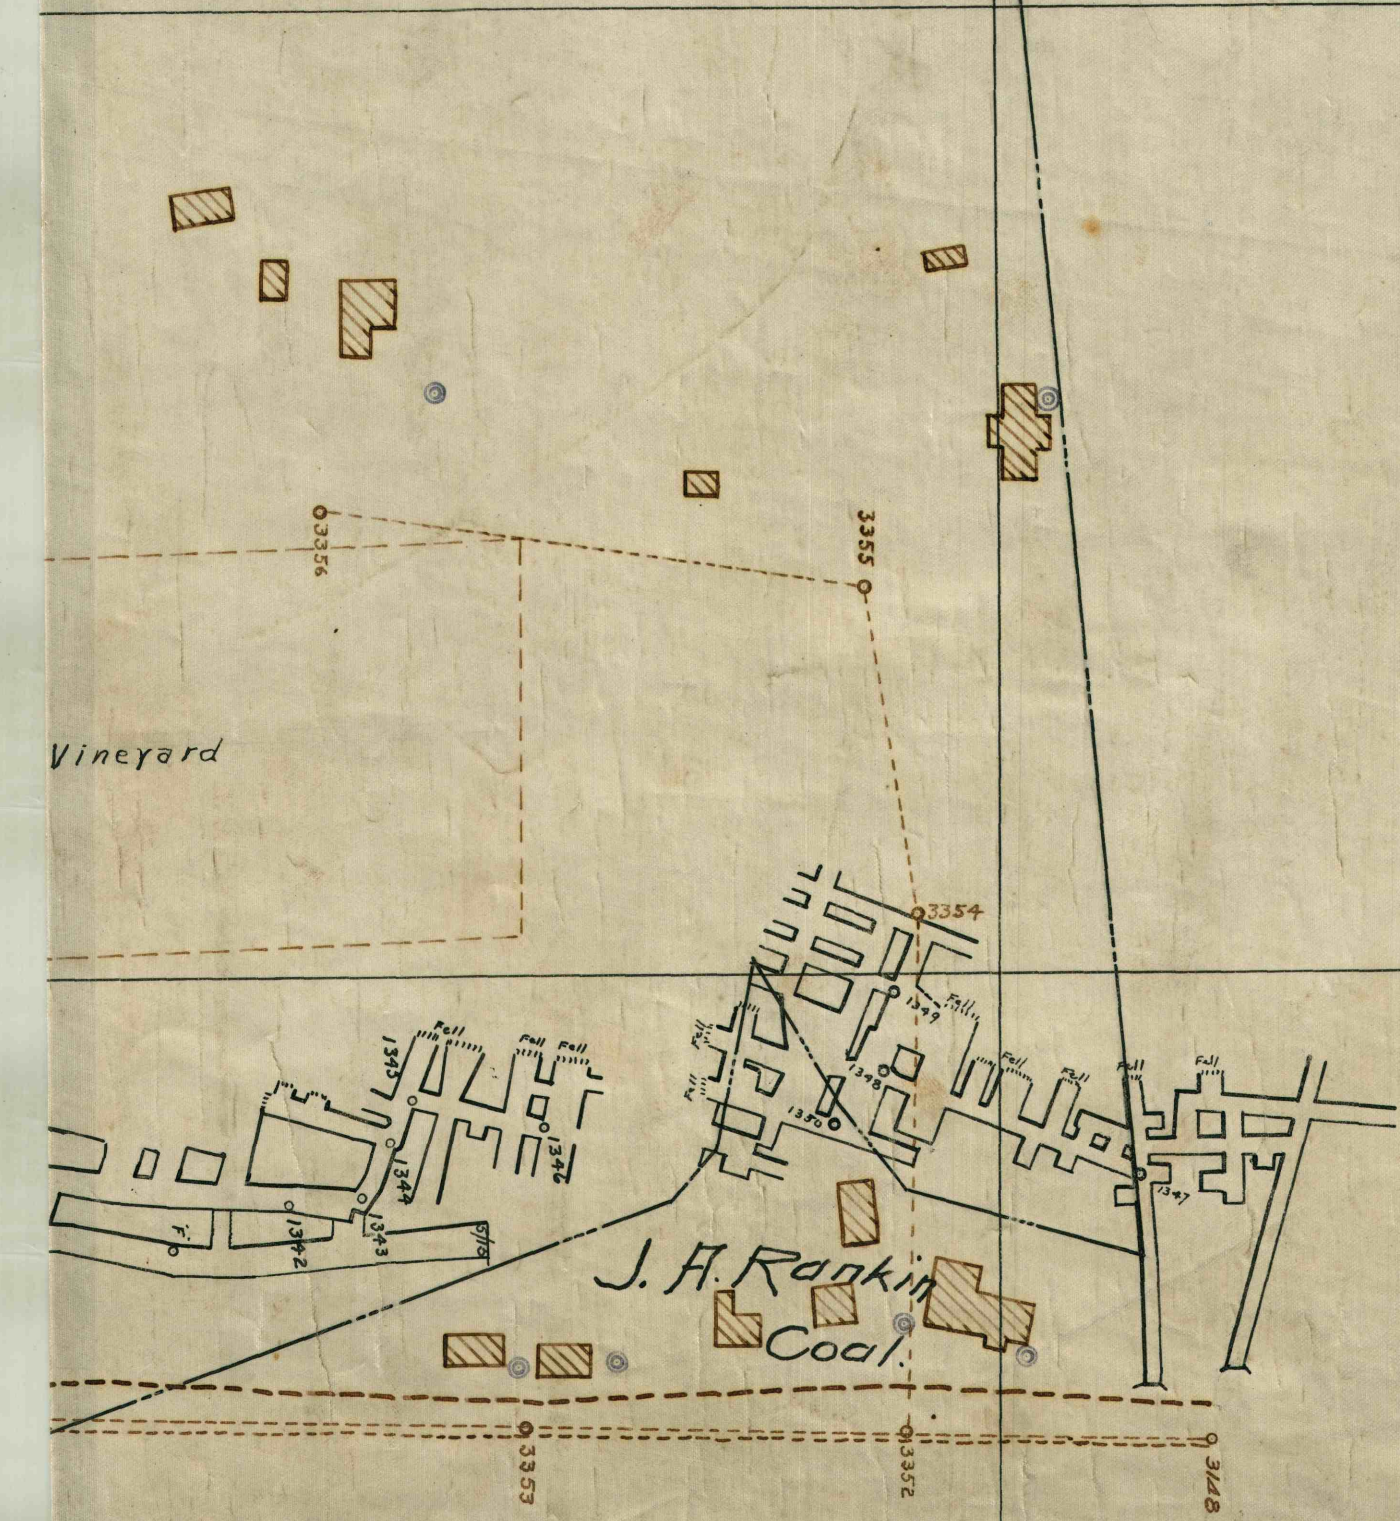

Fidelity Old Workings



Map of the
VESTA No. 2 MINE —
(AMERICAN)

Scale 1 in = 100 ft. 1912.

Abandoned Sept 1915