


2ND HILL  
5


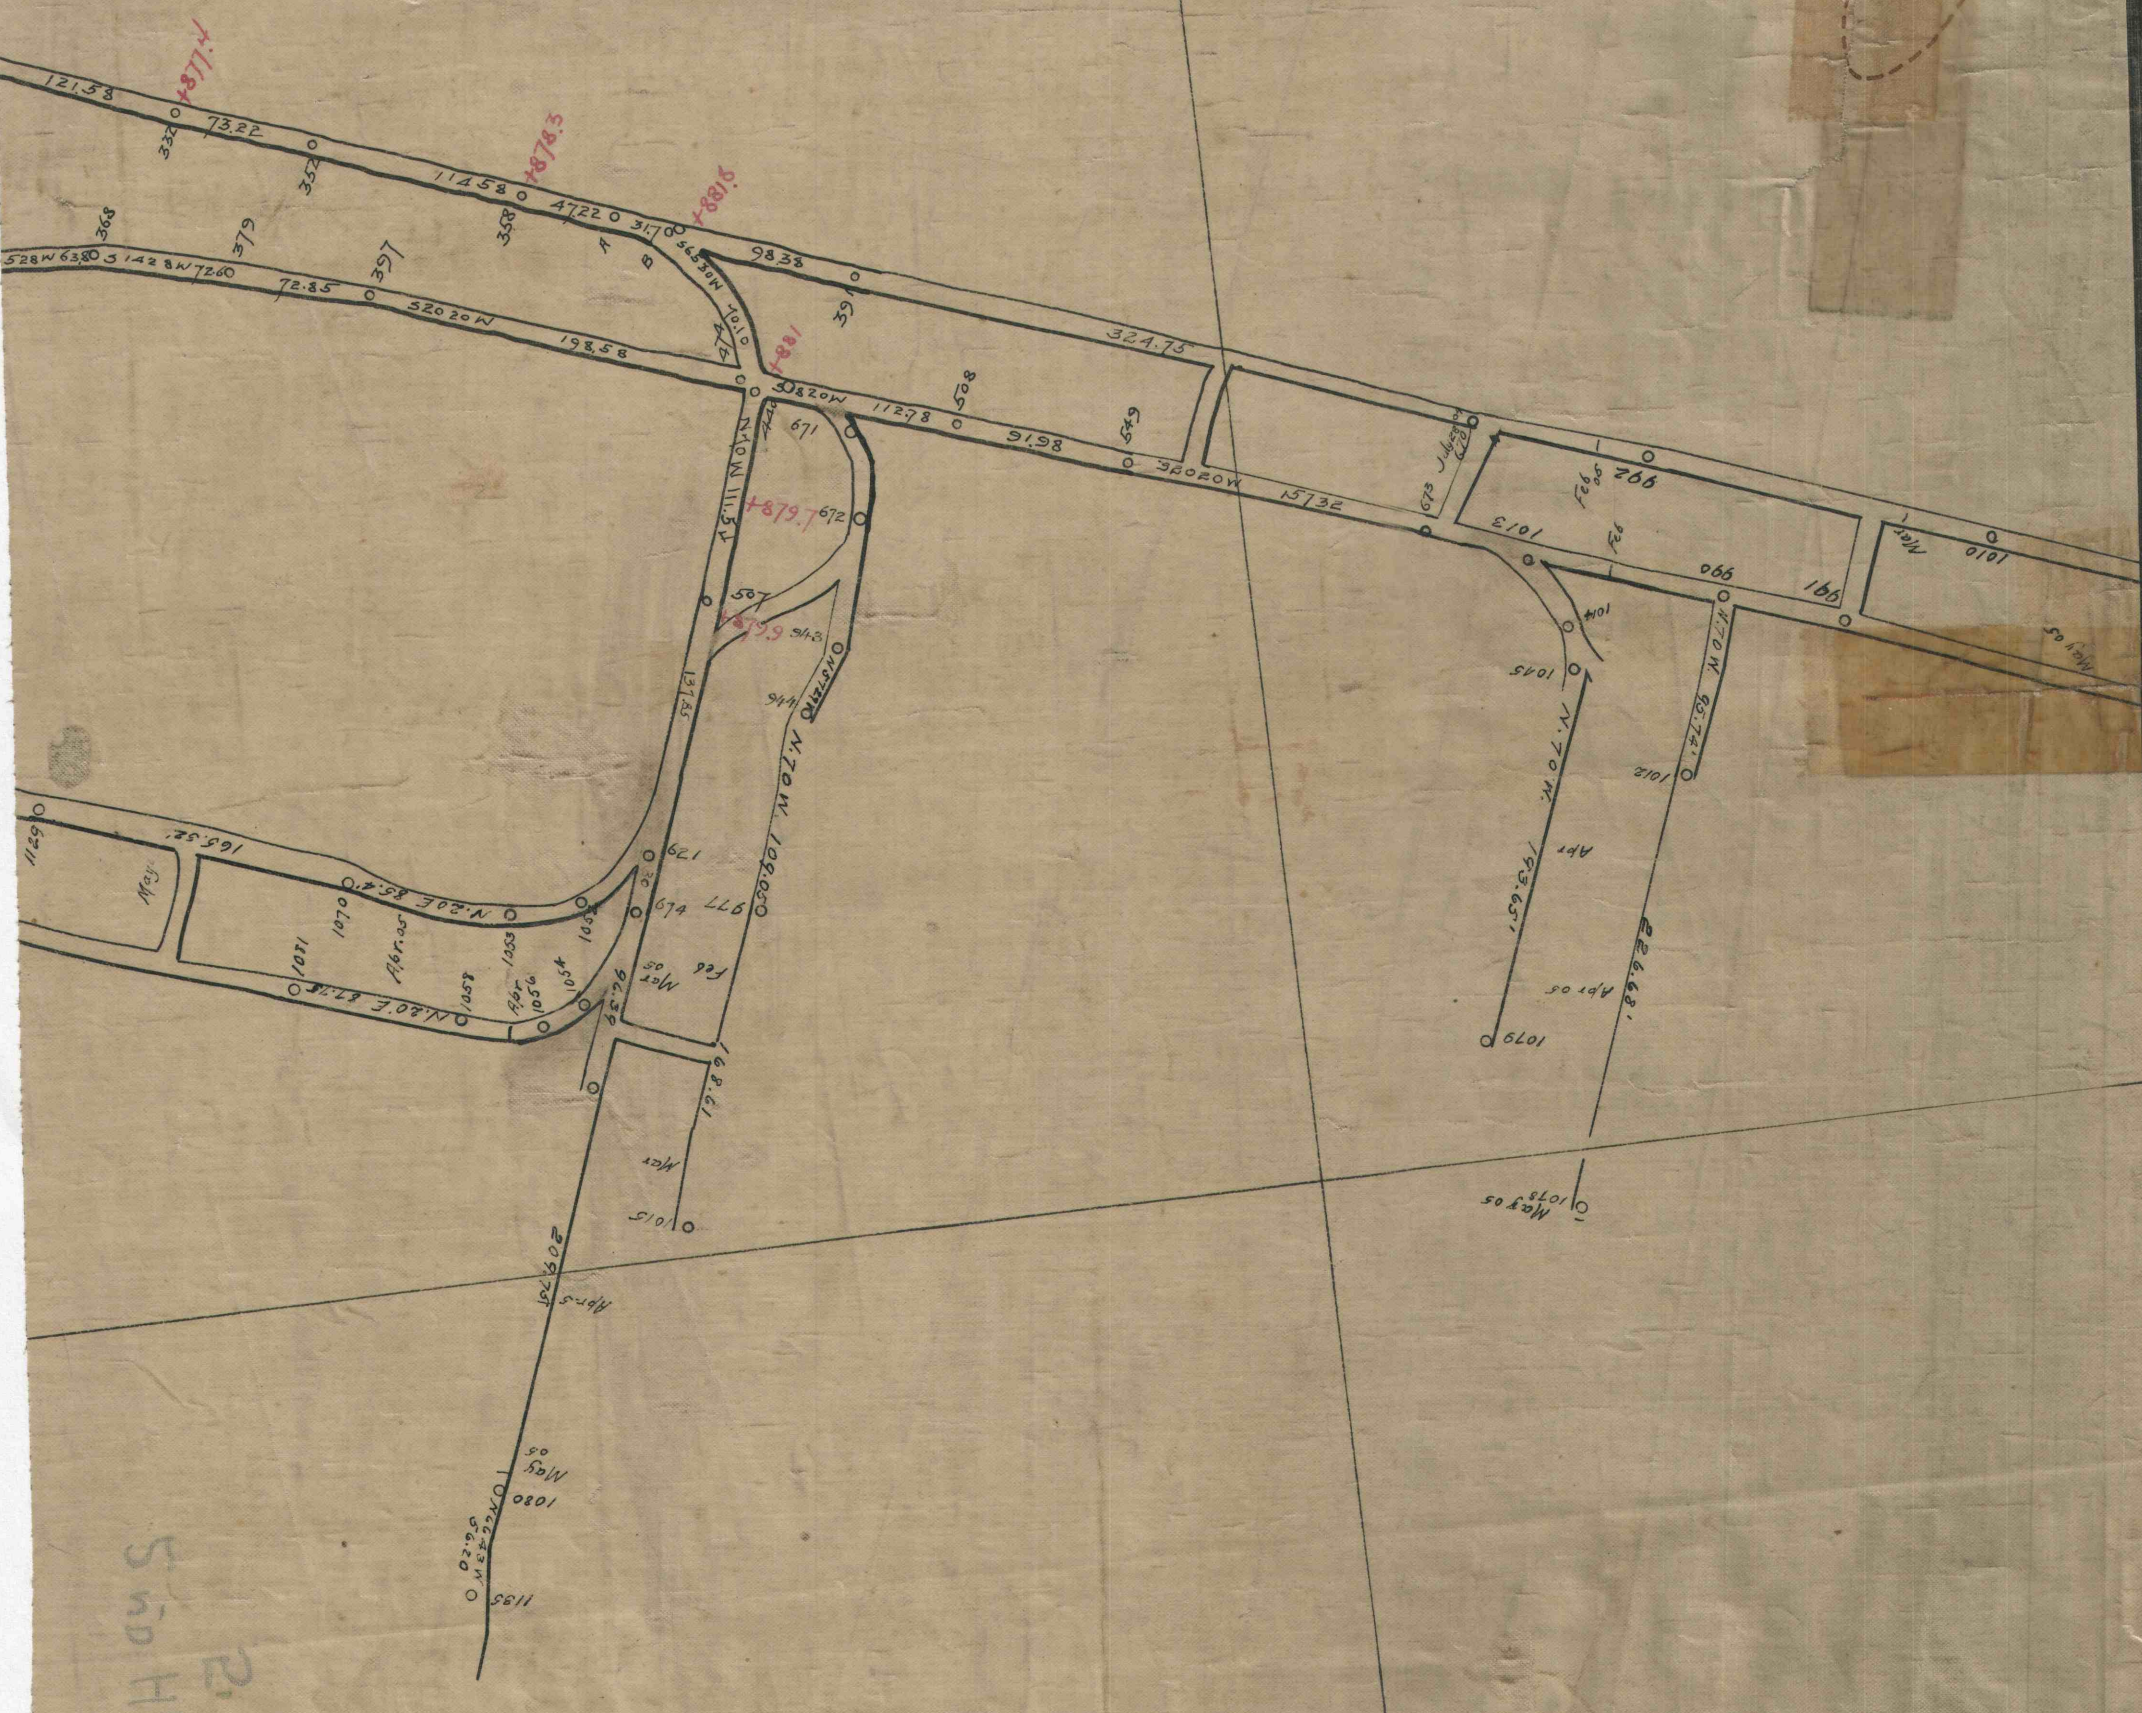



