


T-1-5-N

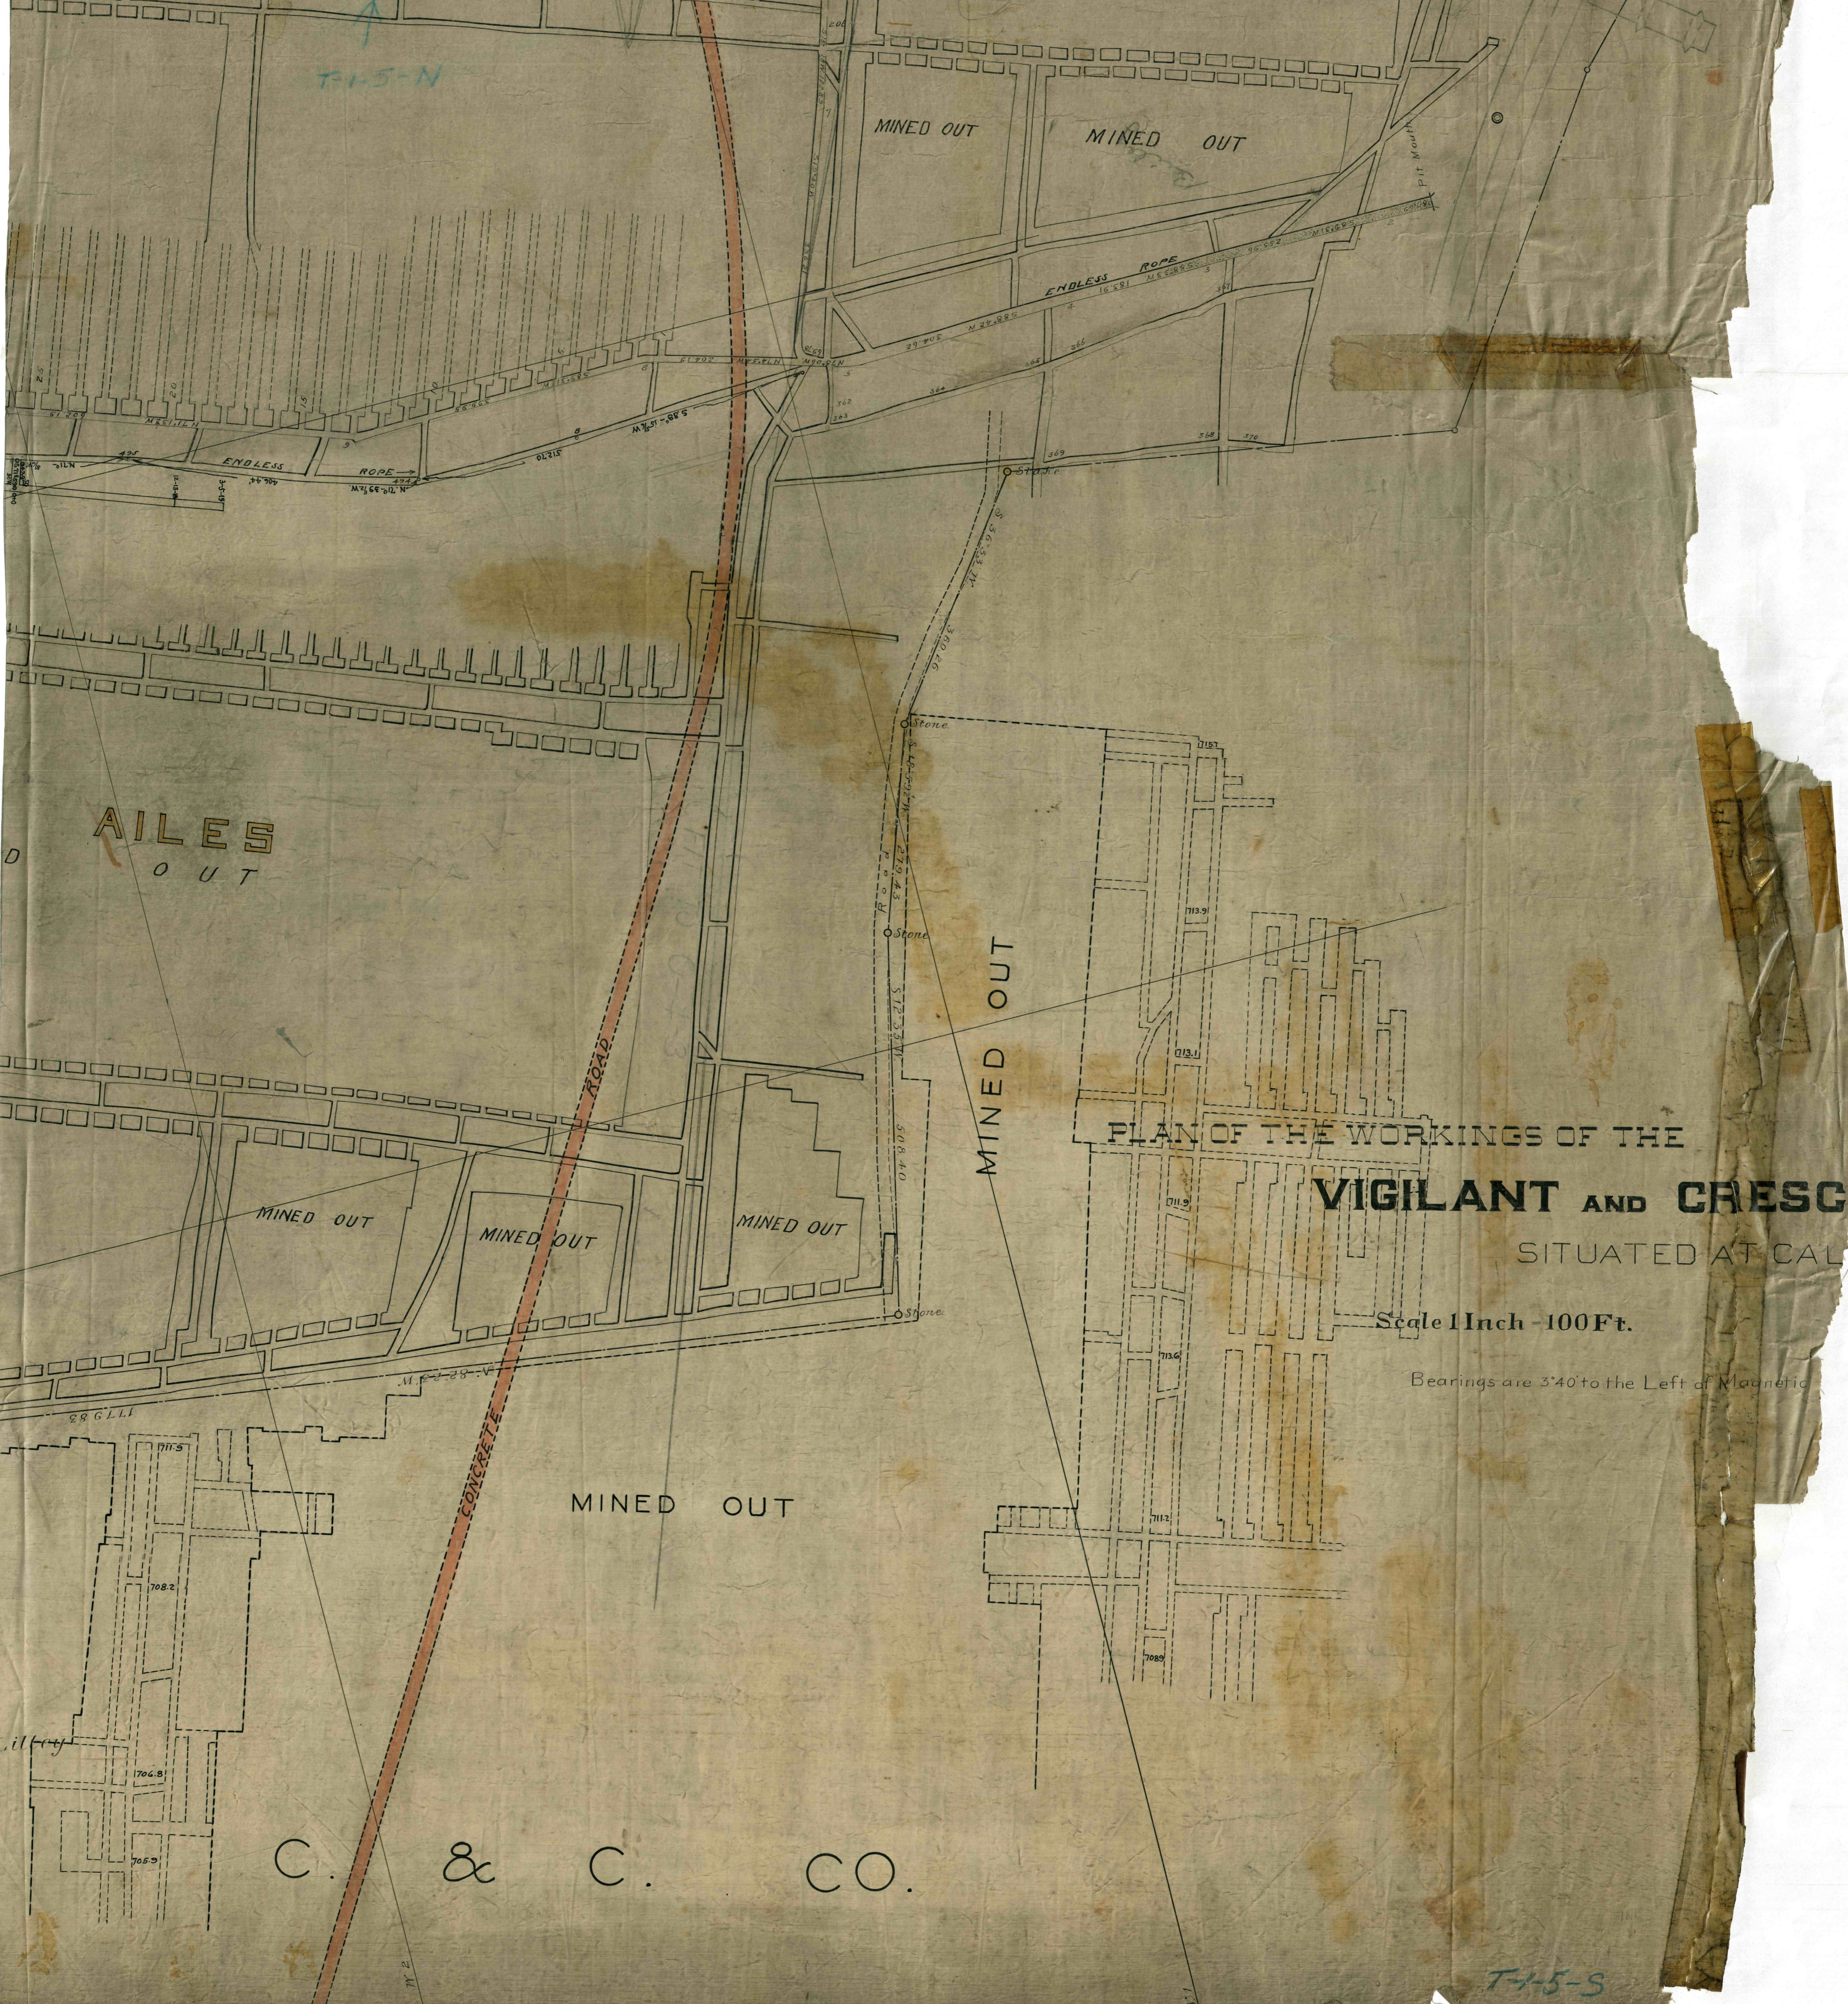

MINED OUT

MINED OUT

MINED OUT

MINED OUT

MINED OUT

MINED OUT

MINED OUT

MINED OUT

PLAN OF THE WORKINGS OF THE
VIGILANT AND CRESCENT
 SITUATED AT CALIFORNIA

Scale 1 Inch = 100 Ft.

Bearings are 3'40" to the Left of Magnetic

C. & C. CO.

T-1-5-S