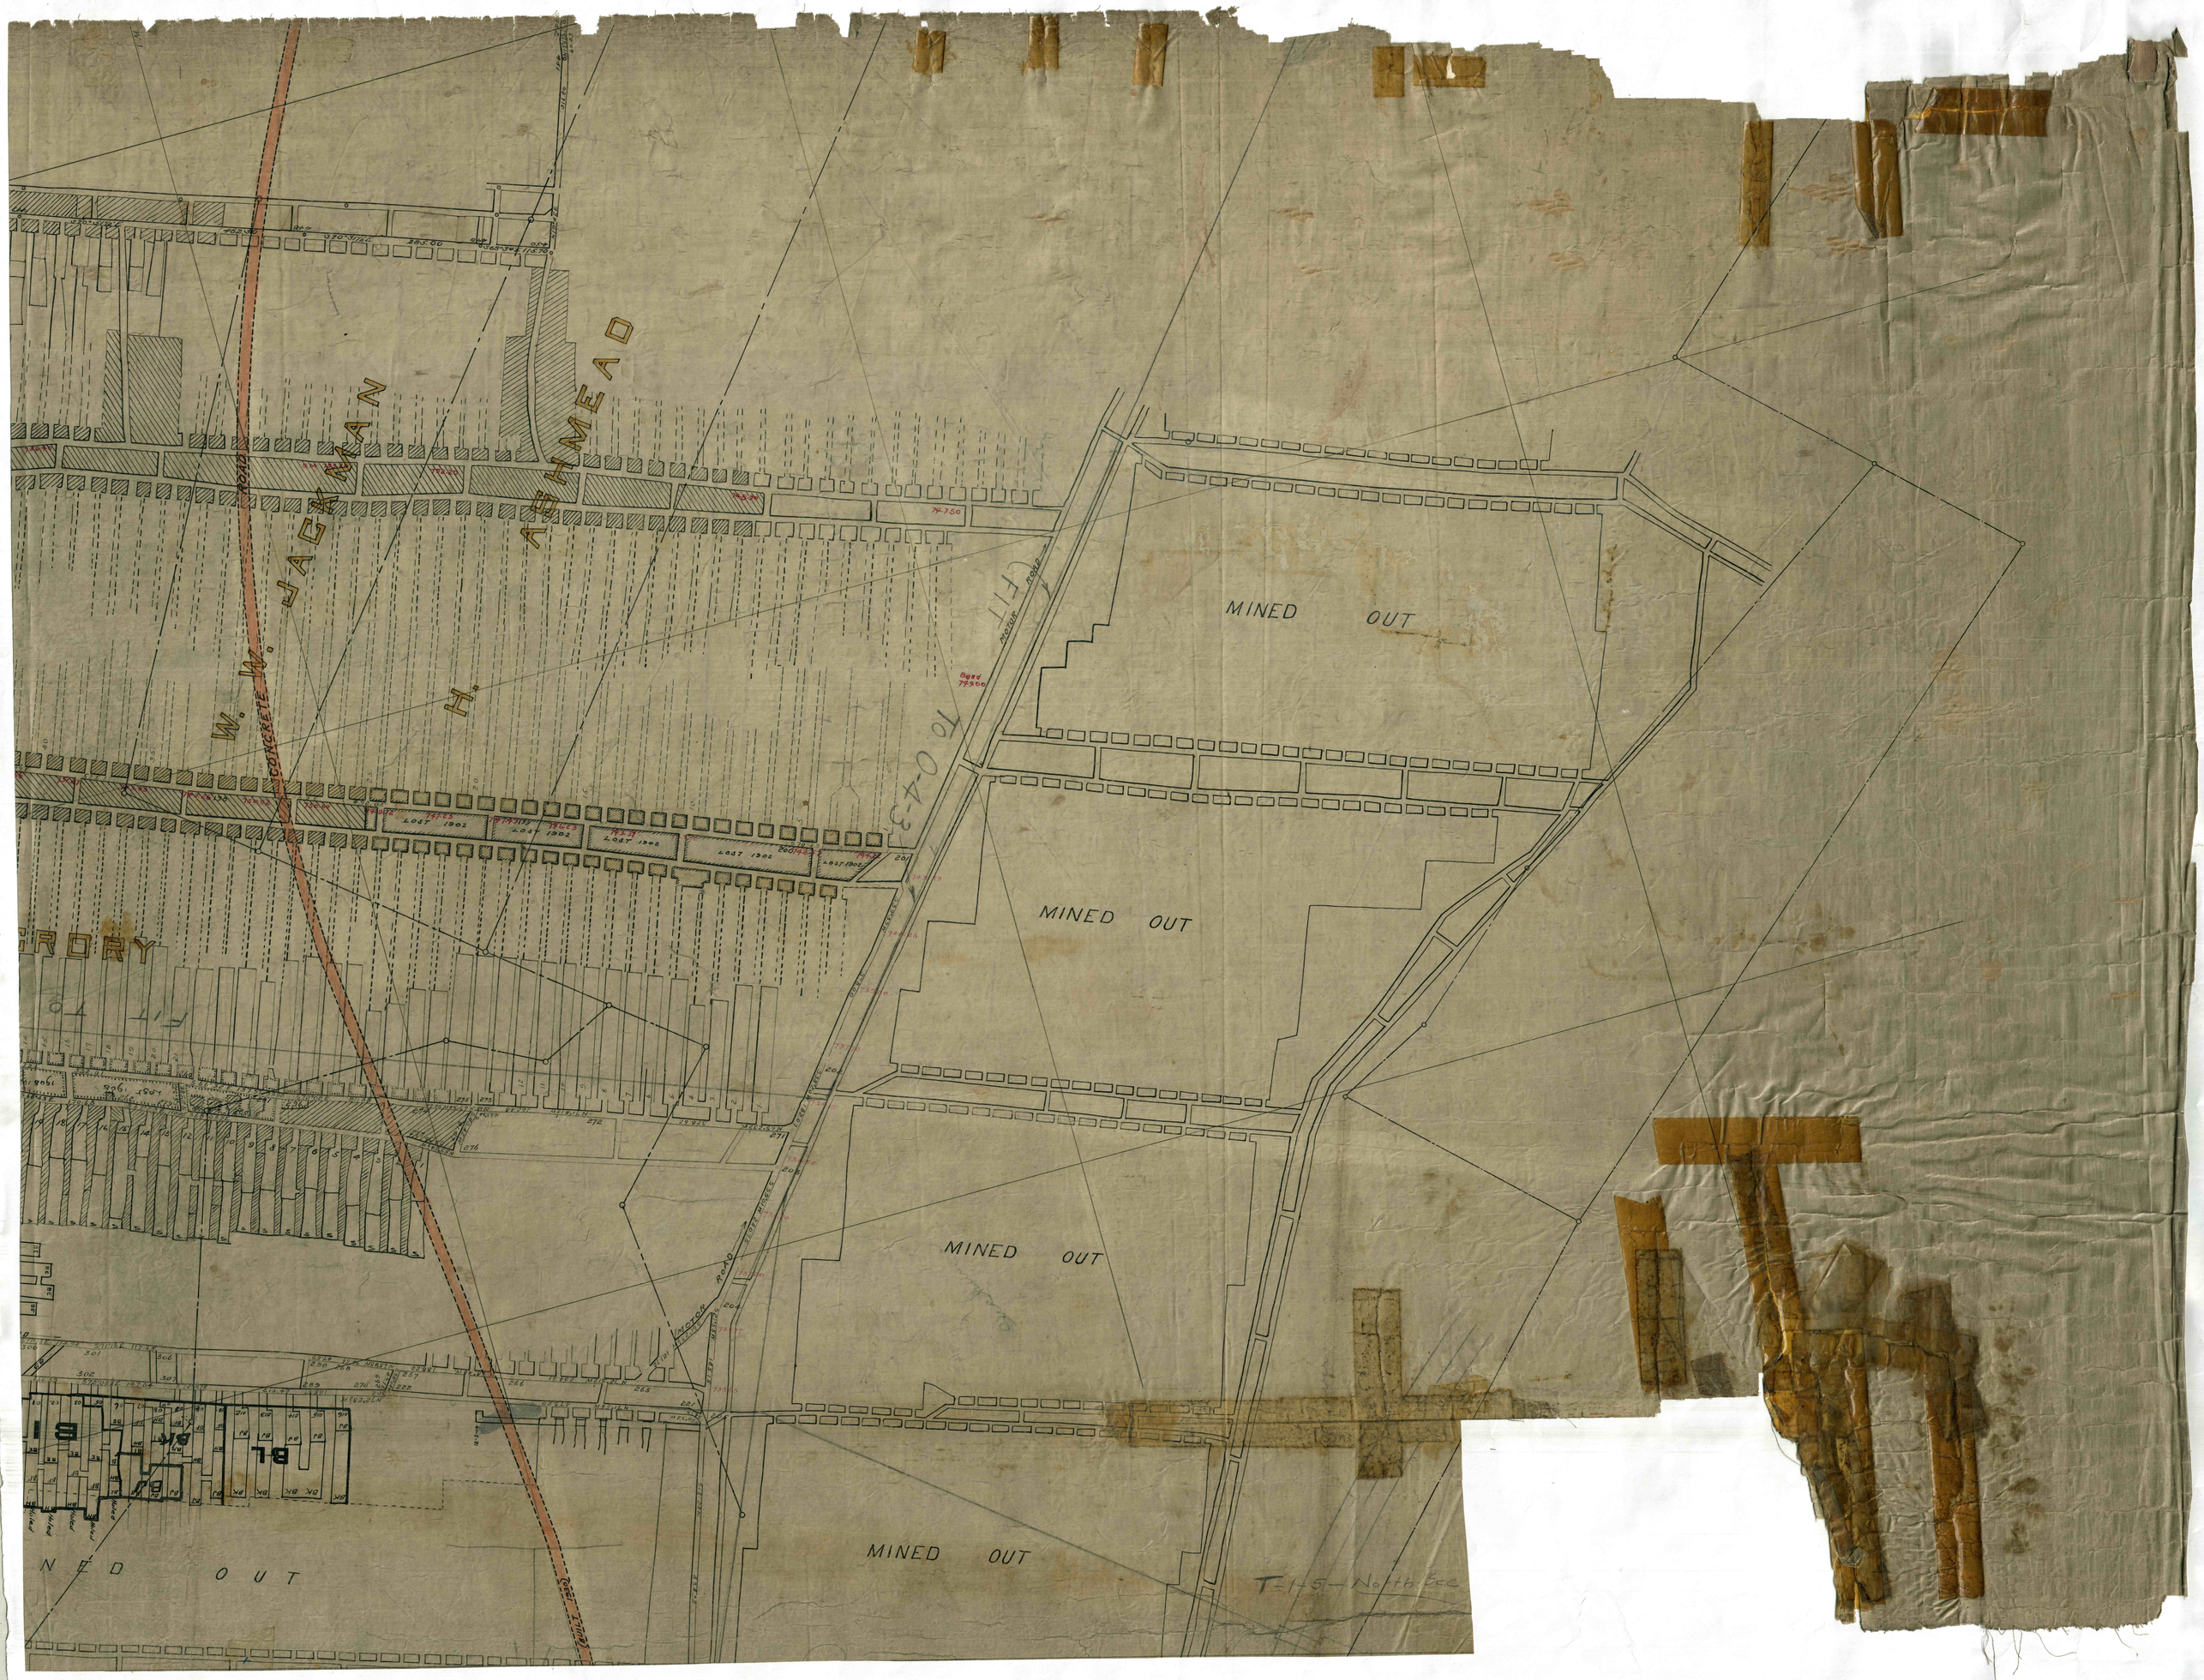

W. W. JACKMAN
H. ASHMEAD
CONCRETE ROAD
MINED OUT
MINED OUT
MINED OUT
MINED OUT
MINED OUT
LOST 1902
LOST 1902
LOST 1902
LOST 1902
LOST 1902
MOTOR ROAD
MOTOR ROAD
T-1-5-North Sec