


DIAMOND COAL & COKE COMPANY

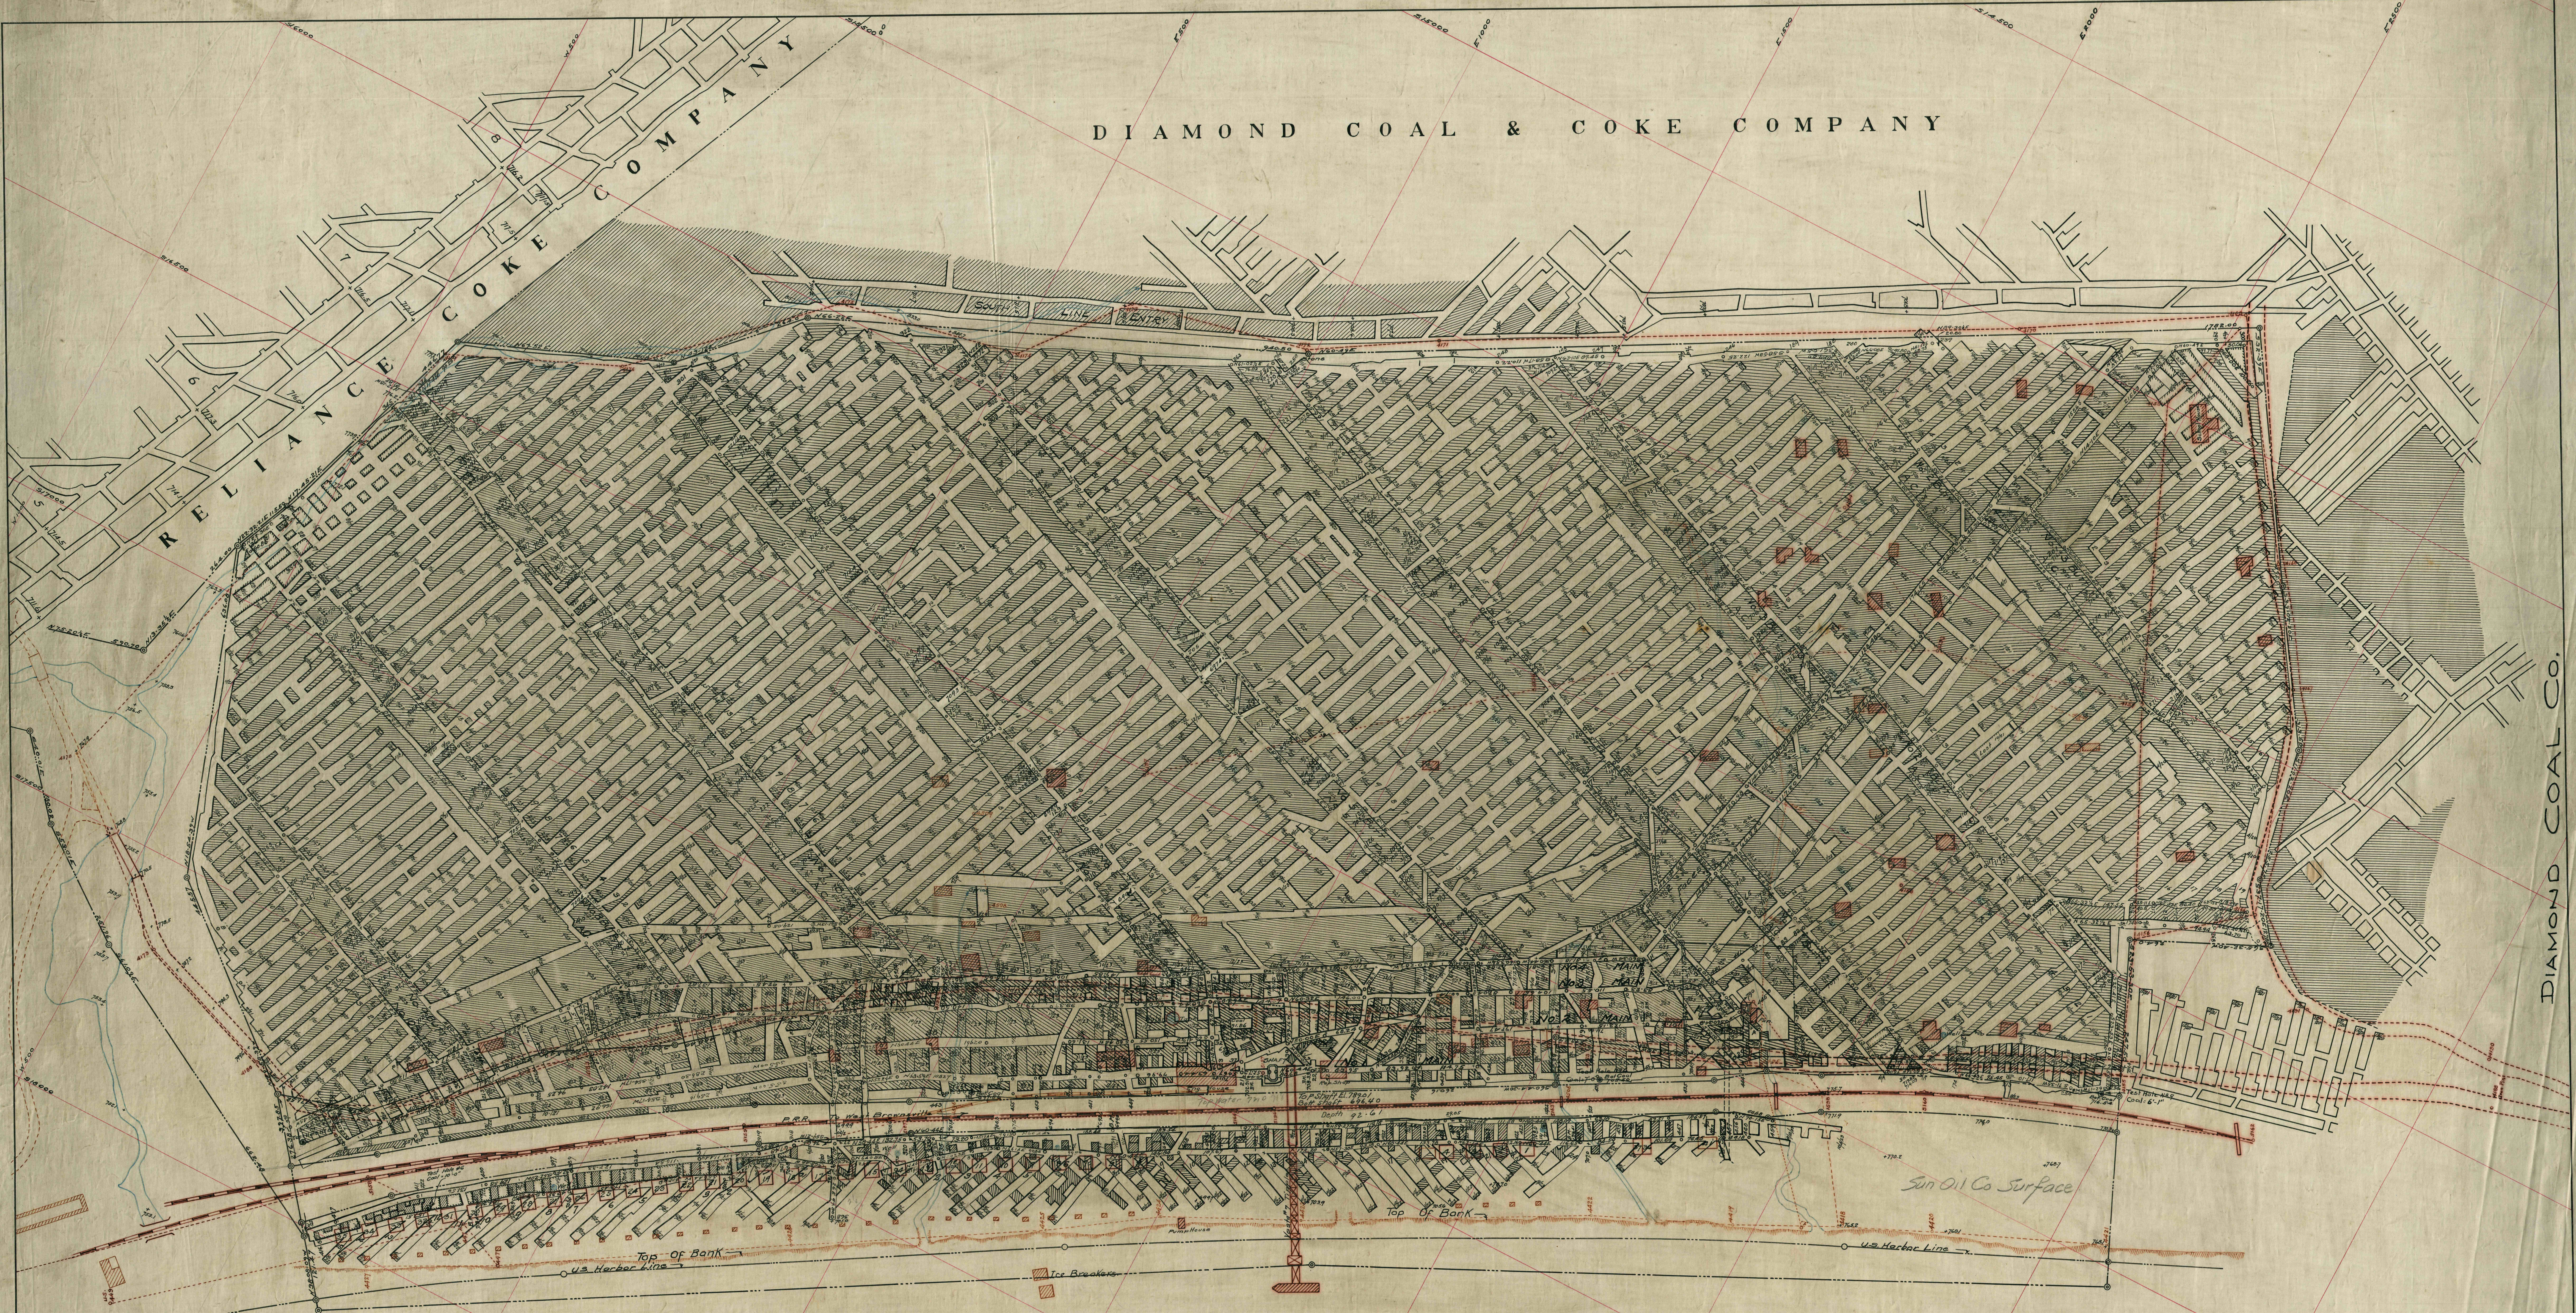

VESTA No 7 MINE

ENGR DEPT V. C. CO. FEB 22 1918

SCALE 1"=100'

ABANDONED DEC. 8 1923

DIAMOND COAL CO.