




HENRY
LARGE.

PETERS CREEK COAL CO.

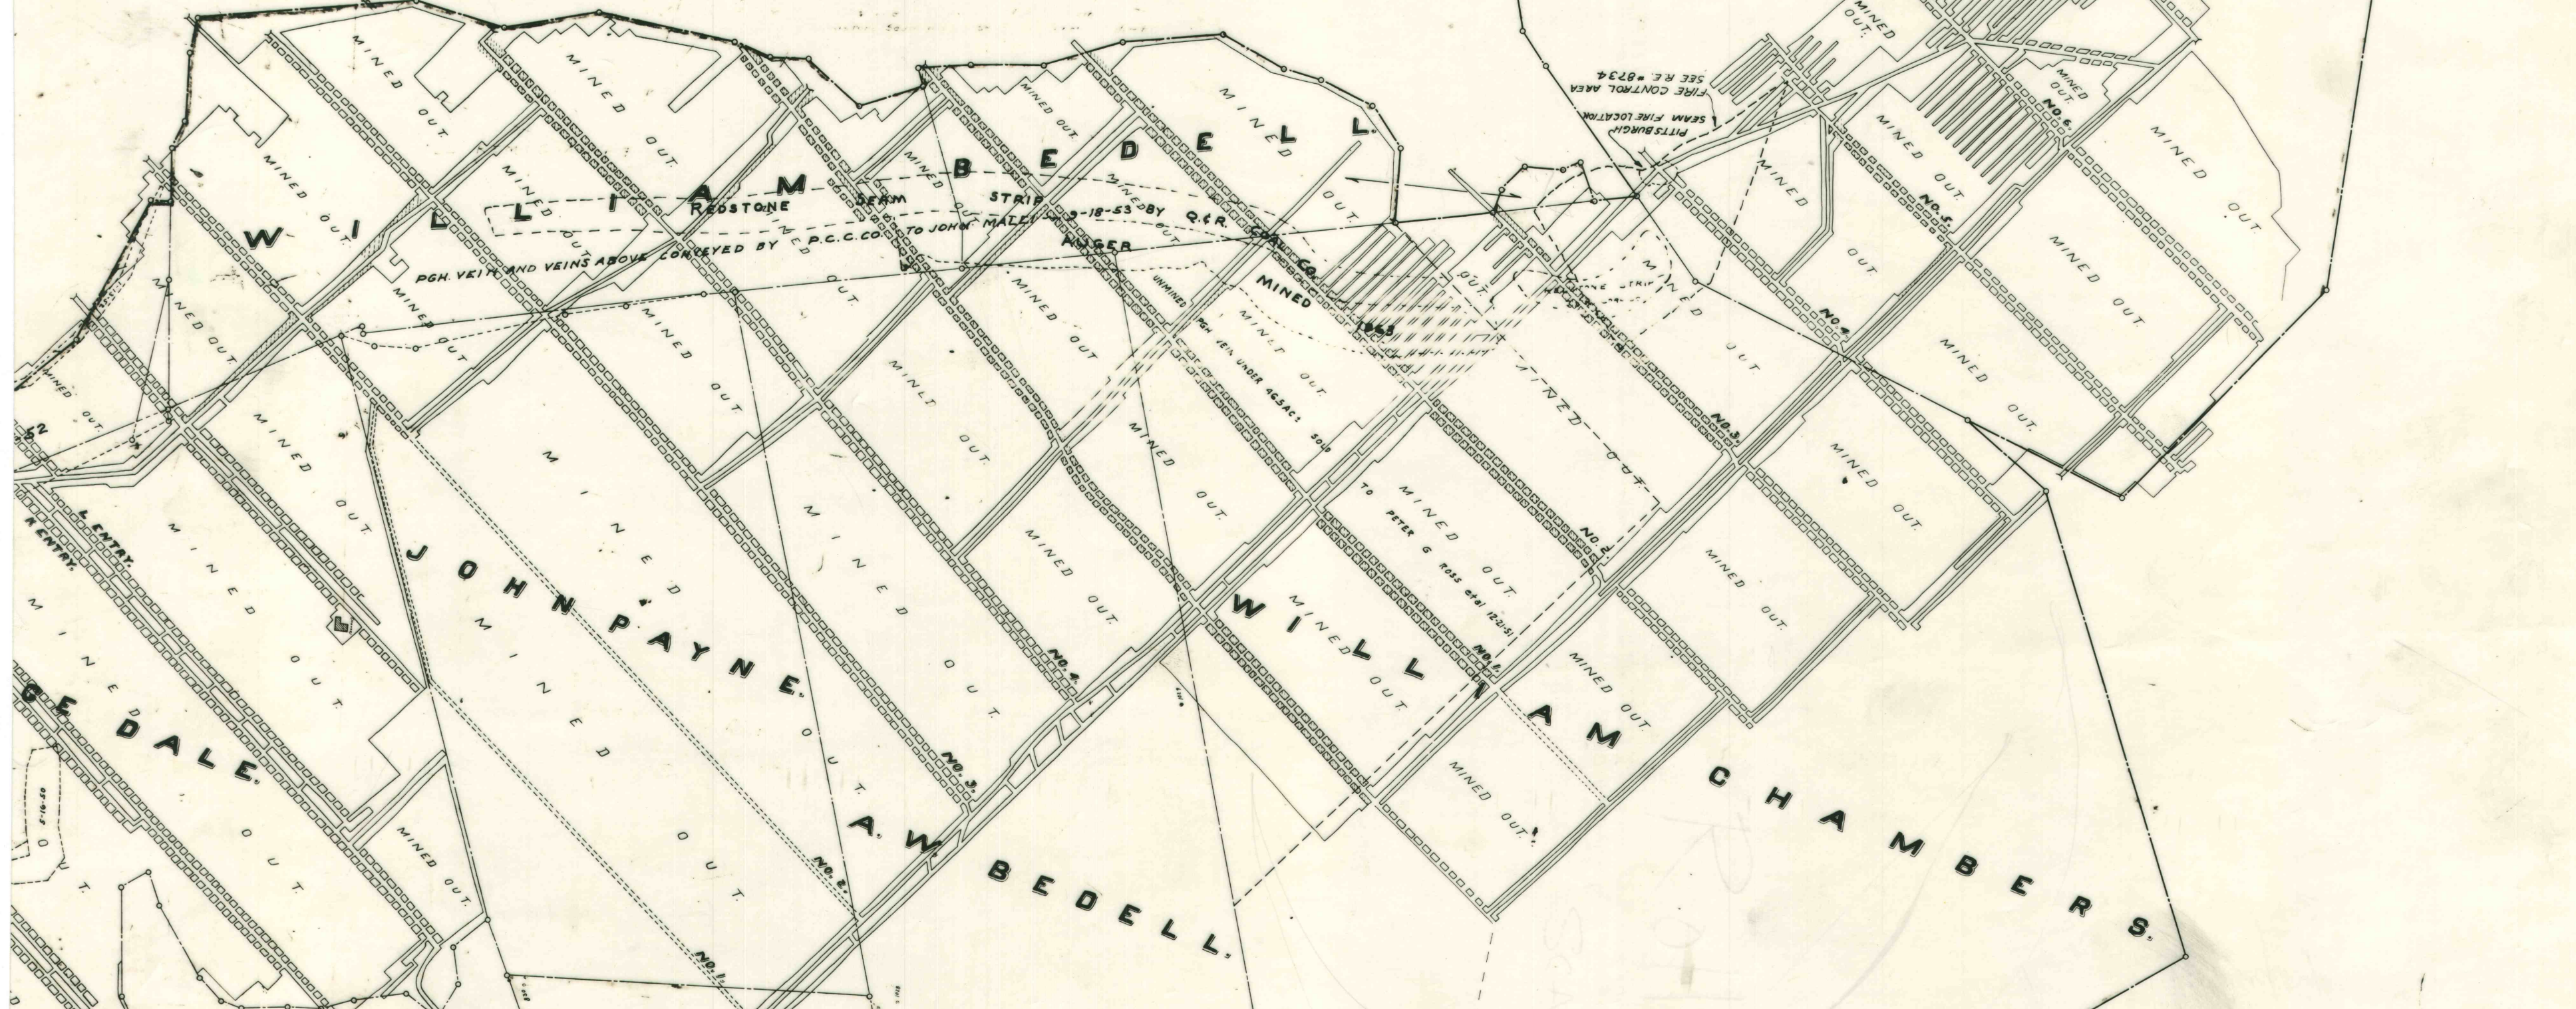

JOHN PAYNE

WILLIAM CHAMBERS

BEDELL

GEO. DALE

M.A. McCORKLE

JOHN PAYNE

LOBB

1" = 400'