


W.C. + C. Co. # of 6

H. C. Frick Coke Co.

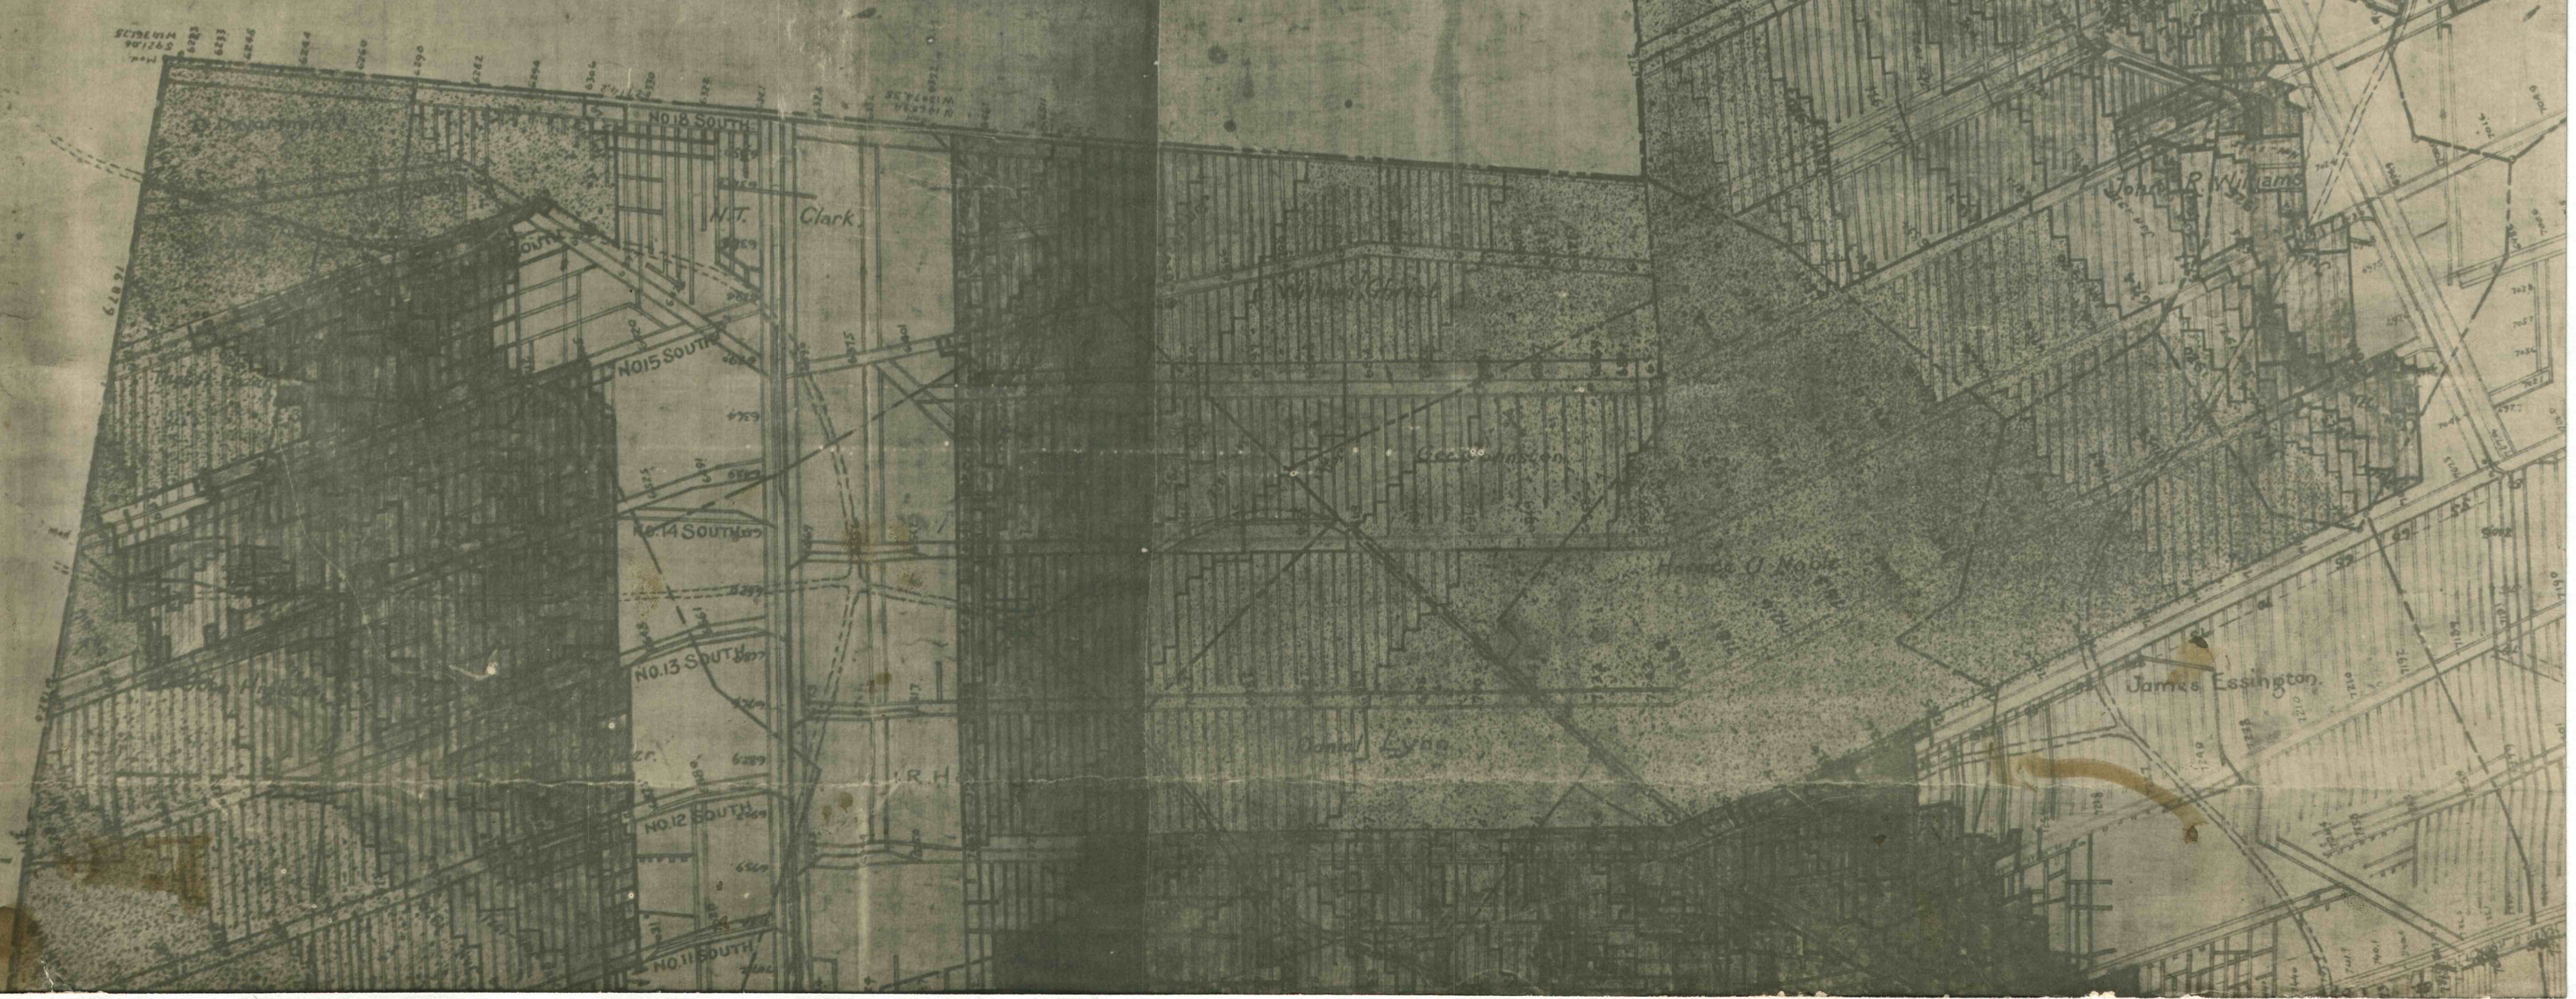

Keep With DD-15-4