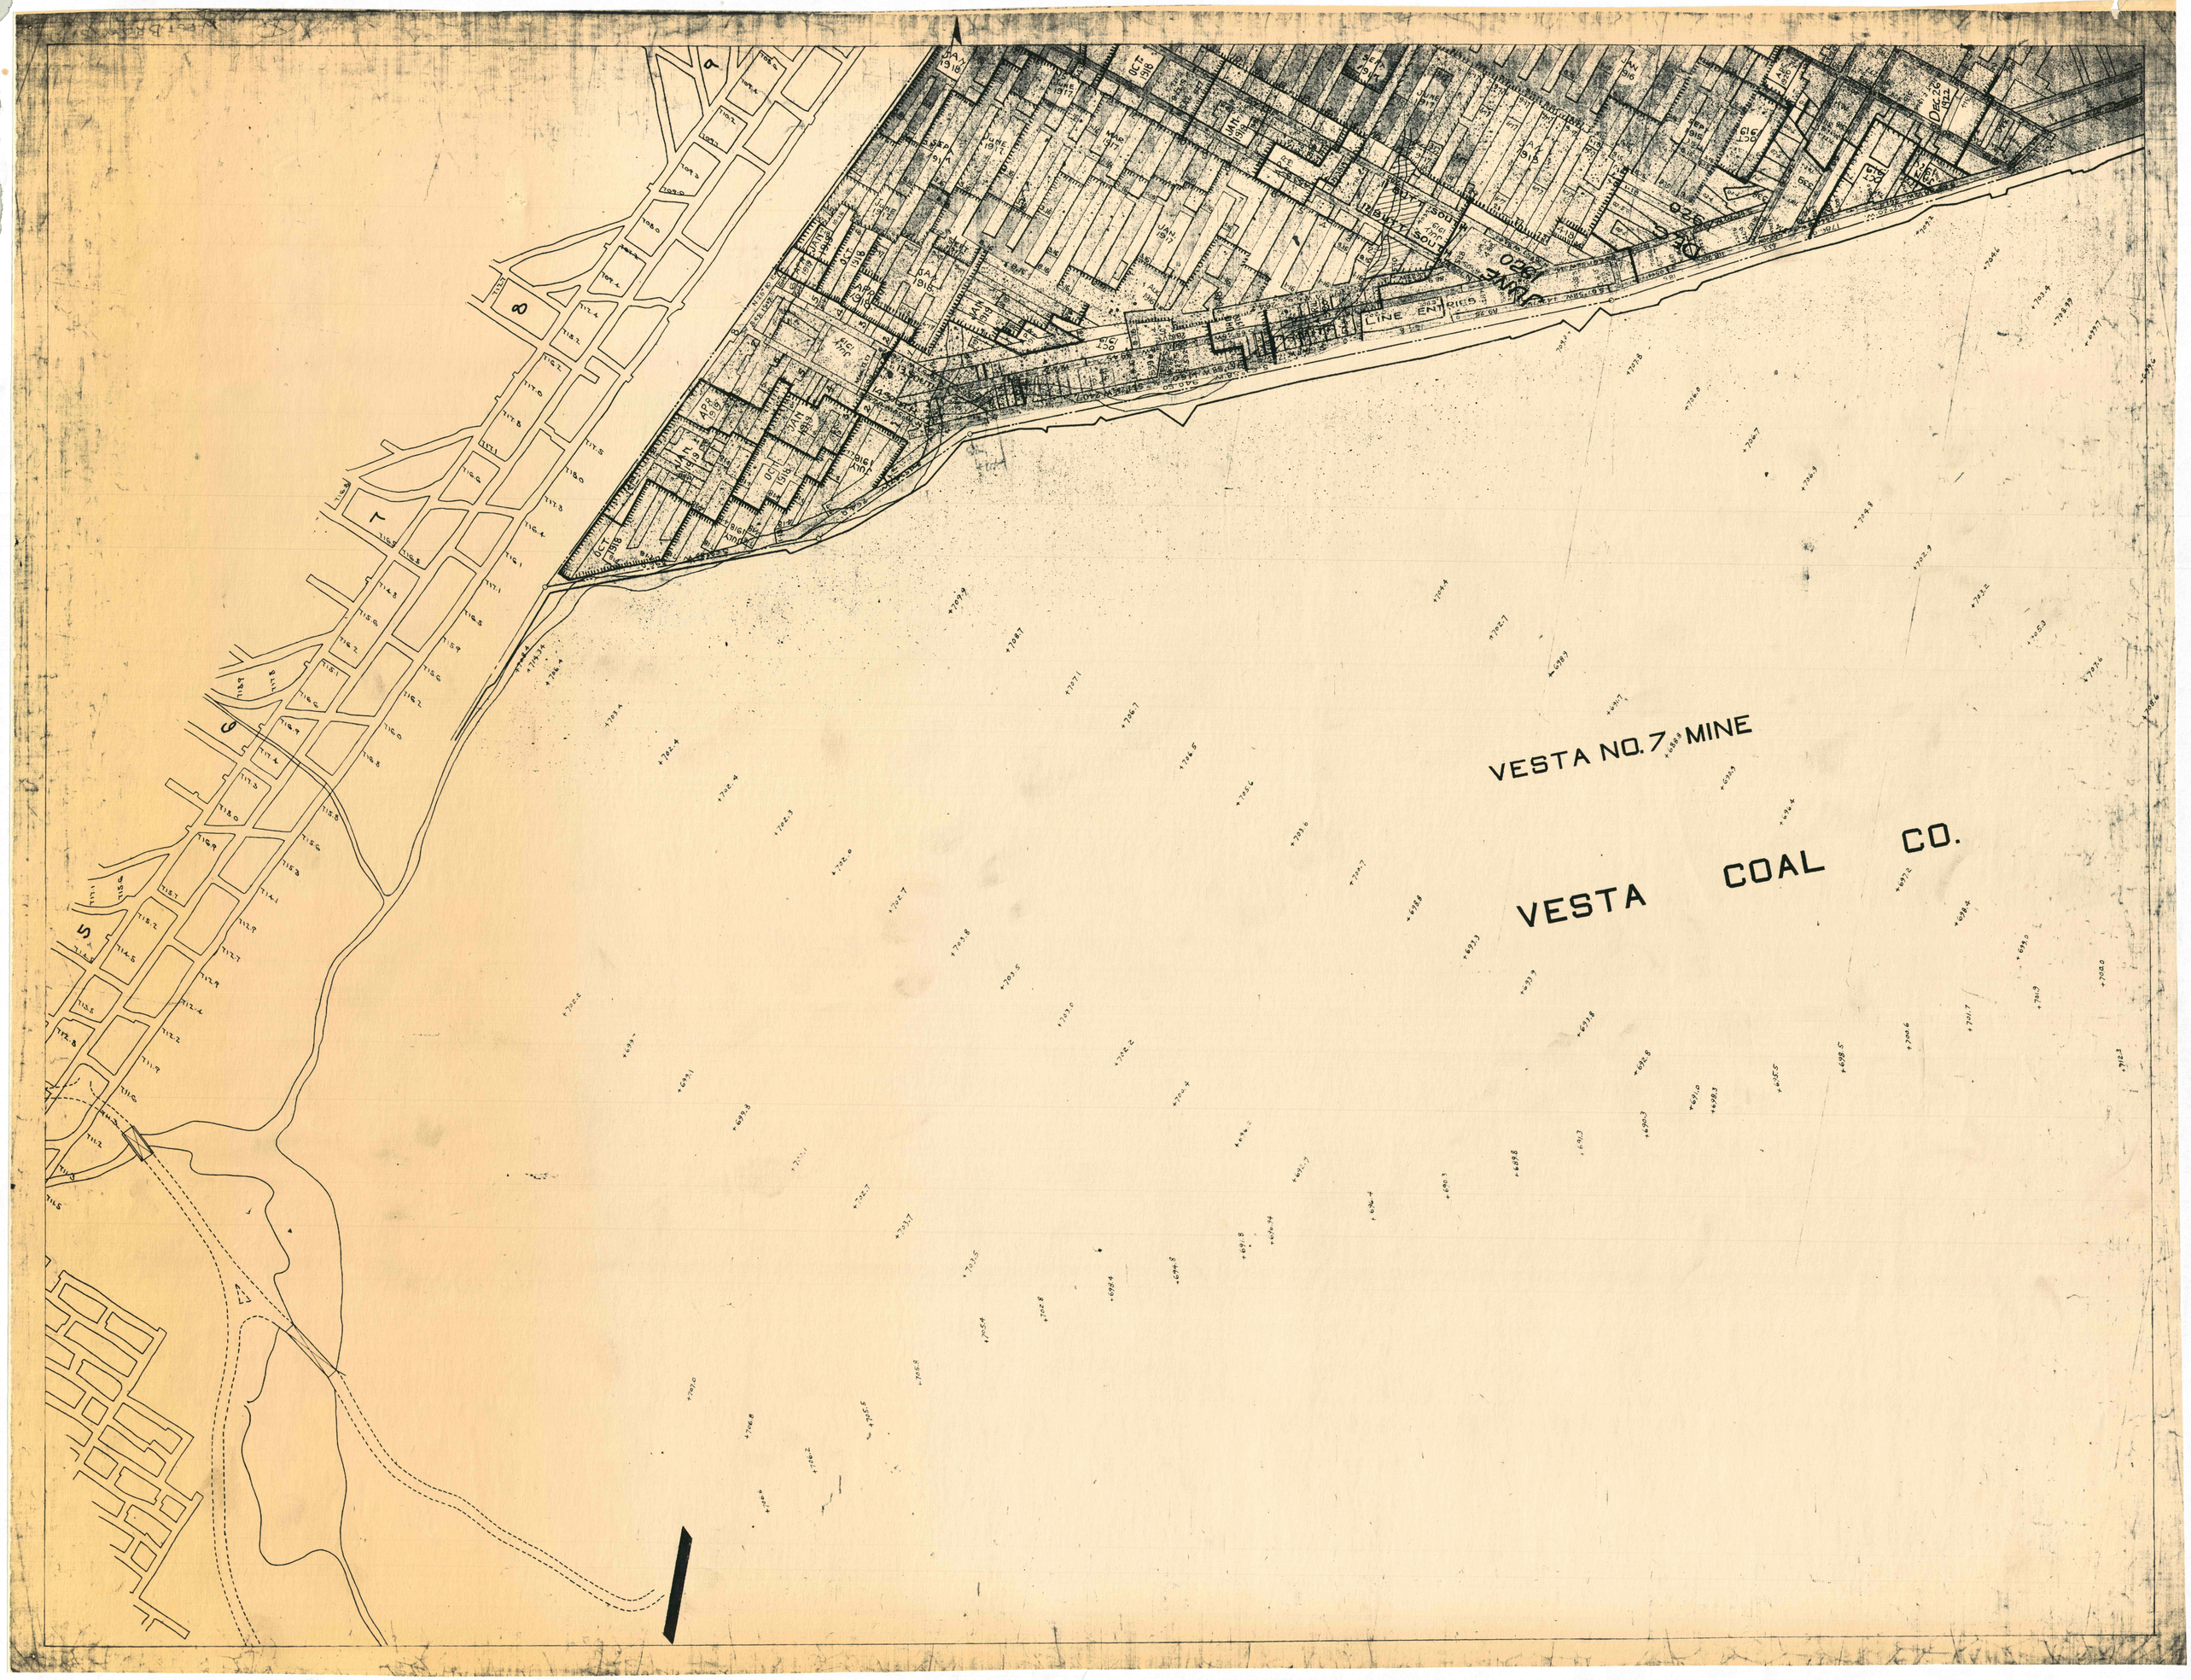
VESTA NO. 7 MINE
VESTA COAL CO.
LINE ENTRIES
TABBYTT SOUTH
JUNE 1920
DEC. 26 1912
OCT 1916
JAN 1917
APR 1916
JAN 1919
JAN 1918
JUNE 1917
JAN 1915
JUNE 1918
JUNE 1919
JUNE 1916
SEP 1917
JUNE 1917
JUNE 1915
JUNE 1914
