


442742-5809 II
West Newton Survey

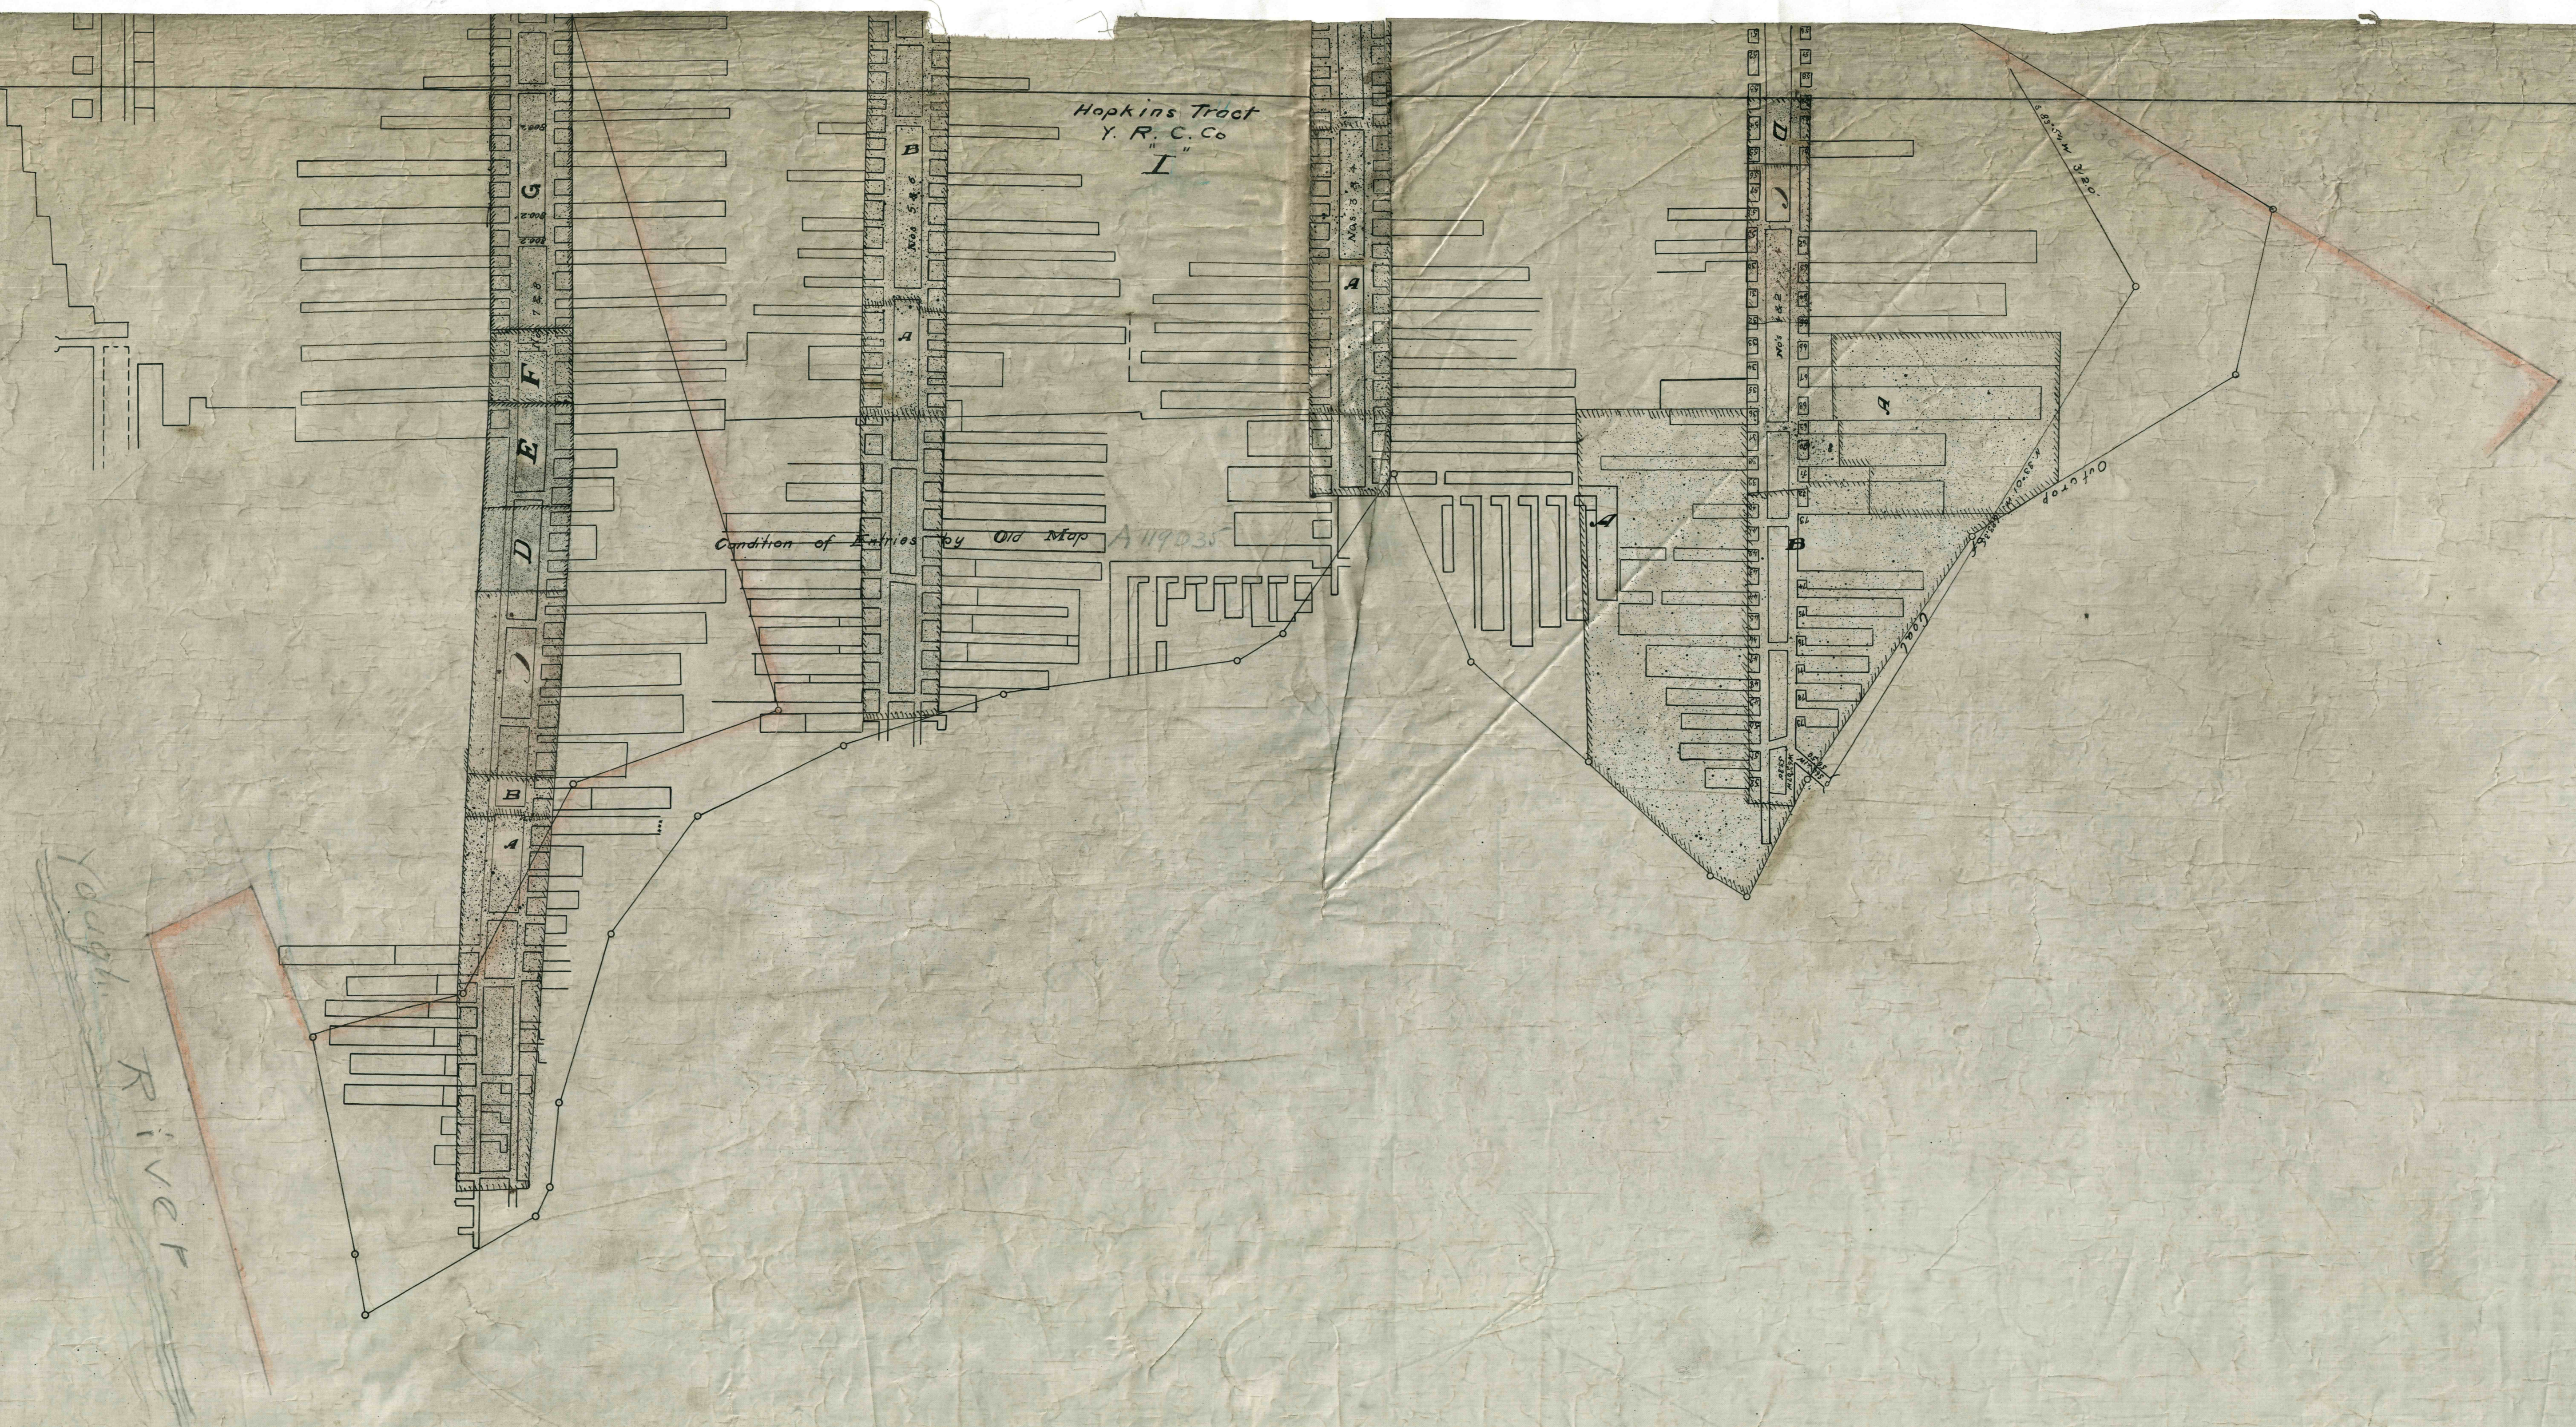

Hopkins Tract
Y. R. C. Co.
I


Yough River