

**JOHN W. BOLLINS**  
AREA 67.075 ACRES  
56


Southwest Pennsylvania Railway Unity Branch Right of way

**DANIEL HOFFMAN**  
AREA 73.576 ACRES  
1.2.5.6.A.

RES. 430  
AREA 5.000 ACRES

**GEORGE GEIGER**  
AREA 40.940 ACRES  
1.2.5.6.A.

**MARY HEIRS**

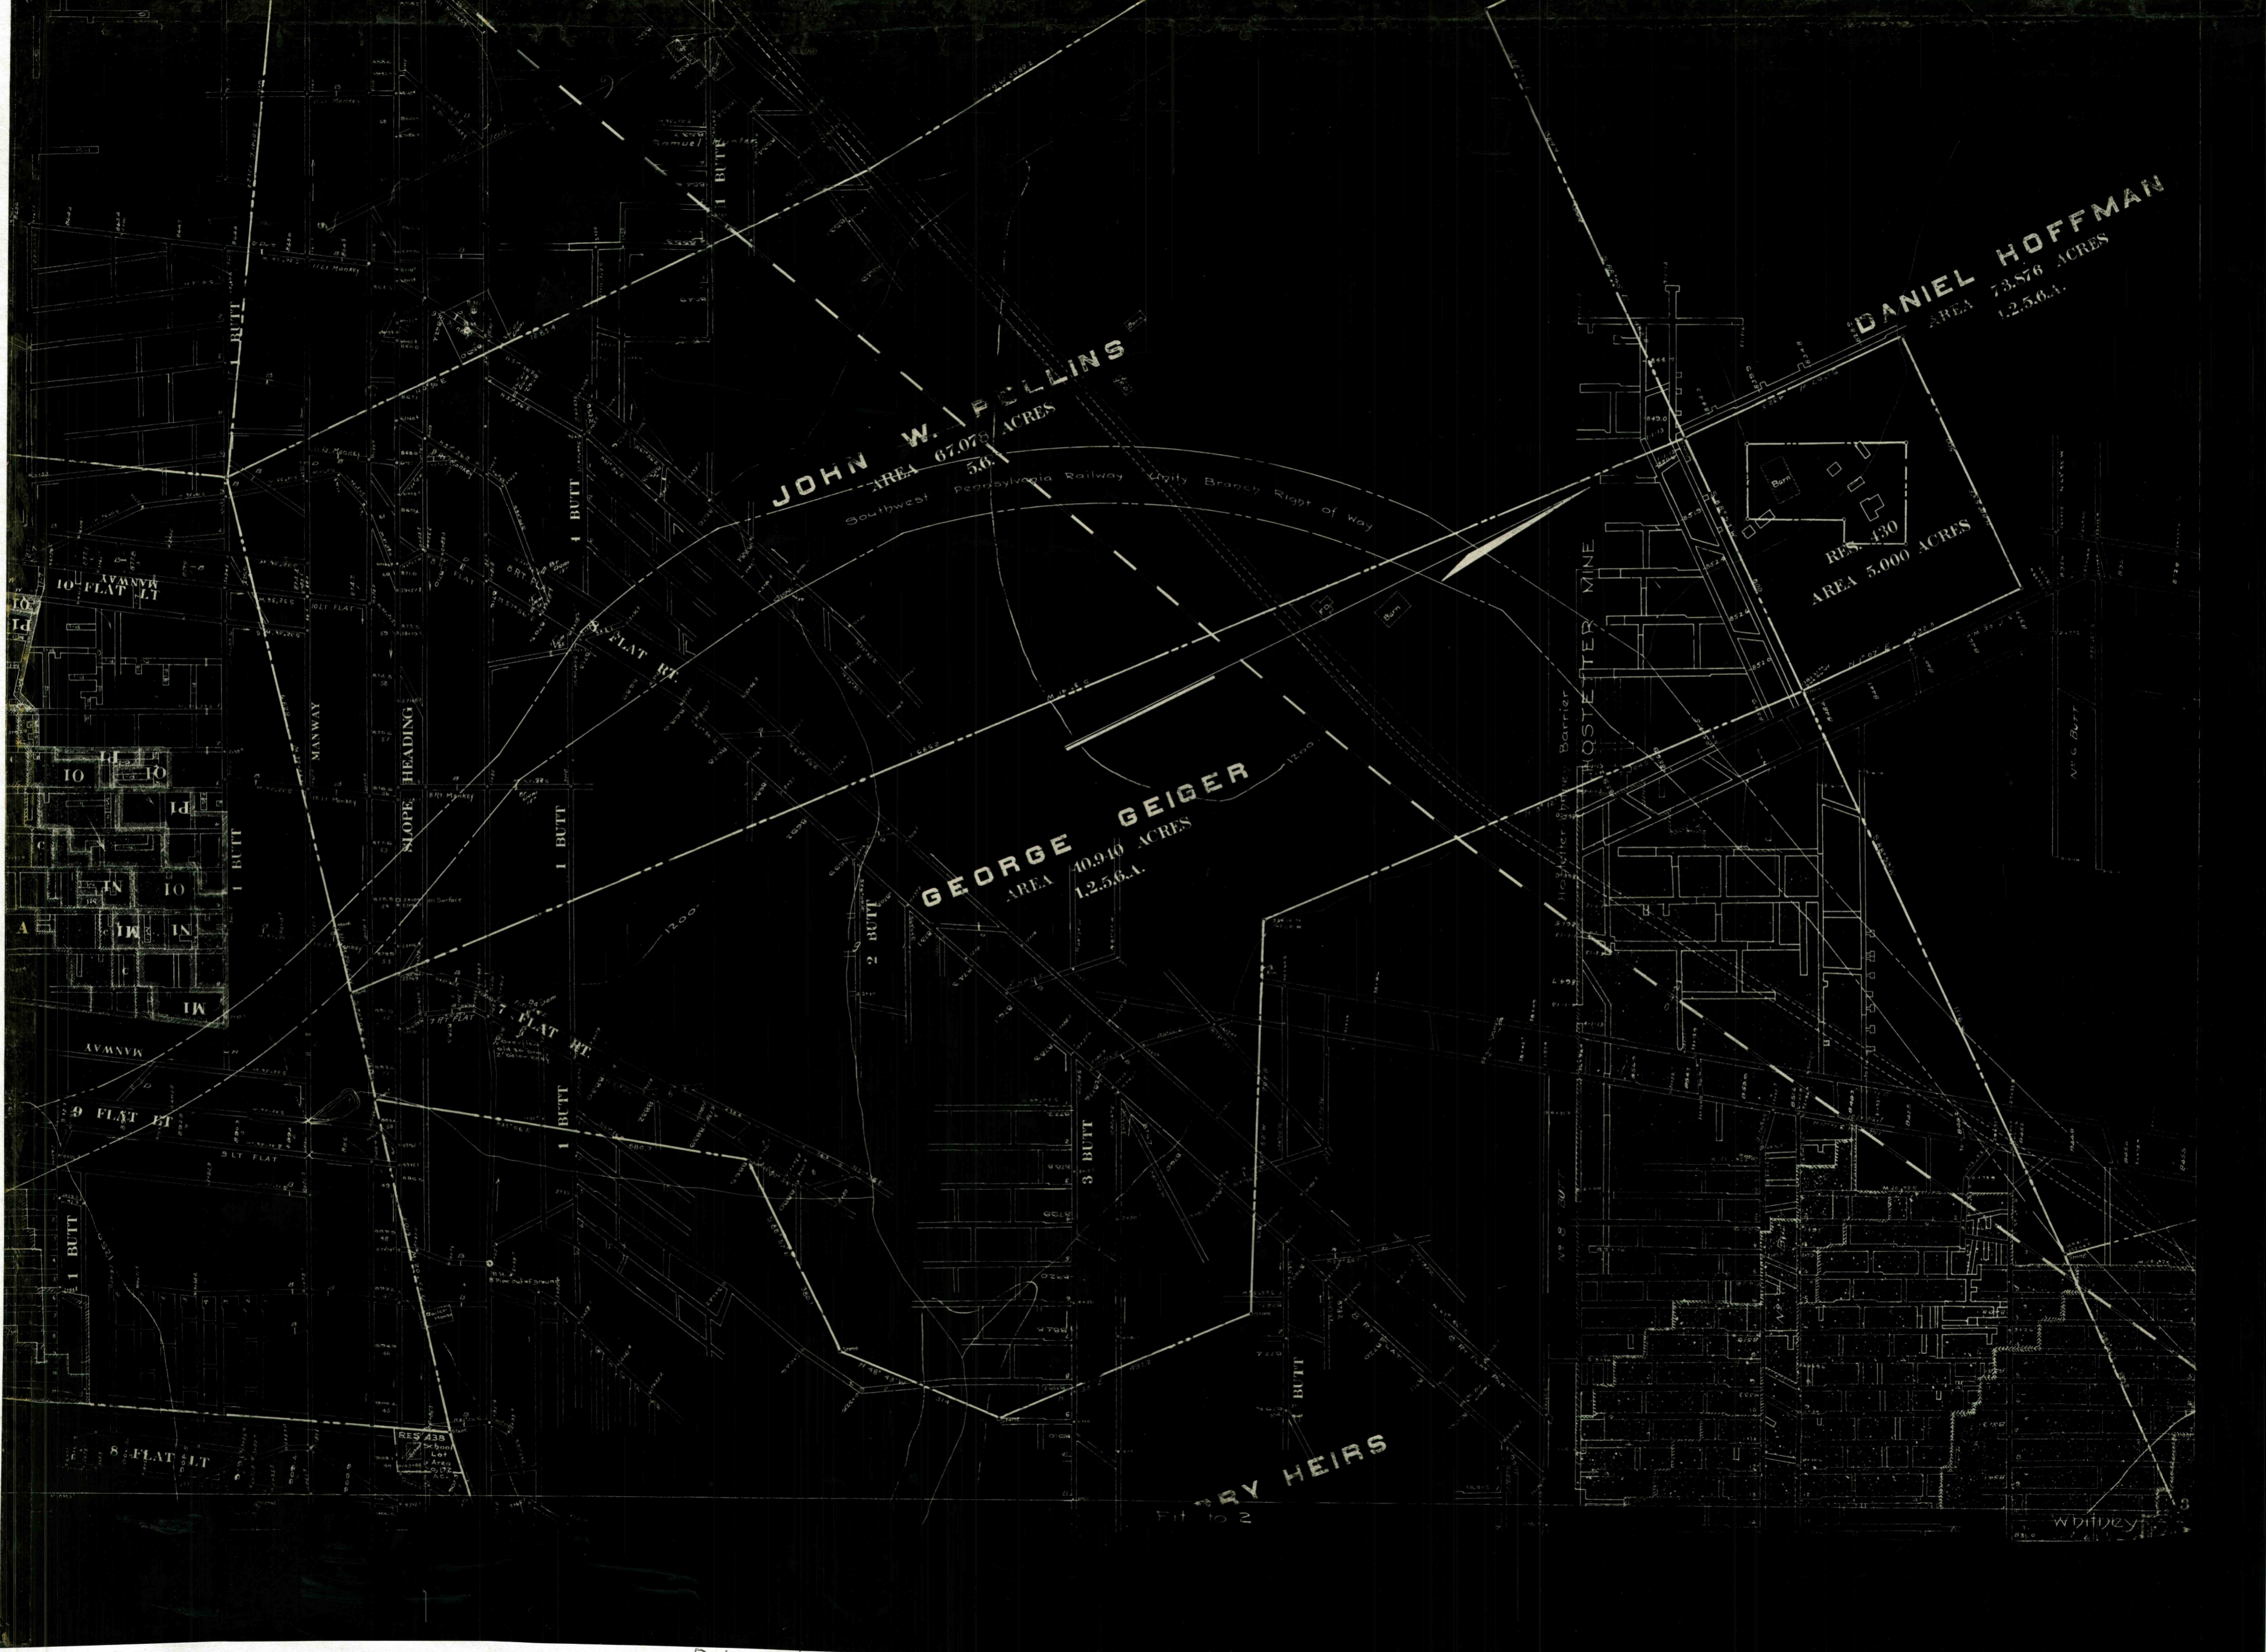

# 821 | 192

Whitely