


15-6

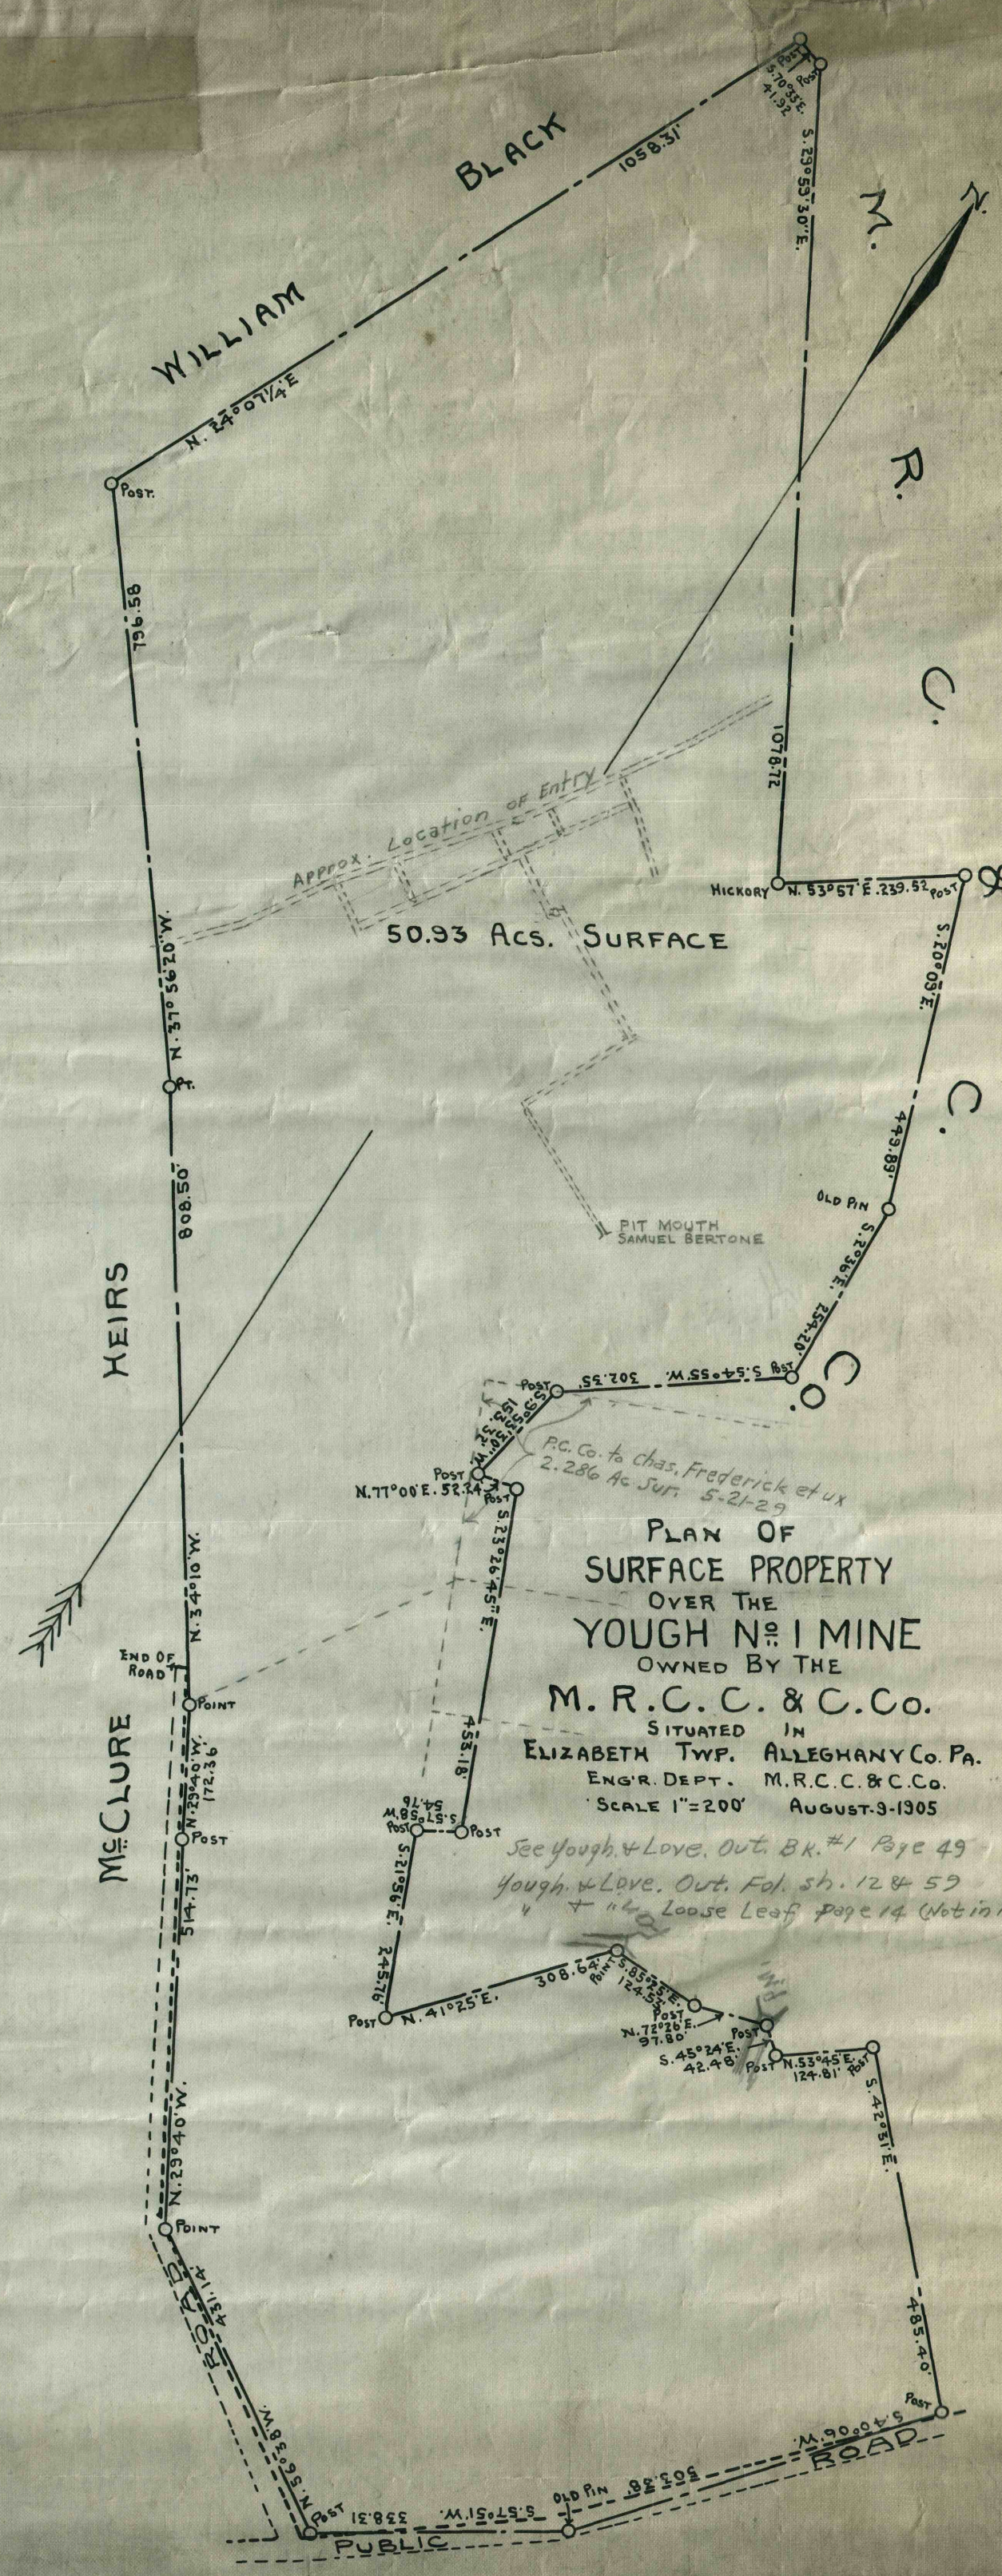

PLAN OF
SURFACE PROPERTY
OVER THE
YOUGH NO. 1 MINE
OWNED BY THE
M. R. C. C. & C. CO.

SITUATED IN
ELIZABETH TWP. ALLEGHANY CO. PA.
ENG'R. DEPT. M. R. C. C. & C. CO.
SCALE 1"=200' AUGUST 9-1905

See Yough. & Love. Out. BK. #1 Page 49
Yough. & Love. Out. Fol. sh. 12 & 59
+ "4" Loose Leaf Page 14 (Not in Folder)

